

1 0675
 SEQUENCE NO. (OWNER USE ONLY)
 DATE RECEIVED (OWNER USE ONLY) 11/28/73
 DATE WELL COMPLETED
 DEPTH OF WELL 275
 PERMIT NO. FROM "PERMIT TO DRILL WELL" MA-73-0529
 DRILLERS IDENTIFICATION NO. 209

OWNER **HOWARD INTER INC**
 LAST NAME FIRST NAME
 STREET OR RFD **13970 BRIGHTON DAM RD** POST OFFICE **20777**

WELL LOG
 STATE THE KIND OF FORMATIONS PENETRATED, THEIR COLOR, DEPTH, THICKNESS AND IF WATER BEARING

DESCRIPTION (USE ADDITIONAL SHEETS IF NECESSARY)	FEET		CHECK IF WATER BEARING
	FROM	TO	
Clay	0	35	
Mica			
Rock	35	275	X

REC 1 8 21-11-13
 HOLLOWAY, MARYLAND
 HOLLOWAY, MARYLAND

GROUTING RECORD
 WELL HAS BEEN GROUTED (CIRCLE APPROPRIATE BOX) YES NO
 TYPE OF GROUTING MATERIAL (CIRCLE BOX)
 CEMENT BENTONITE CLAY
 NO. OF BAGS 8 NO. OF POUNDS 720
 GALLONS OF WATER 80
 DEPTH OF GROUT SEAL (TO NEAREST FOOT)
 FROM 0 FT. TO 34 FT.
 (ENTER 0 IF FROM SURFACE)

CASING RECORD
 (INSERT APPROPRIATE CODE BELOW)
 STEEL CONCRETE
 PLASTIC OTHER
 MAIN CASING TYPE NOMINAL DIAMETER TOP (MAIN) CASING (NEAREST INCH) 6 TOTAL DEPTH OF MAIN CASING (NEAREST FOOT) 35

OTHER CASING (IF USED)
 DIAMETER (INCH) DEPTH (FEET)
 FROM TO

SCREEN RECORD
 (INSERT APPROPRIATE CODE BELOW)
 STEEL BRASS OPEN HOLE
 PLASTIC OTHER
 C 2 (SEQ. NO.)
 DEPTH (NEAREST WHOLE FOOT)
 FROM TO

PUMPING TEST
 HOURS PUMPED (TO NEAREST HOUR) 6
 PUMPING RATE (GALLONS PER MINUTE TO NEAREST GALLON) 1
 METHOD USED TO MEASURE PUMPING RATE: TRIAL
 WATER LEVEL (DISTANCE FROM LAND SURFACE)
 BEFORE PUMPING 40 (NEAREST FOOT)
 WHEN PUMPING 22 (NEAREST FOOT)


TYPE OF PUMPED USED (CIRCLE APPROPRIATE BOX) (FOR PUMPING TEST)
 AIR PISTON TURBINE
 CENTRIFUGAL ROTARY OTHER (DESCRIBE BELOW)
 JET SUBMERSIBLE

PUMP INSTALLED
 TYPE OF PUMP (WRITE APPROPRIATE LETTER IN BOX - SEE ABOVE) A, C, J, P, R, S, T, OI
 DRILLER WILL INSTALL PUMP (CIRCLE APPROPRIATE BOX) YES NO
 CAPACITY:
 GALLONS PER MINUTE (TO NEAREST GALLON) 31 35
 PUMP HORSE POWER 37 41
 PUMP COLUMN LENGTH (NEAREST FOOT) 43 47
CASING HEIGHT (CIRCLE APPROPRIATE BOX AND ENTER CASING HEIGHT)
 ABOVE LAND SURFACE (NEAREST FOOT) 2
 BELOW 49


LOCATION OF WELL ON LOT
 SHOW PERMANENT STRUCTURE SUCH AS BUILDINGS, SEPTIC TANKS, AND/OR OTHER LAND MARKS AND INDICATE NOT LESS THAN TWO DISTANCES (MEASUREMENTS TO WELL).

CIRCLE APPROPRIATE BOXES
 A WELL WAS ABANDONED AND SEALED WHEN THIS WELL WAS COMPLETED
 E ELECTRIC LOG OBTAINED
 P TEST WELL CONVERTED TO PRODUCTION WELL
 I HEREBY CERTIFY THAT I HAVE COMPLIED WITH ALL CONDITIONS STATED ON THE ABOVE-CAPTIONED "PERMIT TO DRILL WELL", AND THAT INFORMATION CONTAINED IN THIS REPORT IS TRUE, ACCURATE, AND COMPLETE TO THE BEST OF MY KNOWLEDGE, INFORMATION AND BELIEF.
 DRILLERS NAME
 (PLEASE PRINT) **HOWARD DILLON**
 SIGNATURE **Howard Dillon**

DIAMETER OF SCREEN 58 (NEAREST INCH)
 FROM TO
 GRAVEL PACK
 IF WELL DRILLED WAS A FLOWING WELL CIRCLE BOX
 DWR USE ONLY (NOT TO BE FILLED IN BY DRILLER) (E.P.O.S.)
 TELESCOPE CASING LOG INDICATOR OTHER DATA AVAILABLE

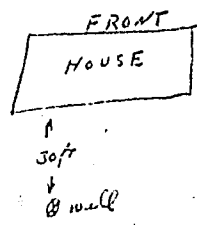

NOTE: This survey for title purposes only - not to be used for determining property lines. Property owner

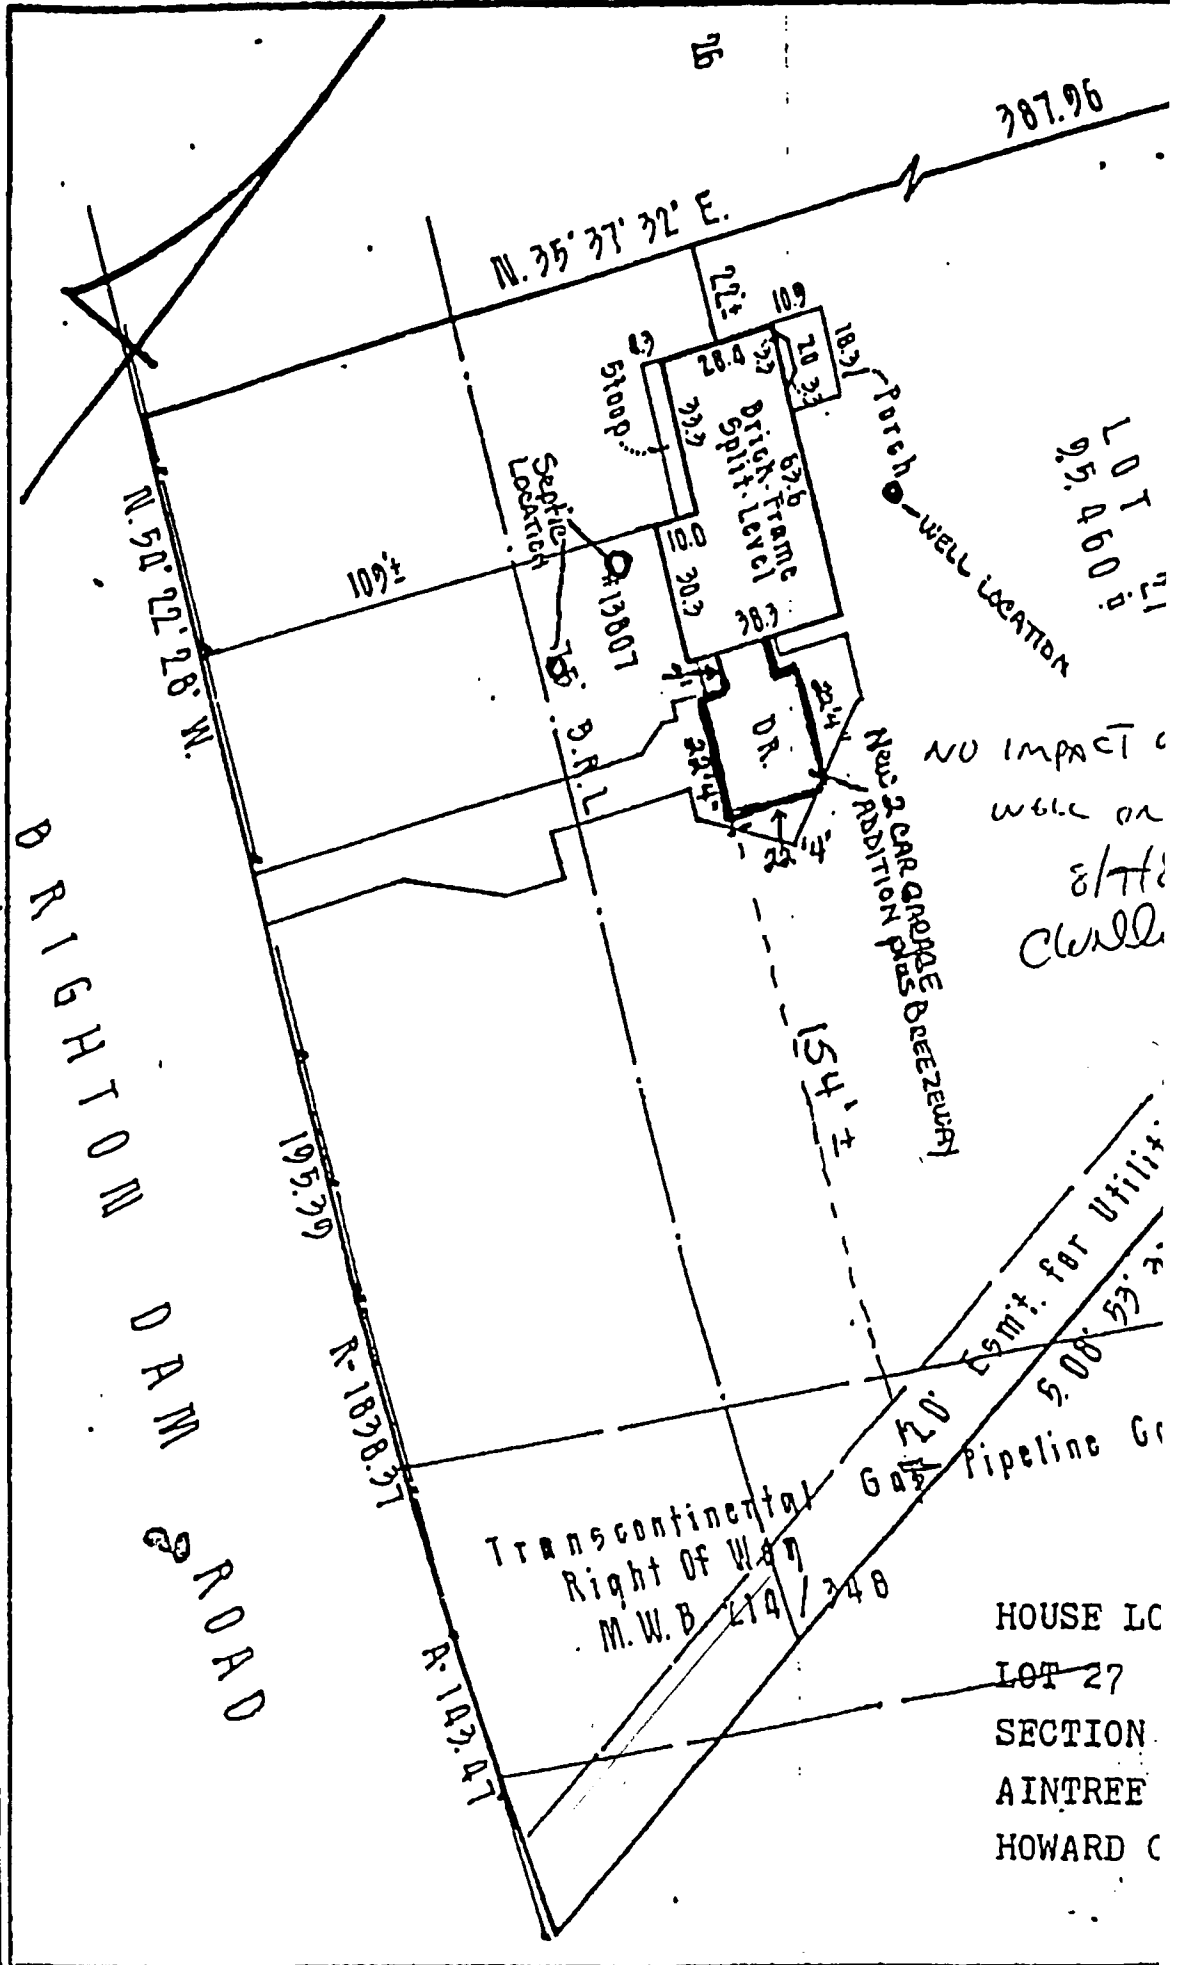

LOT 27
95,400 sq. ft.

NO IMPACT ON
WELL OR
8/11/11
Cwell

NEW 2 CAR GARAGE PLUS BREEZEWAY

Transcontinental
Right of Way
M.W.B. 214/248

HOUSE LC
LOT 27
SECTION
AINTREE
HOWARD C

BRIGHTON DAWD ROAD

N. 35° 37' 32" E.

N. 50° 21' 28" W.

R-1838.71

R-103.01

154' ±

Gas Pipeline Co
5.08' ±

15

387.96

212

60

20.4

237

20.303

383

324

378

4

378

4

Septic
Location

Dr 13007

S.R.L.

Dr.

Dr.

Porch - WELL LOCATION

NEW 2 CAR GARAGE PLUS BREEZEWAY

NO IMPACT ON
WELL OR
8/11/11
Cwell

Gas Pipeline Co
5.08' ±

HOUSE LC
LOT 27
SECTION
AINTREE
HOWARD C

Transcontinental
Right of Way
M.W.B. 214/248

N. 35° 37' 32" E.

N. 50° 21' 28" W.

R-1838.71

R-103.01

154' ±

Gas Pipeline Co
5.08' ±

15

387.96

212

60

20.4

237

20.303

383

324

378

4

378

4

Septic
Location

Dr 13007

S.R.L.

Dr.

Dr.

Porch - WELL LOCATION

NEW 2 CAR GARAGE PLUS BREEZEWAY

NO IMPACT ON
WELL OR
8/11/11
Cwell

Gas Pipeline Co
5.08' ±

HOUSE LC
LOT 27
SECTION
AINTREE
HOWARD C

Transcontinental
Right of Way
M.W.B. 214/248