

RECORDED

# APPLICATION

A 22400

SEWAGE DISPOSAL TESTING

P \_\_\_\_\_

STATE OF MARYLAND - DEPARTMENT OF HEALTH AND MENTAL HYGIENE

HOWARD COUNTY HEALTH DEPARTMENT  
ENVIRONMENTAL HEALTH SERVICES  
P. O. BOX 476, ELLICOTT CITY, MARYLAND 21043  
TELEPHONE: 463-3000, EXT. 336

DISTRICT 4th

DATE 10/27/75

TO: THE COUNTY HEALTH OFFICER  
ELLICOTT CITY, MARYLAND

I, HEREBY, APPLY FOR THE NECESSARY TEST IN ORDER TO CONSTRUCT (OR RECONSTRUCT) A SEWAGE DISPOSAL SYSTEM.

PROPERTY OWNER Richard Talley property

ADDRESS RFD #2, Daisy Rd. & Rte. 144, Woodbine, Md. PHONE 442-2300

PROPERTY LOCATION:

SUBDIVISION \_\_\_\_\_ LOT NO. 5

ROAD AND DESCRIPTION Busby Park Road

SIZE OF LOT 1.011 acres TYPE BLDG. 3 or 4 bedrooms

NUMBER OF BEDROOMS

IF NOT SINGLE RESIDENCE DESCRIBE \_\_\_\_\_

THE SYSTEM INSTALLED UNDER THIS APPLICATION IS ACCEPTABLE ONLY UNTIL PUBLIC FACILITIES BECOME AVAILABLE.

SIGNATURE OF APPLICANT /s/ Steve Costello

APPROVED BY \_\_\_\_\_ FOR \_\_\_\_\_ DATE \_\_\_\_\_

(KIND OF SYSTEM)


REJECTED BY \_\_\_\_\_ FOR \_\_\_\_\_ DATE \_\_\_\_\_

(KIND OF SYSTEM)

HOLD PENDING FURTHER TESTS \_\_\_\_\_ DATE \_\_\_\_\_

REASONS FOR REJECTION OR HOLDING \_\_\_\_\_

## THIS IS NOT A PERMIT

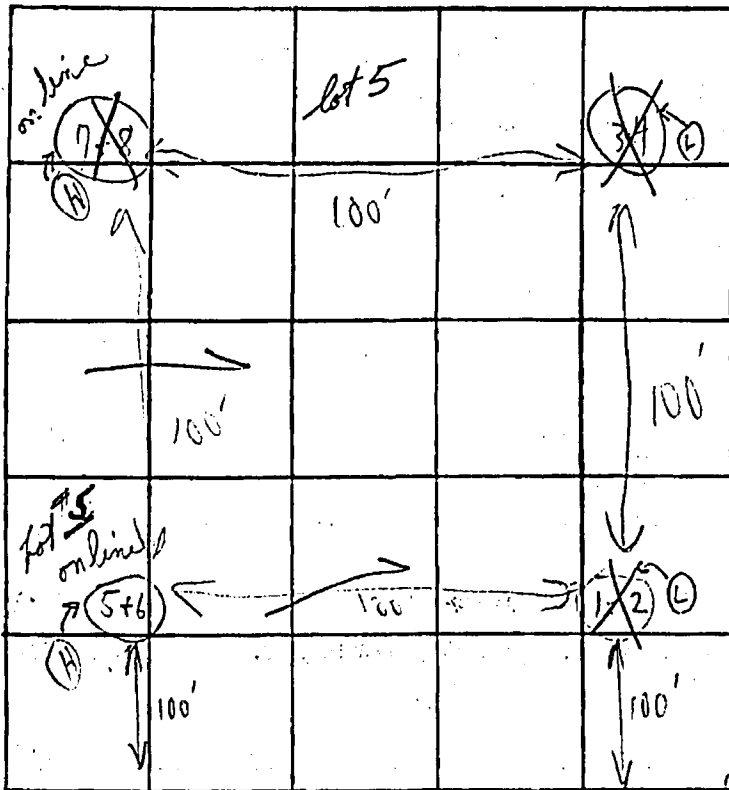

H.K. Turner  
10 011 acres

lot #4

INDICATE NORTH. - NAME ADJOINING ROADWAY AS BASE LINE.

Brush Park Rd

(Right of way for back lot)


DATE	TEST NO.	DEPTH	PRE-WET		TEST - 1" DROP		TIME
			START	STOP	START	STOP	
10/15/75	1	6'	10:05		No perc	clay	10:35
	2	13'	10:05	10:14	10:14	10:30	16m
	3	6'	10:24	10:24	10:24	10:30	4m
	4	13'	10:24	10:26	10:26	10:30	4m
	5						
	6	10'					
	7			7'	Hard soil - see digger		
	8						
(10/30 see next page)							
(See lot #4 Test result to back of lot 4 & 5)							

REMARKS "Open field" (Hold down supervisor!!) Test Depth 13'

TYPE OF SOIL (Sandy loam below clay)

TESTED BY C. B. D. ALSO PRESENT: Costello & men

4/6/76  
Also extended lot plot!!  
appears ok  
Hoes for  
row

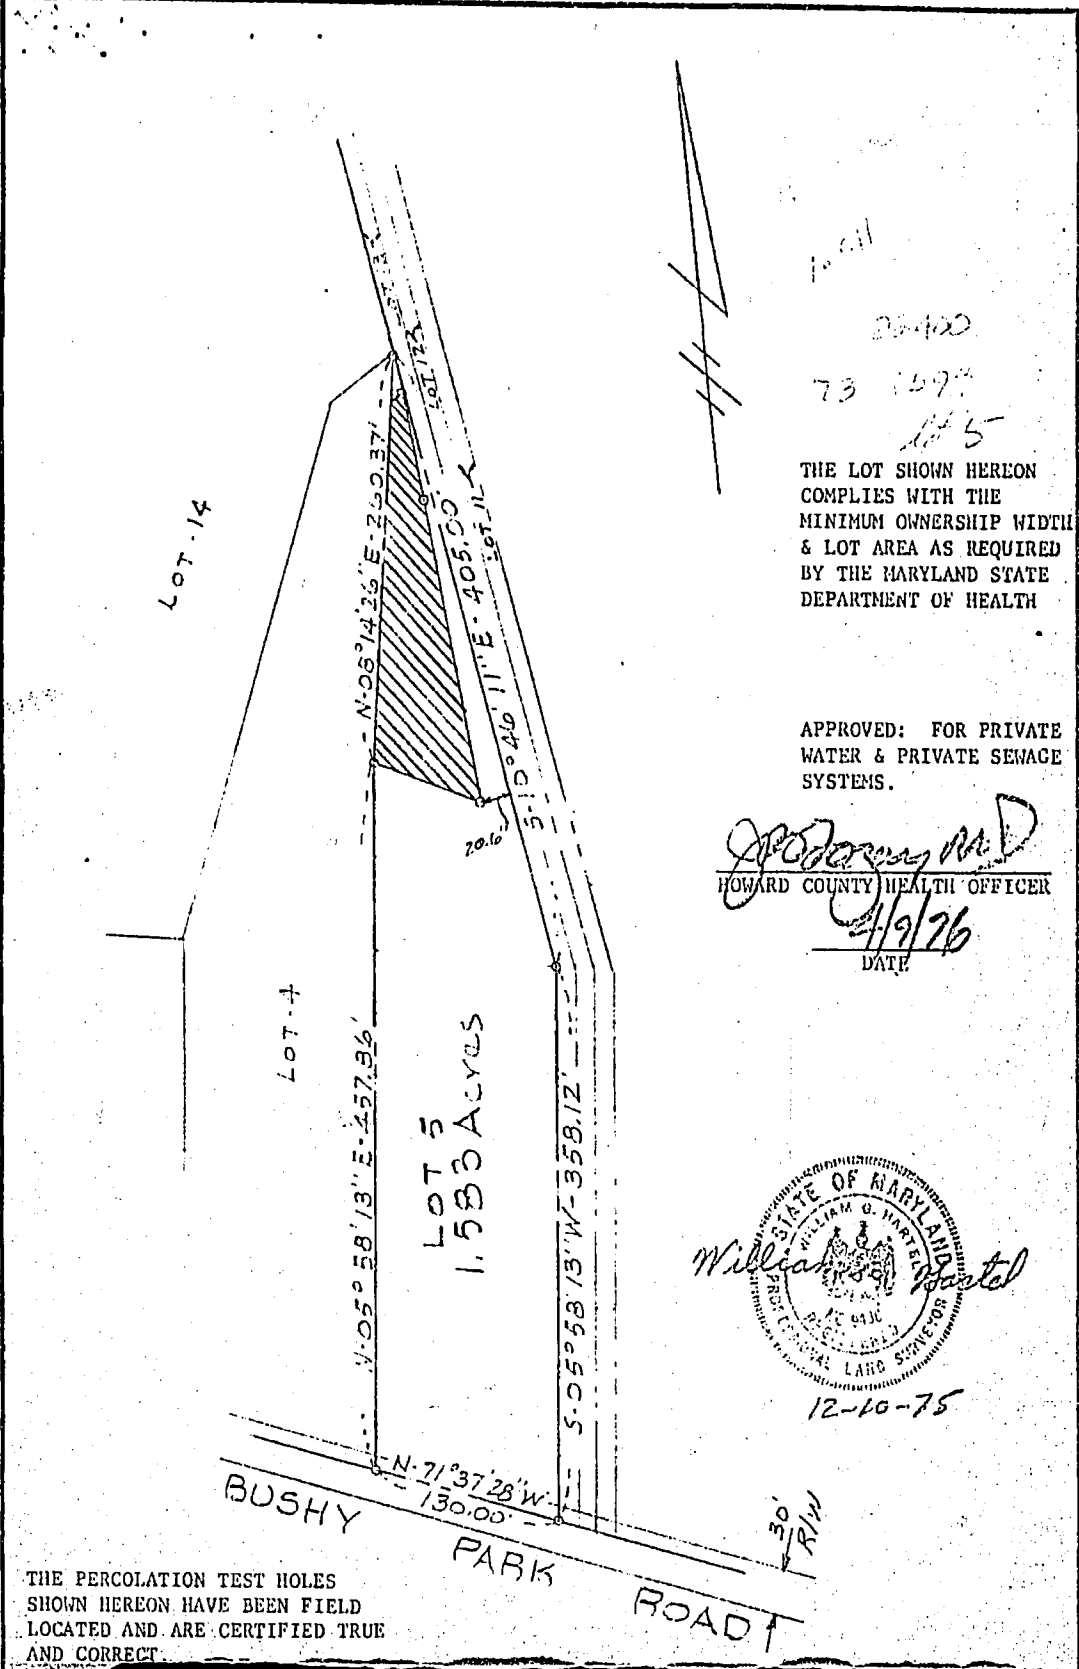

73 1497  
 105

THE LOT SHOWN HEREON  
 COMPLIES WITH THE  
 MINIMUM OWNERSHIP WIDTH  
 & LOT AREA AS REQUIRED  
 BY THE MARYLAND STATE  
 DEPARTMENT OF HEALTH

APPROVED: FOR PRIVATE  
 WATER & PRIVATE SEWAGE  
 SYSTEMS.

*Howard County Health Officer*  
 HOWARD COUNTY HEALTH OFFICER  
 4/9/76  
 DATE

STATE OF MARYLAND  
 WILLIAM G. HARPEL  
 REGISTERED PROFESSIONAL LAND SURVEYOR  
 No. 8430  
 12-10-75

THE PERCOLATION TEST HOLES  
 SHOWN HEREON HAVE BEEN FIELD  
 LOCATED AND ARE CERTIFIED TRUE  
 AND CORRECT.