

Record Detail * (This section is required.)

Permit Type Building/Residential/Garage/Attached Permit Number B23004131 Opened Date 10/12/2023
 Description of Work SFD/ Build one story attached garage 27' x 24'-4". Build 8'x22'2" screened porch on rear of house, with 22'2"x14' deck with steps to grade, 1 STORY, Slab on Grade, 1R, 0FB, 0HB, 0FP, OTHER STRUCTURE = None, 0BR, PORCH/DECK = Open and Screen Porch, ENERGY METHOD = N/A,

[check spelling](#)

Online BP assigned to specialist with property history. g 10/18/23

Address * (This section is required.)

Search Reset Clear Get Parcel & Owner
 Street # 10524 Street Name PUDDING Street Type LN
 Unit Type -Select-- Unit # X Coordinate -76.88239 Y Coordinate 39.25447
 City ELLICOTT CITY State MD Zip Code 21042 Primary Yes

Parcel * (This section is required.)

Search Reset Clear Get Address & Owner
 GIS ID * 11061243 Parcel 0148 Parcel Area 0 Land Value 0 Improved Value 0 Exemption Value 0 Plan Area RURAL
 Legal Description

[check spelling](#)

Block 24 Lot 20 Census Tract 602303 Council Dist 5 Inspection Dist Supervisor Dist Map # DAP Zone
 Plan Area State Tax Id Subdivision Name Kings Forest
 Section Area Tax Map 23
 Grid 23-24 Zoning District RC-DEO ADC Map 4814-J10
 SDP No. Final Plan No. ECP-14-046 WP File No.
 Record Plat No. 25764-2576 WS Contract No. FDP No. Primary Yes
 Owner Occupied Year Built Historic District Yes No
 Historic District Registry No. Stat Area 2-08B Flood Plain Yes No
 Building No

Owner (This section is not required.)

Search Reset Clear
 Name * Rajesh Nayak
 Address Line 1 10524 Pudding Lane
 Address Line 2
 Address Line 3
 Mail City Ellicott City Mail State MD Mail Zip Code 21042
 Phone 410-984-5813 Primary Yes
 E-mail
 Cell Number Fax Number

[check spelling](#)

Other Structure * None	Bedrooms * 0	Porch Deck * Open and Screen Porch	No of Fireplaces * 0	Type of Fireplace --Select--	Energy Code * N/A		
W & S Fees Paid <input type="radio"/> Yes <input type="radio"/> No	Water * Private	Sewage * Private	Utilities * Electric	Heating System * Electric	Sprinkler System * None	Road Frontage --Select--	
1st Floor Width FT	1st Floor Depth FT	2nd Floor Width FT	2nd Floor Depth FT	Basement Width FT	Basement Depth FT	Height FT	Building Construction Type --Select--
Total Square Footage * 648	Occupiable Square Footage * SQFT 0	Affordable Housing Funding * SQFT N/A	Foundation Measurement FT	Footings	MIHU Outside Downtown Columbia <input type="radio"/> Yes <input type="radio"/> No	MIHU Provided Units	Affordable Downtown Columbia <input type="radio"/> Yes <input type="radio"/> No
Walls	Roof	Change In Use <input type="radio"/> Yes <input checked="" type="radio"/> No	Grading Permit No	Senior Housing <input type="radio"/> Yes <input type="radio"/> No	MIHU Required Units	Plan Submittal * Electronically by Invitation from ProjectDox	
Additional Description Info					Expiration Date 4/14/2024		

[check spelling](#)

GREEN INFORMATION

Goal Level --Select--	Actual Level --Select--	Leed Registration Number	Date of Leed Certification [a]
--------------------------	----------------------------	--------------------------	-----------------------------------

STORM WATER MANAGEMENT

Green Roofs A1 <input type="radio"/> Yes <input type="radio"/> No	Permeable Pavements A2 <input type="radio"/> Yes <input type="radio"/> No	Reinforced Turf A3 <input type="radio"/> Yes <input type="radio"/> No	Disconnection of Rooftop Runoff N1	Disconnection of Non Rooftop Runoff N2 <input type="radio"/> Yes <input type="radio"/> No
Sheetflow to Conservation Areas N3 <input type="radio"/> Yes <input type="radio"/> No	Rainwater Harvesting M1	Submerged Gravel Wetlands M2	Landscape Infiltration M3	Infiltration Berms M4
Dry Wells M5	Micro Bioretention M6	Rain Gardens M7	Swales M8	Enhanced Filters M9

PSWM Certification Received in CID on
[a]

Submit Cancel

APPROVED SEPTIC SYSTEM PLAN
HOWARD COUNTY HEALTH DEPARTMENT

Approved Septic System Plan
Howard County Health Department


LOT 20
(48,310 SQ. FT.)

DBernard
10-10-23

Signature
DBernard

PROPOSED DECK WITH
STEPS 22'-2" X 14'

PROPOSED SCREENED
PORCH 22'-2" X 8'

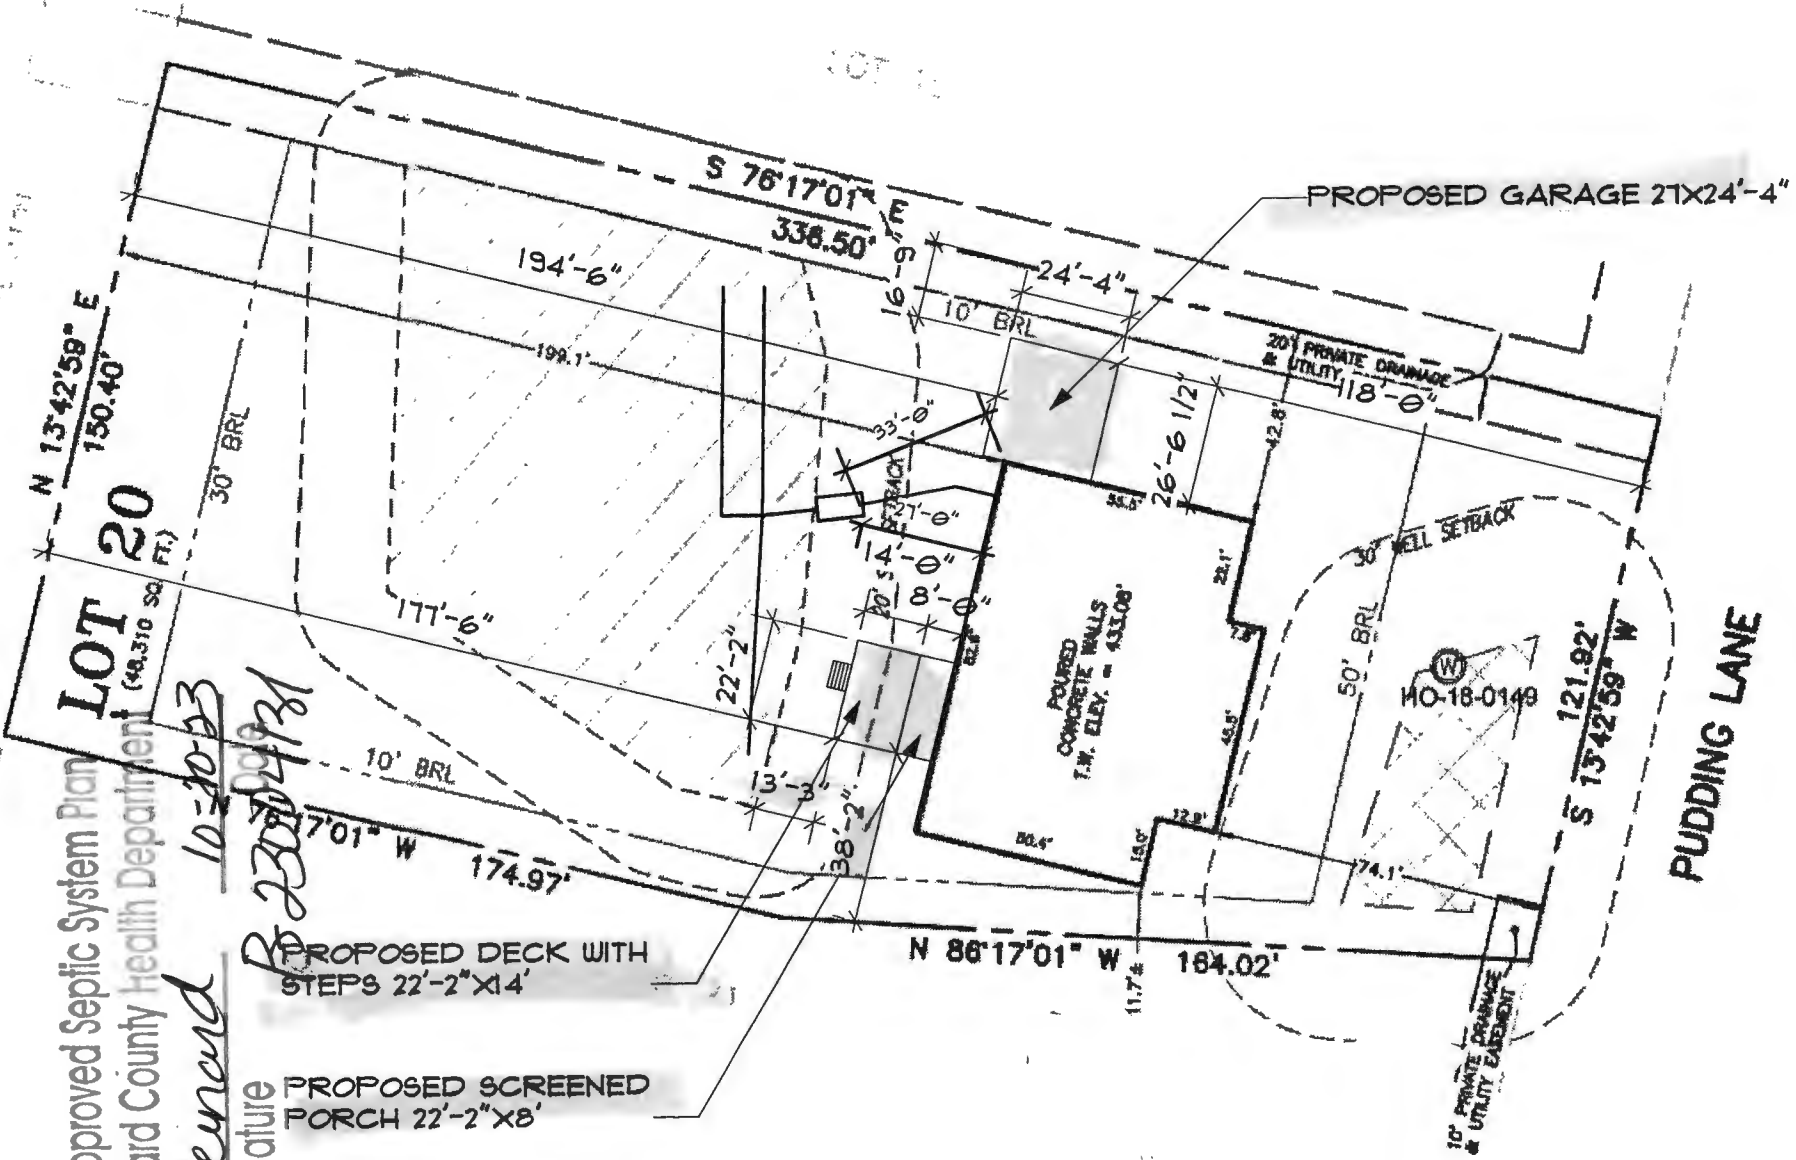

PUDDING LANE