

Record Detail * (This section is required.)

Permit Type Building/Residential/Misc/Tanks Permit Number B23001995 Opened Date 06/07/2023

Description of Work SFD/Install (1) 500 gallon underground propane tank

[check spelling](#)

Address * (This section is required.)

Search Reset Clear Get Parcel & Owner

Street # 12913 Street Name BYEFIELD Street Type RD
 Unit Type --Select-- Unit # X Coordinate -76.96186 Y Coordinate 39.17669
 City HIGHLAND State MD Zip Code 20777 Primary Yes

Parcel * (This section is required.)

Search Reset Clear Get Address & Owner

GIS ID * 850255 Parcel 278 Parcel Area 1.06 Land Value 220600 Improved Value 512100 Exemption Value 291500 Plan Area RURAL

Legal Description IMPSLOT 17[]12913 BYEFIELD RD[]HIGHLAND

[check spelling](#)

Block 17 Lot 17 Census Tract 605101 Council Dist 5 Inspection Dist Supervisor Dist Map # DAP Zone
 Plan Area State Tax Id 1405355567 Subdivision Name
 Section Area Tax Map 40
 Grid Zoning District RR-DEO ADC Map 5051-G2
 SDP No. Final Plan No. WP File No.
 Record Plat No. WS Contract No. FDP No. Primary Yes
 Owner Occupied Year Built 1972 Historic District No
 Historic District Registry No. Stat Area 5-04A Flood Plain No
 Building No

Owner * (This section is required.)

Search Reset Clear

Name * LIEBERMAN BRYAN
 Address Line 1 12913 BYEFIELD DR

Nov 2016
 B16005003
 replacement of
 500 lp tank

6/12/23
 spoke to Home Owner
 this was a rented lp tank → replaced w/ new and will charge location to accommodate future addition. (AM)

6/12/23 - Approved for lp tank B23001995

Address Line 2

Address Line 3

Mail City HIGHLAND	Mail State MD	Mail Zip Code 20777
Phone 301-717-4612	Primary Yes	
E-mail		
Cell Number	Fax Number	

Professionals (This section is not required.)

License # * 20100079809	Business Name MID ATLANTIC COOPERATIVE SOLUTIONS DBA AERO ENERGY		
License Type * Propane Gs	First Name RICHARD	Middle Name THOMAS	Last Name JARCY
Primary Yes	Address Line 1 230 LINCOLN WAY EAST		
	Address Line 2		
	City NEW OXFORD	State PA	ZIP Code 17350-0000
	Phone 1 2406744592	Phone 2	Fax
	E-mail RJARCY@AEROENERGY.COM		

Applicant (This section is not required.)

Search	As Owner	As Lic. Prof	As Contact
Type * Applicant	First Name steve	MI	Last Name dannfeldt
Relationship Applicant	Full Name steve dannfeldt		
Primary Yes	Organization Name Aero Energy		
	Street Address 230 lincoln way East		
	Address Line 2		
	City New Oxford	State PA	Zip Code 17350
	Phone 717-577-5923	Cell	Fax
	E-mail * dfrazier@aeroenergy.com		

Addtl Info

Est Construction Cost * 6600	Housing Units * 0	Number of Buildings * 0	Public Owned No
Construction Type 329 - Structures Other Than Buildings (Retaining Walls/Tents)			

TANK INFORMATION


RESIDENTIAL TANK INFORMATION

Capital Project-No Fee * <input type="radio"/> Yes <input checked="" type="radio"/> No	Capital Project Number []	Fee Exempt * <input type="radio"/> Yes <input checked="" type="radio"/> No	Roadside Tree Project Permit * <input type="radio"/> Yes <input checked="" type="radio"/> No	Roadside Tree Permit # []
Existing Use * SFD	Number of Tanks Installed * 1	Number of Tanks Removed * 1		
Water Supply	Sewage Disposal	Expiration Date	Relocate Existing Tank *	

Approved for
 LP tank
 B23001995
 APF 6/12/23

12913 BYEFIELD DRIVE
 HIGHLAND, MARYLAND
 LOT 17
 FINAL PLAT "HEMLOCK HILL"
 PLAT NO. 2330
 HOWARD COUNTY,
 MARYLAND

WOOD
 SHED

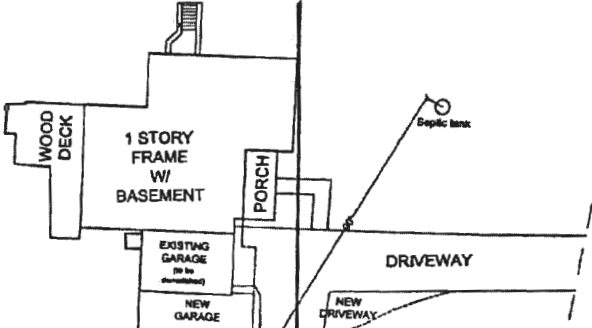

300FT

110FT

BYEFIELD DRIVE
 (50' ROW)

15FT

65FT

**ALTERNATE PROPANE TANK
 LOCATION PLAN**

SCALE: 3/16"=1'-0"



PROJECT NAME: HOME REMODEL		
DRAWING TITLE: ALTERNATE PROPANE TANK LOCAT C		
ADDRESS: Bryant and Corina Lockwood 12913 Byefield Dr. Highland, MD	DESIGNED BY: VENTA NORRIS	
DATE: 4/24/23	SCALE: 3/16"=1'-0"	DATE: S3