

Name: Jason Shadid
Street Address: 5925 Northern Court
City, State, Zip: Elkridge, MD 21075
Date: August 3, 2023

Amendment, Permit # B22002733

Ms. Debbie Whalen
Division of Plan Review
Department of Inspections, Licenses and Permits
Howard County Government
3430 Court House Drive
Ellicott City, MD 21043

Health

Dear Ms. Whalen:

I am requesting to amend Permit # B22002733 at
remove the Media Room as part of the approved permit for the project at 16467 Frederick to
Road, Woodbine, MD 21797 - the area is approx. 26' x 14' (384 sq. feet)

Converting room from Media Room to Unfinished Storage.

Enclosed:

- Fee: 5000
- Plot Plans
- Sets of Construction Drawings
- Other: drawing showing removal of media room from approved permit


If there is anything we can do to assist you, please let me know.

Sincerely,
Jason Shadid

Name: Jason Shadid
Title: Owner-16467 Frederick Road, Woodbine
Phone: 410-493-1782
Email: jjshadid@gmail.com

RECEIVED
AUG 04 2023
LICENSES & PERMITS
DIVISION

FOUNDATION / LOWER LEVEL

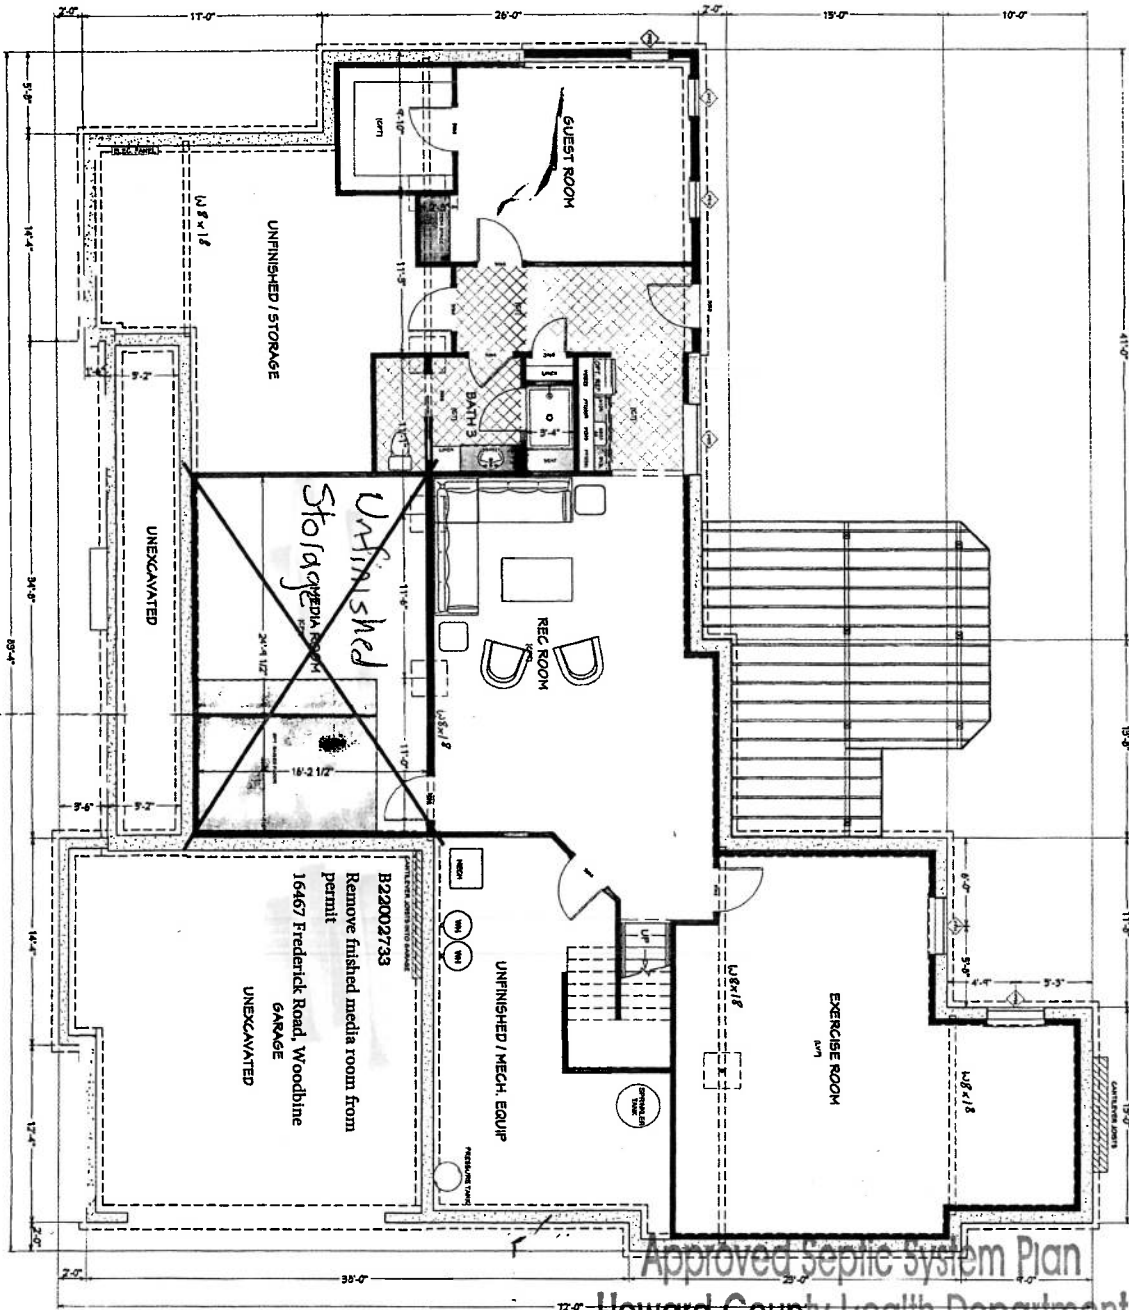

Approved Septic System Plan
 Howard County Health Department
Deborah
 Signature 8-22-23
Date

<p>3 OF 5</p>	<p>SHEET#</p>	<p>LANCASTER ARCHITECTURE 1300 OLD NATIONAL PIKE SUITE 200 WASHINGTON, DC 20004 (202) 462-1100</p>	<p>FOUNDATION PLAN</p>	<p>PROPOSED HOUSE PLAN SHADID RESIDENCE 16467 Frederick Road, Woodbine, MD 21797</p>
<p>Approved by: Mark K. Linnell MCM 12/01/2023</p>		<p>LAYOUT FILE: Shadid PLOT DATE: Thursday, July 7, 2023</p>		
<p>NO. DATE</p> <p>REV: 1/13/2023</p> <p>REV: 1/17/2023</p> <p>REV: 2/14/2023</p> <p>REV: 3/21/2023</p> <p>REV: 3/17/2023</p> <p>REV: 4/20/2023</p>				