


NOTE: EX. F.F. ELEV. 101.6

25' EASEMENT FOR INGRESS AND EGRESS

LOT 4D
"HERITAGE WOODS"
5TH ELECTION DISTRICT
HOWARD COUNTY, MD.

New 320 S.F.
Res + Screen
Porch

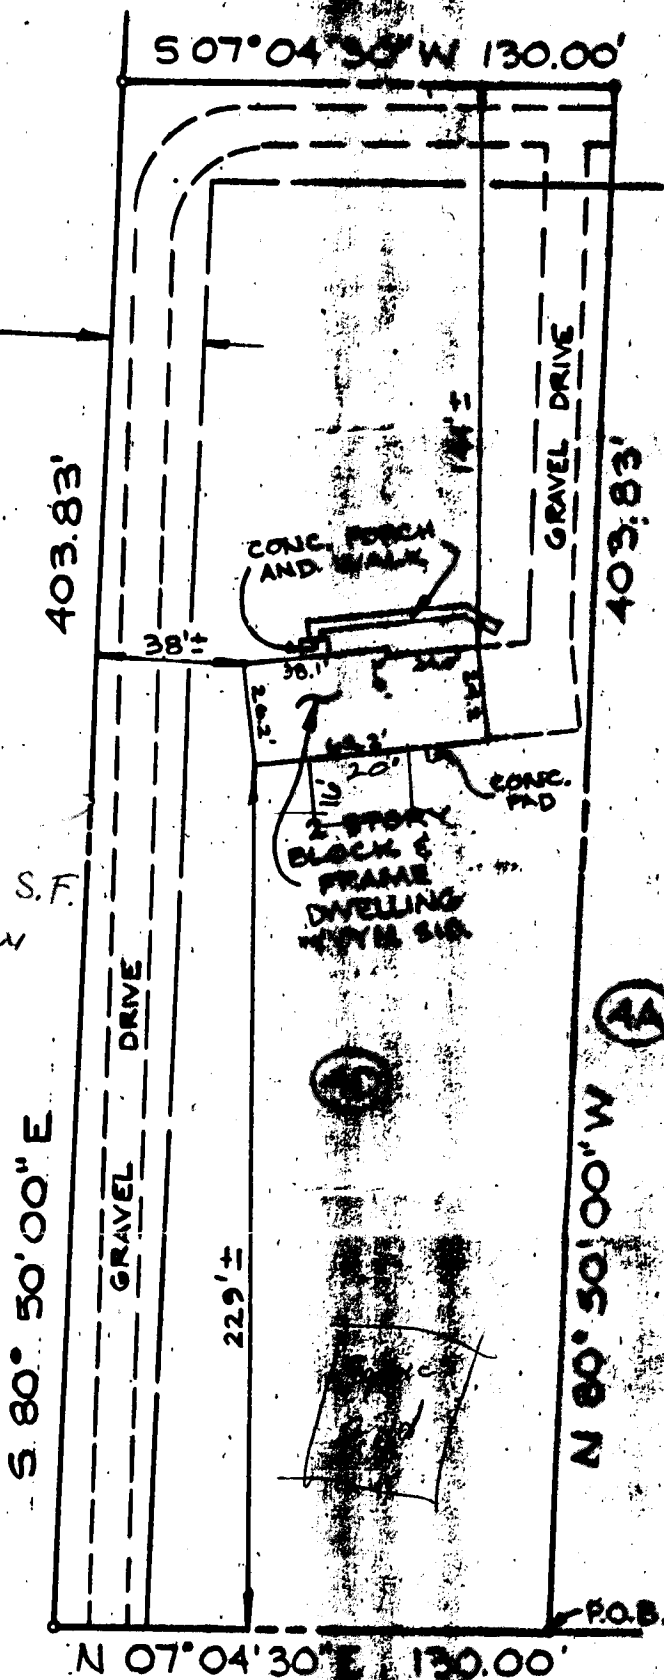

BROWN'S BRIDGE ROAD

I hereby certify that I have made a survey of this lot for the purpose of locating the improvements thereon and that they are located as shown.

This plat is not intended for use in establishing property lines.

10/25/90

OK To Sign Permit
RH

8/19/87 DATE Walter H. Witzler WALTER H. WITZLER, REG. NO. P.L.S. 79



LOCATION SURVEY
BROWN'S BRIDGE ROAD

scale:
1" = 50'

McKEE & ASSOCIATES, INC.

date:
7-30-87

CIVIL ENGINEERS • LAND SURVEYORS
5 SHAWAN ROAD HUNT VALLEY, MD 21080
252-8820

job no:
CG-218

drawn by
ABD checked by
HMD