

PERMIT NUMBER: B 22002928

DATE ACCEPTED:



### RESIDENTIAL BUILDING PERMIT APPLICATION

HOWARD COUNTY DEPARTMENT OF INSPECTIONS, LICENSES, AND PERMITS

3430 COURT HOUSE DRIVE, ELLICOTT CITY, MD 21043 - PHONE: (410) 313-2455 OPTION #4

www.howardcountymd.gov

#### BUILDING SITE ADDRESS REQUIRED

Street Address: 17314 Pink Dogwood CT		Unit:
City: Mt Airy	State: MD	Zip Code: 21771
Subdivision/Village/Complex Name:		SDP/WP/BA #:
Lot:	Tax Map:	Parcel:
		Grading Permit #:

#### DESCRIPTION OF WORK REQUIRED

Existing Use: SFD	Proposed Use: SFD	Estimated Cost: \$ 4500
Trade Work to Be Completed (Separate Permits Required): <input type="checkbox"/> Mechanical (HVACR) <input type="checkbox"/> Electrical <input type="checkbox"/> Plumbing <input type="checkbox"/> None		
Contract for 12x20 shed for storage		

#### PROPERTY OWNER INFORMATION REQUIRED

Owner(s) Name(s) (As it appears on tax records): William Jacob Dieter JA	Primary Residence: <input type="checkbox"/> Yes <input checked="" type="checkbox"/> No
Owner's Street Address: 17314 Pink Dogwood CT	
City: Mt Airy	State: MD
Phone: 410-605-7693	Email: wdieter4@aol.com
	Zip Code: 21771

#### APPLICANT NAME REQUIRED - INDIVIDUAL WHO SIGNS THIS APPLICATION

Business Name:	Contact Name: Bill
Street Address: 17314 Pink Dogwood CT	
City: Mt Airy	State: MD
Phone: 410-605-7693	Email:
	Zip Code: 21771

#### CONTRACTOR INFORMATION REQUIRED

Business Name: Home Services	License #:
Licensee's Name:	
Street Address:	
City:	State:
Phone:	Email:
	Zip Code:

#### ARCHITECT/ENGINEER INFORMATION INDIVIDUAL WHO SIGNED PLANS, IF APPLICABLE

Business Name:	Name:
Street Address:	
City:	State:
Phone:	Email:
	Zip Code:

#### BUILDING CHARACTERISTICS REQUIRED

Primary Structure: <input type="checkbox"/> SF Dwelling <input type="checkbox"/> SF Townhouse <input type="checkbox"/> SF Duplex <input type="checkbox"/> Mobile Home <input type="checkbox"/> Multi-Family Dwelling (MF*)	Condo: <input type="checkbox"/> Yes <input checked="" type="checkbox"/> No
Utilities: <input type="checkbox"/> Electric <input type="checkbox"/> Gas	Water Supply: <input type="checkbox"/> Public <input type="checkbox"/> Private (Well)
Sewage Disposal: <input type="checkbox"/> Public <input checked="" type="checkbox"/> Private (Septic)	
Heating System: <input checked="" type="checkbox"/> Electric <input type="checkbox"/> Natural Gas <input type="checkbox"/> Propane <input type="checkbox"/> Other:	Roadside Tree Project: <input type="checkbox"/> No <input type="checkbox"/> Yes: #
Sprinkler System: <input type="checkbox"/> NFPA 13 <input type="checkbox"/> NFPA 13R <input type="checkbox"/> NFPA 13D <input checked="" type="checkbox"/> None	Fire Alarm System: <input type="checkbox"/> Yes <input checked="" type="checkbox"/> No <input type="checkbox"/> Voice Evac

#### ADDITIONAL RESIDENTIAL INFORMATION (PLEASE SELECT/COMPLETE ALL THAT APPLY)

Model Name & Options:				
# of Bedrooms (SF):	# of efficiency units (MF*):	# of 1 BR (MF*):	# of 2 BR (MF*):	# of 3 BR (MF*):
# Rooms:	# Full Baths:	# Half Baths:	# Fireplaces:	
Garage/Carport Info: <input type="checkbox"/> Attached Garage <input type="checkbox"/> Detached Garage <input type="checkbox"/> Integral Garage <input type="checkbox"/> Carport <input type="checkbox"/> None				
Basement/Foundation Info: <input type="checkbox"/> Slab on Grade <input type="checkbox"/> Post & Pier <input type="checkbox"/> Unfinished Basement <input type="checkbox"/> Finished Basement: <input type="checkbox"/> Full or <input type="checkbox"/> Partial				
1st Fl Width:	1st Fl Depth:	2nd Fl Width:	2nd Fl Depth:	Bsmt Width:
				Bsmt Depth:
Energy Method: <input type="checkbox"/> Prescriptive <input type="checkbox"/> Performance <input type="checkbox"/> UA Alternative <input type="checkbox"/> ERI		Gross Area:	sq ft	Occupiable Area:
				sq ft

#### AGREEMENT/ DISCALIMER REQUIRED

THE UNDERSIGNED HEREBY CERTIFIES AND AGREES AS FOLLOWS: (1) THAT HE/SHE IS AUTHORIZED TO MAKE THIS APPLICATION; (2) THAT THE INFORMATION IS CORRECT; (3) THAT HE/SHE WILL COMPLY WITH ALL REGULATIONS OF HOWARD COUNTY WHICH ARE APPLICABLE THERETO; (4) THAT HE/SHE WILL PERFORM NO WORK ON THE ABOVE REFERENCED PROPERTY NOT SPECIFICALLY DESCRIBED IN THIS APPLICATION; (5) THAT HE/SHE GRANTS COUNTY OFFICIALS THE RIGHT TO ENTER ONTO THIS PROPERTY FOR THE PURPOSE OF INSPECTING THE WORK PERMITTED AND POSTING NOTICES.

APPLICANT'S ORIGINAL SIGNATURE: William Jacob Dieter DATE SIGNED: 7-27-22

#### FOR OFFICE USE ONLY

CHECKS PAYABLE TO: DIRECTOR OF FINANCE OF HOWARD COUNTY


AGENCIES REQUIRED/APPROVALS:				
<input checked="" type="checkbox"/> PR	<input type="checkbox"/> DPZ	<input checked="" type="checkbox"/> DED	<input checked="" type="checkbox"/> Health 8/4/22	<input type="checkbox"/> SHA
<input type="checkbox"/> CID	SUBMITTAL FEES: 55		PAYMENT:	ACCEPTED BY: <u>hul</u>



MILLENNIUM ENGINEERING, LLC  
 PARK PLACE PROFESSIONAL CENTER  
 5825 ALLENTOWN ROAD CAMP SPRINGS, MARYLAND 20746  
 301-433-0888 301-433-0897 FAX  
 Email: millennengin@gmail.com  
 Website: millenniumengineering-llc.com

**LEGEND:**

- BRICK FENCE (BT)
- WOOD FENCE (WB)
- CHAIN LINK FENCE (CL)
- VINYL FENCE (V)
- WIRE FENCE (WF)
- BRI
- UTILITY EASEMENT
- PROPERTY LINE
- BUILDING LINE
- WATER MARK
- BRICK AREA
- RECF - REBAR & CAP FOUND
- PPF - PINCH PIPE FOUND
- IPF - IRON PIPE FOUND
- AC - AIR CONDITION UNIT
- WM - WATER METER
- C/O - CLEAN OUT
- P/W - PARTY WALL
- B/W - BAY WINDOW
- C/W - CELLAR WELL
- W/W - WINDOW WELL
- O/H - OVERHANG
- R/W - RIGHT-OF-WAY
- EXH FAN - EXHAUST FAN
- AW - AREAWAY
- CHM - CHIMNEY
- POR - PORCH
- ST - STOOP
- COV POR - COVERED PORCH
- ENCL POR - ENCLOSED PORCH
- ADDN - ADDITION
- ENTR - ENTRANCE
- SH - SHED
- PUE - PUBLIC UTILITY EASEMENT
- PIE - PUBLIC IMPROVEMENT EASEMENT
- BRL - BUILDING RESTRICTION LINE
- PROP COR - PROPERTY CORNER
- SF - SQUARE FEET
- ESMT - EASEMENT
- YL - YARD LINE
- NF - NO PIPE FOUND
- LP - LIGHT POLE
- BALC - BALCONY

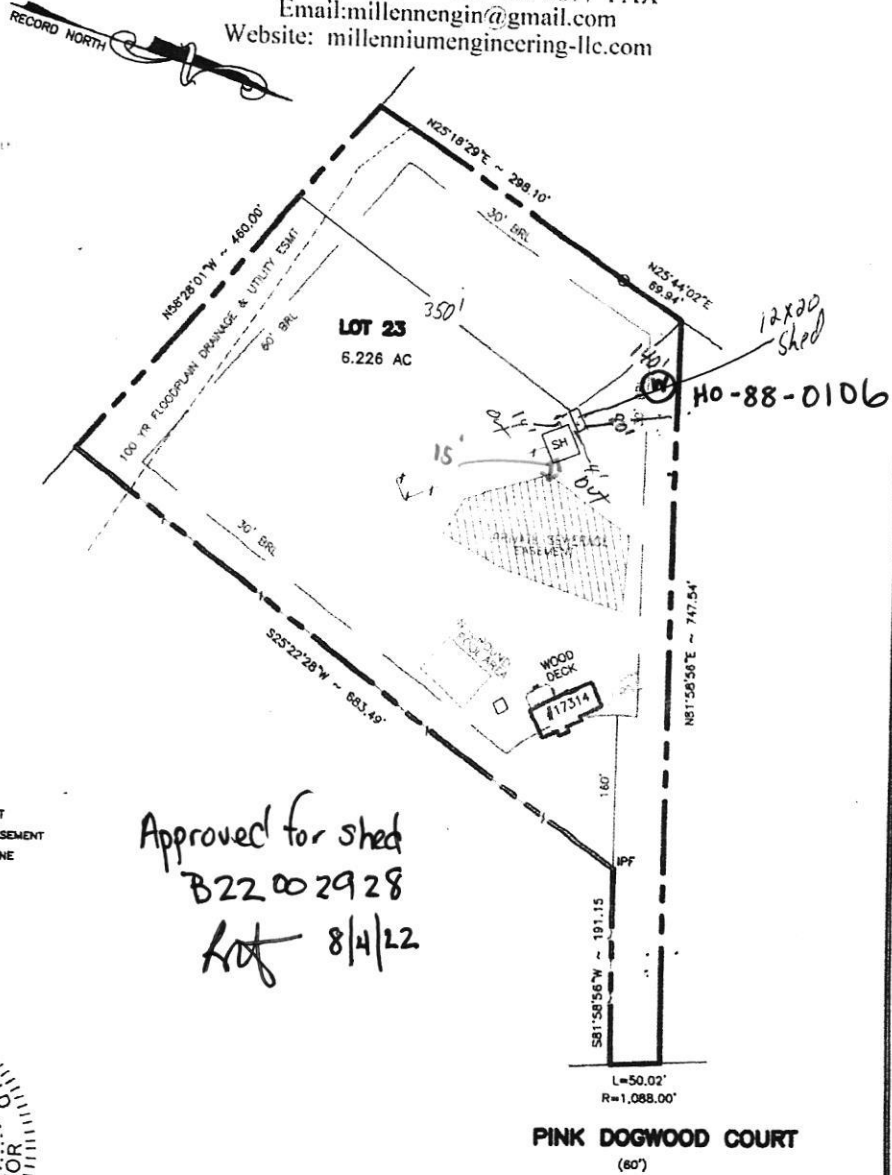

**SURVEYOR'S CERTIFICATE**  
 LICENSE EXPIRATION DATE: 04-30-2020  
 I hereby certify that this drawing is based on a field survey made on 5/30/2018 by me or directly under my supervision and to the best of my knowledge information & belief correctly represents the facts found at the time of survey.

- NOTES:**
- This drawing is not intended for the use in the establishment of property lines. This drawing is only valid within six months from the date hereof.
  - For title purposes only.
  - No title report furnished at this time, subject to all easements and right of way of record and as may be stated in deed(s) and noted on record plat.
  - Party walls may not be on line. No access for interior measurements.
  - Encroachments may exist. Property corners have not been set with this survey. Property information was taken from best available records.
  - This location drawing is not to be used for resubdivision purposes, construction of fences or other improvements. A boundary survey, lot stakeout and/or survey-to-mark would have to be performed to determine the location of all property lines shown.
  - Flood zone and certificates as available upon request.
  - Boundary survey needed for accurate location of house, fences, sheds and all easements & rights-of-way.
  - No pipes/corners found unless otherwise noted. Location based upon physical evidence.
  - Accuracy of this survey is +/- 1 foot.
  - Information given for title company and purchaser(s) is solely for informational purposes ONLY.

**ORDERED BY:**  
  
 10411 Motor City Drive  
 Suite 690  
 Bethesda, Md. 20817  
 Office: (202) 630-3700  
 Fax: (202) 521-1802  
 "Your settlement is a big deal for you, and that is a big deal for us"

**LOCATION DRAWING**  
**LOT 23**  
**WHITE WOOD**  
**ESTATES**  
 PLAT CMP NO. 8243  
 17314 PINK DOGWOOD COURT  
 4TH ELECTION DISTRICT  
 HOWARD COUNTY, MARYLAND  
 DATE: 5/30/2018 SCALE: 1"=150' FILE: MTE M18-4147-MR DWG: 49447

SERVICE


# MILLENNIUM ENGINEER

PARK PLACE PROFESSIONAL CENTER  
5825 ALLENTOWN ROAD CAMP SPRINGS, MARYL

301-433-0888 301-433-0897 FAX

Email: millennengin@gmail.com

Website: millenniumengineering-llc.com

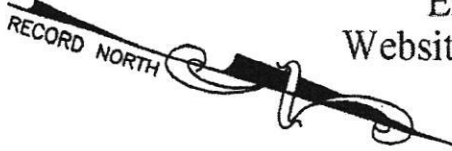

(IF)  
: (WF)  
FENCE (CLP)  
(VF)

MENT  
NE  
E

AREA  
VE

AP FOUND  
FOUND  
OUND  
ON UNIT  
R

L  
AY  
I

RCH  
ORCH

TY EASEMENT  
OVEMENT EASEMENT  
STRICTION LINE  
DRNER

D  
ND

