

PERMIT NUMBER: B

DATE ACCEPTED:

RECEIVED



RESIDENTIAL BUILDING PERMIT APPLICATION

19 2022

HOWARD COUNTY DEPARTMENT OF INSPECTIONS, LICENSES, AND PERMITS

3430 COURT HOUSE DRIVE, ELLICOTT CITY, MD 21043 - PHONE: (410) 313-2455 OPTION #4

www.howardcountymd.gov

BUILDING SITE ADDRESS REQUIRED

Street Address: 15245 Burks Run Dr, City: Woodbine, State: MD, Zip Code: 21797, Subdivision/Village/Complex Name: Woodglow West, SDP/WP/BA #: , Lot: 6, Tax Map: , Parcel: A, Grading Permit #:

DESCRIPTION OF WORK REQUIRED

Existing Use: Storage area, Proposed Use: Storage, Estimated Cost: \$ 4,800.00, Trade Work to Be Completed (Separate Permits Required): [] Mechanical (HVACR) [] Electrical [] Plumbing [] None, Build storage area under deck 12x19

PROPERTY OWNER INFORMATION REQUIRED

Owner(s) Name(s) (As it appears on tax records): Matthew G... Primary Residence: [] Yes [] No, Owner's Street Address: 15245 Burks Run Dr, City: Woodbine, State: MD, Zip Code: 21797, Phone: 240-401-1244, Email:

APPLICANT NAME REQUIRED - INDIVIDUAL WHO SIGNS THIS APPLICATION

Business Name: Love Home Imp, Contact Name: Rob Love, Street Address: 2360 Braddock Rd, City: Mt Airy, State: MD, Zip Code: 21776, Phone: 301-292-6627, Email:

CONTRACTOR INFORMATION REQUIRED

Business Name: Love Home Imp, Licensee's Name: , License #: 128803, Street Address: 2360 Braddock Rd, City: Mt Airy, State: MD, Zip Code: 21776, Phone: , Email:

ARCHITECT/ENGINEER INFORMATION INDIVIDUAL WHO SIGNED PLANS, IF APPLICABLE

Business Name: Teehan Design, Name: Harry Teehan, Street Address: 1111 Yorkshire Way, City: Woodbine, State: MD, Zip Code: 21797, Phone: 410-876-6517, Email: htee@teehan47.com.net

BUILDING CHARACTERISTICS REQUIRED

Primary Structure: [] SF Dwelling [] SF Townhouse [] SF Duplex [] Mobile Home [] Multi-Family Dwelling (MF*) Condo: [] Yes [] No, Utilities: [] Electric [] Gas, Water Supply: [] Public [] Private (Well), Sewage Disposal: [] Public [] Private (Septic), Heating System: [] Electric [] Natural Gas [] Propane [] Other, Roadside Tree Project: [] No [] Yes: #, Sprinkler System: [] NFPA 13 [] NFPA 13R [] NFPA 13D [] None, Fire Alarm System: [] Yes [] No [] Voice Evac

ADDITIONAL RESIDENTIAL INFORMATION (PLEASE SELECT/COMPLETE ALL THAT APPLY)

Model Name & Options: # of Bedrooms (SF): # of efficiency units (MF*): # of 1 BR (MF*): # of 2 BR (MF*): # of 3 BR (MF*): # Rooms: # Full Baths: # Half Baths: # Fireplaces: Garage/Carport Info: [] Attached Garage [] Detached Garage [] Integral Garage [] Carport [] None, Basement/Foundation Info: [] Slab on Grade [] Post & Pier [] Unfinished Basement [] Finished Basement: [] Full or [] Partial, 1st Fl Width: 1st Fl Depth: 2nd Fl Width: 2nd Fl Depth: Bsmt Width: Bsmt Depth: Energy Method: [] Prescriptive [] Performance [] UA Alternative [] ERI, Gross Area: sq ft, Occupiable Area: sq ft

AGREEMENT/ DISCALIMER REQUIRED

THE UNDERSIGNED HEREBY CERTIFIES AND AGREES AS FOLLOWS: (1) THAT HE/SHE IS AUTHORIZED TO MAKE THIS APPLICATION; (2) THAT THE INFORMATION IS CORRECT; (3) THAT HE/SHE WILL COMPLY WITH ALL REGULATIONS OF HOWARD COUNTY WHICH ARE APPLICABLE THERETO; (4) THAT HE/SHE WILL PERFORM NO WORK ON THE ABOVE REFERENCED PROPERTY NOT SPECIFICALLY DESCRIBED IN THIS APPLICATION; (5) THAT HE/SHE GRANTS COUNTY OFFICIALS THE RIGHT TO ENTER ONTO THIS PROPERTY FOR THE PURPOSE OF INSPECTING THE WORK PERMITTED AND POSTING NOTICES.

APPLICANT'S ORIGINAL SIGNATURE: Rob Love, DATE SIGNED: 7/19/22

FOR OFFICE USE ONLY

CHECKS PAYABLE TO: DIRECTOR OF FINANCE OF HOWARD COUNTY

AGENCIES REQUIRED/APPROVALS: [] PR [] DPZ [] DED [] Health 8/5/22 [] SHA [] CID

SUBMITTAL FEES: \$25.00, PAYMENT: Online, ACCEPTED BY:

RECEIVED

PERMIT NUMBER: B 22002819

DATE ACCEPTED:

JUL 19 2022

LICENSES & PERMITS DIVISION



RESIDENTIAL BUILDING PERMIT APPLICATION

HOWARD COUNTY DEPARTMENT OF INSPECTIONS, LICENSES, AND PERMITS

3430 COURT HOUSE DRIVE, ELLICOTT CITY, MD 21043 - PHONE: (410) 313-2455 OPTION #4 www.howardcountymd.gov

BUILDING SITE ADDRESS REQUIRED

Street Address: 15245 Bucks Run Dr. City: Woodbine State: MD Zip Code: 21797

DESCRIPTION OF WORK REQUIRED

Existing Use: Storage Area (S/D) Proposed Use: Storage Estimated Cost: \$ 4,800.00 Trade Work to Be Completed: Build Storage Area under deck 12x19

PROPERTY OWNER INFORMATION REQUIRED

Owner(s) Name(s): Matthew Grzeslan Primary Residence: Yes No Owner's Street Address: 15245 Bucks Run Dr. City: Woodbine State: MD Zip Code: 21797

APPLICANT NAME REQUIRED - INDIVIDUAL WHO SIGNS THIS APPLICATION

Business Name: LOAR Home Imp. Contact Name: Rob Loar Street Address: 2360 Braddock Rd. City: Mt. Airy State: MD Zip Code: 21771

CONTRACTOR INFORMATION REQUIRED

Business Name: LOAR Home Imp. Licensee's Name: George Loar License #: 128803 Street Address: 2360 Braddock Rd. City: Mt. Airy State: MD Zip Code: 21771

ARCHITECT/ENGINEER INFORMATION INDIVIDUAL WHO SIGNED PLANS, IF APPLICABLE

Business Name: Perrine Design Name: Harry Perrine Street Address: 1111 Yorkshire Way City: Westminster State: MD Zip Code: 21158

BUILDING CHARACTERISTICS REQUIRED

Primary Structure: SF Dwelling Utilities: Electric Gas Water Supply: Public Private (Well) Sewage Disposal: Public Private (Septic) Heating System: Electric Natural Gas Propane Other: Roadside Tree Project: No Yes: #

ADDITIONAL RESIDENTIAL INFORMATION (PLEASE SELECT/COMPLETE ALL THAT APPLY)

Model Name & Options: # of Bedrooms (SF): # of efficiency units (MF*): # of 1 BR (MF*): # of 2 BR (MF*): # of 3 BR (MF*): # Rooms: # Full Baths: # Half Baths: # Fireplaces: Garage/Carport Info: Basement/Foundation Info: 1st Fl Width: 1st Fl Depth: 2nd Fl Width: 2nd Fl Depth: Bsmt Width: Bsmt Depth: Energy Method: Prescriptive Performance UA Alternative ERI Gross Area: sq ft Occupiable Area: sq ft

AGREEMENT/ DISCALIMER REQUIRED

THE UNDERSIGNED HEREBY CERTIFIES AND AGREES AS FOLLOWS: (1) THAT HE/SHE IS AUTHORIZED TO MAKE THIS APPLICATION; (2) THAT THE INFORMATION IS CORRECT; (3) THAT HE/SHE WILL COMPLY WITH ALL REGULATIONS OF HOWARD COUNTY WHICH ARE APPLICABLE THERETO; (4) THAT HE/SHE WILL PERFORM NO WORK ON THE ABOVE REFERENCED PROPERTY NOT SPECIFICALLY DESCRIBED IN THIS APPLICATION; (5) THAT HE/SHE GRANTS COUNTY OFFICIALS THE RIGHT TO ENTER ONTO THIS PROPERTY FOR THE PURPOSE OF INSPECTING THE WORK PERMITTED AND POSTING NOTICES.

Rob Loar APPLICANT'S ORIGINAL SIGNATURE 7/19/22 DATE SIGNED

FOR OFFICE USE ONLY

CHECKS PAYABLE TO: DIRECTOR OF FINANCE OF HOWARD COUNTY

AGENCIES REQUIRED/APPROVALS:

PR DPZ DED Health SHA CID

SUBMITTAL FEES: \$25.00 PAYMENT: Online ACCEPTED BY: [Signature]

ORDERED BY:

titleforward

O: 267-908-8999
www.titleforward.com

Bucks Run Rd

15245 Bucks Run

PROPERTY ADDRESS: 15245 BUCKS RUN DRIVE WOODBINE, MARYLAND 21797

SURVEY NUMBER: 1508.3613

FIELD WORK DATE: 9/23/2015

REVISION HISTORY: (REV.0 9/30/2015)


1508.3613
BOUNDARY SURVEY
LOT 6
WELLINGTON WEST, SECTION 2,
HOWARD COUNTY, MARYLAND
09-29-2015 SCALE 1"=80'

PROPERTY OF
ALAN SCHMIDBAUER
CAROL SCHMIDBAUER
LIBER 5607, FOLIO 294




SCALE: 1"=40'

WELLINGTON WEST
SECTION 2, AREA ONE
AGRICULTURAL PRESERVATION PARCEL 'A'

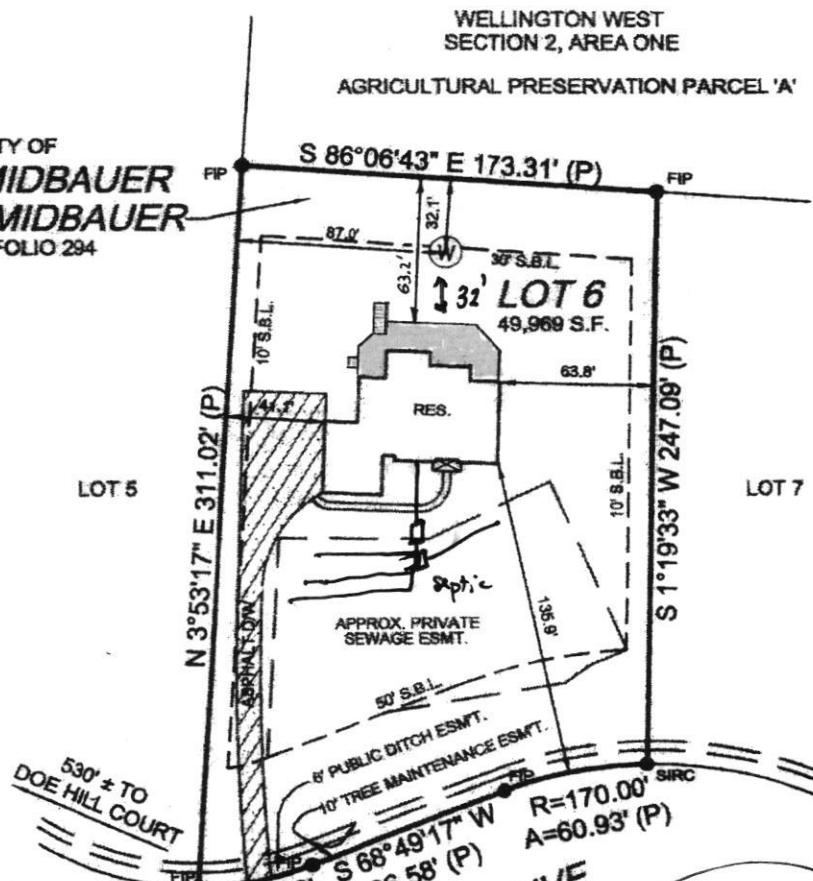

John E. Kroboth
EXPIRES 5-26-2016

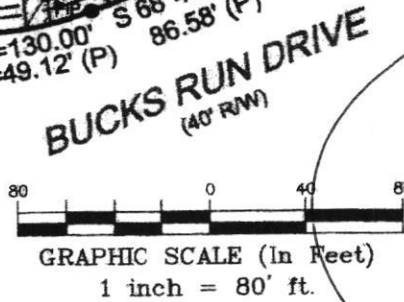

NEW PLOT

Approved for storage
area under deck
B22002819
Rkt 8/5/22

POINTS OF INTEREST:
NONE VISIBLE