

Record Detail (This section is required.)

Permit Type Building/Residential/Misc/Porch **Permit Number** B23004883 **Opened Date** 12/18/2023
Description of Work
 SFD/CONSTRUCT COVERED DECK WITH STEPS TO GRADE AND REDO OPEN DECK AND STEPS TO GRADE - APPROX 16x13 SCREENED PORCH & 20X13 DECK

[check spelling](#)

Address (This section is required.)

Search Reset Clear Get Parcel & Owner
Street # 900 **Street Name** HIGH STEPPER **Street Type** TRL
Unit Type --Select-- **Unit #** **X Coordinate** -76.94799 **Y Coordinate** 39.34525
City SYKESVILLE **State** MD **Zip Code** 21784 **Primary** Yes

Approved based on updated and accurate plot plan.

g/l 1/24/24

Parcel (This section is required.)

Search Reset Clear Get Address & Owner

GIS ID	Parcel	Parcel Area	Land Value	Improved Value	Exemption Value	Plan Area
831869	338	3.91	245800	851800	606000	RURAL

Legal Description
 IMPVLOT 1 3.910 A[]900 HIGH STEPPER TRL[]RIVER DNS S1 RSB LOT 1

[check spelling](#)

Block	Lot	Census Tract	Council Dist	Inspection Dist	Supervisor Dist	Map #	DAP Zone
	1	603000	5				
Plan Area		State Tax Id		Subdivision Name			
		1403316505		River Downs			
Section		Area		Tax Map			
				9			
Grid		Zoning District		ADC Map			
9-5		RR-DEO		4693-J5			
SDP No.		Final Plan No.		WP File No.			
Record Plat No.		WS Contract No.		FDP No.	Primary		
9706					Yes		
Owner Occupied		Year Built		Historic District			
<input type="radio"/> Yes <input type="radio"/> No		1994		<input type="radio"/> Yes <input checked="" type="radio"/> No			
Historic District Registry No.		Stat Area		Flood Plain			
		3-01		<input type="radio"/> Yes <input checked="" type="radio"/> No			
Building No							

Owner (This section is required.)

Search Reset Clear
Name
 KIEF MARK
Address Line 1
 900 HIGH STEPPER TRL
Address Line 2
Address Line 3
Mail City SYKESVILLE **Mail State** MD **Mail Zip Code** 21784

Phone 443-867-4699 Primary Yes

Cell Number Fax Number

Professionals (This section is not required.)

License # 08010117806 Business Name BARNABAS DOMOWSKI License Type MHIC Ind Primary Yes Address Line 1 8236 OLD MILL RD City PASADENA State MD ZIP Code 21122-0000 Phone 1 5206782538 Phone 2 Fax E-mail DECKINGMARYLAND@GMAIL.COM

Applicant (This section is not required.)

Search As Owner As Lic. Prof As Contact

Type Applicant Relationship Applicant Primary Yes First Name BARNABAS MI Last Name DOMOWSKI Full Name BARNABAS DOMOWSKI Organization Name BARNABAS DOMOWSKI Street Address 8236 OLD MILL RD Address Line 2 City PASADENA State MD Zip Code 21122-0000 Phone 5206782538 Cell Fax E-mail DECKINGMARYLAND@GMAIL.COM

Addtl Info

Est Construction Cost 8000 Housing Units 0 Number of Buildings 0 Public Owned No Construction Type 434 - Additions, Alterations and Conversions - Residential


PORCH INFORMATION

PORCH INFORMATION Capital Project-No Fee Yes No Capital Project Number Fee Exempt Yes No Roadside Tree Project Permit Yes No Roadside Tree Project Permit # Existing Use SFD Type of Porch Open and Screened Por Type of Porch Foundation Reconstruct Existing Deck Total Square Footage 208 SQFT Water Supply Public Sewage Disposal Public Expiration Date 7/1/2024


Submit Cancel

1=20 scale

How Stepped Tram

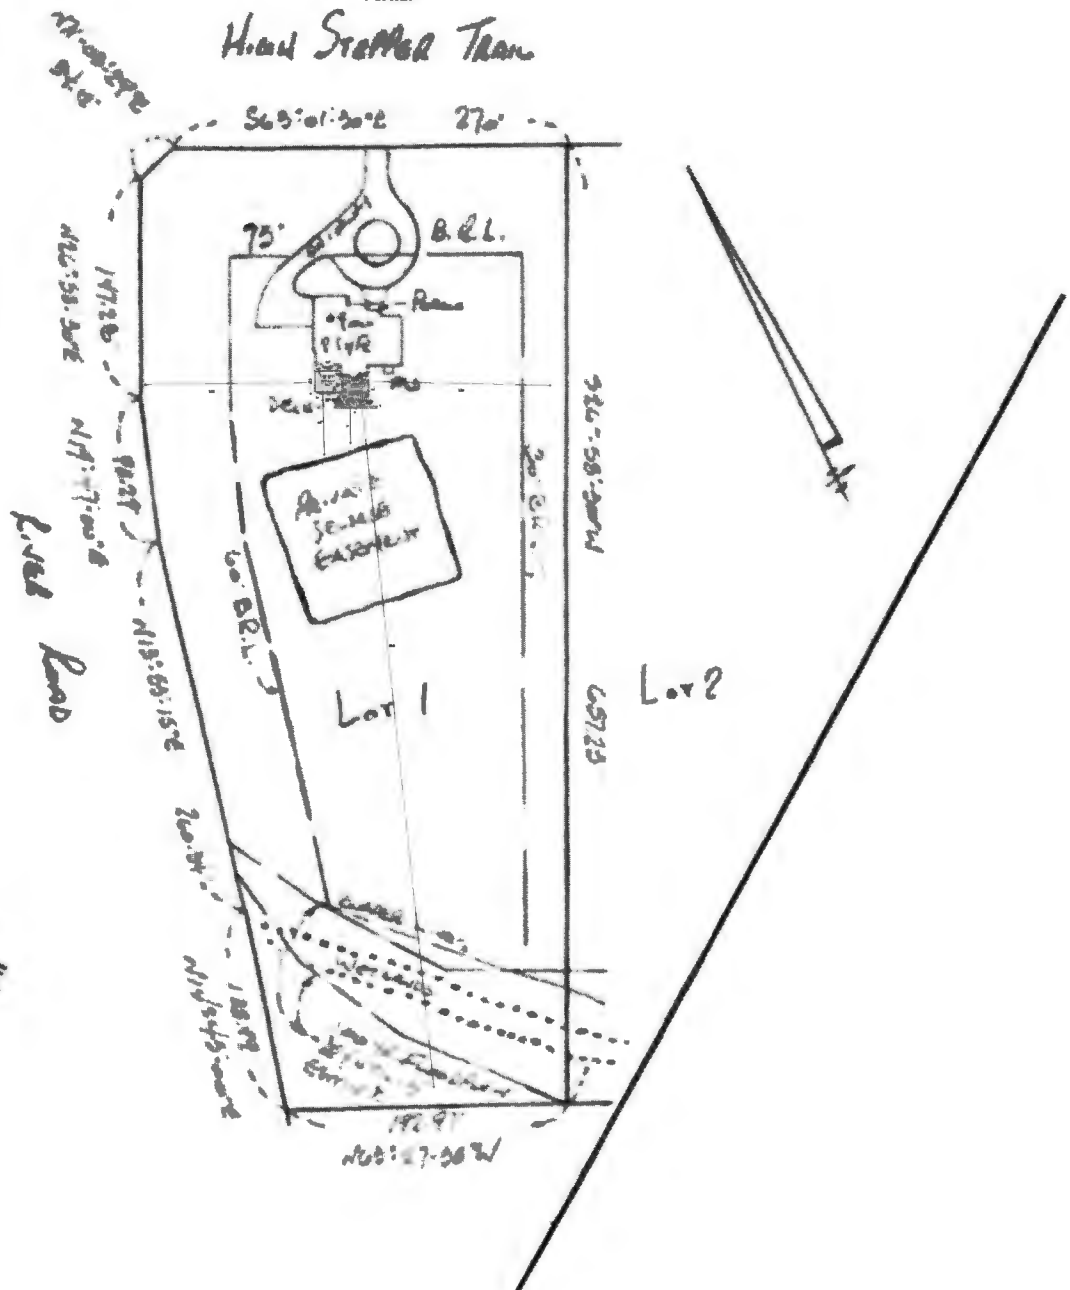

SURVEYORS CERTIFICATE

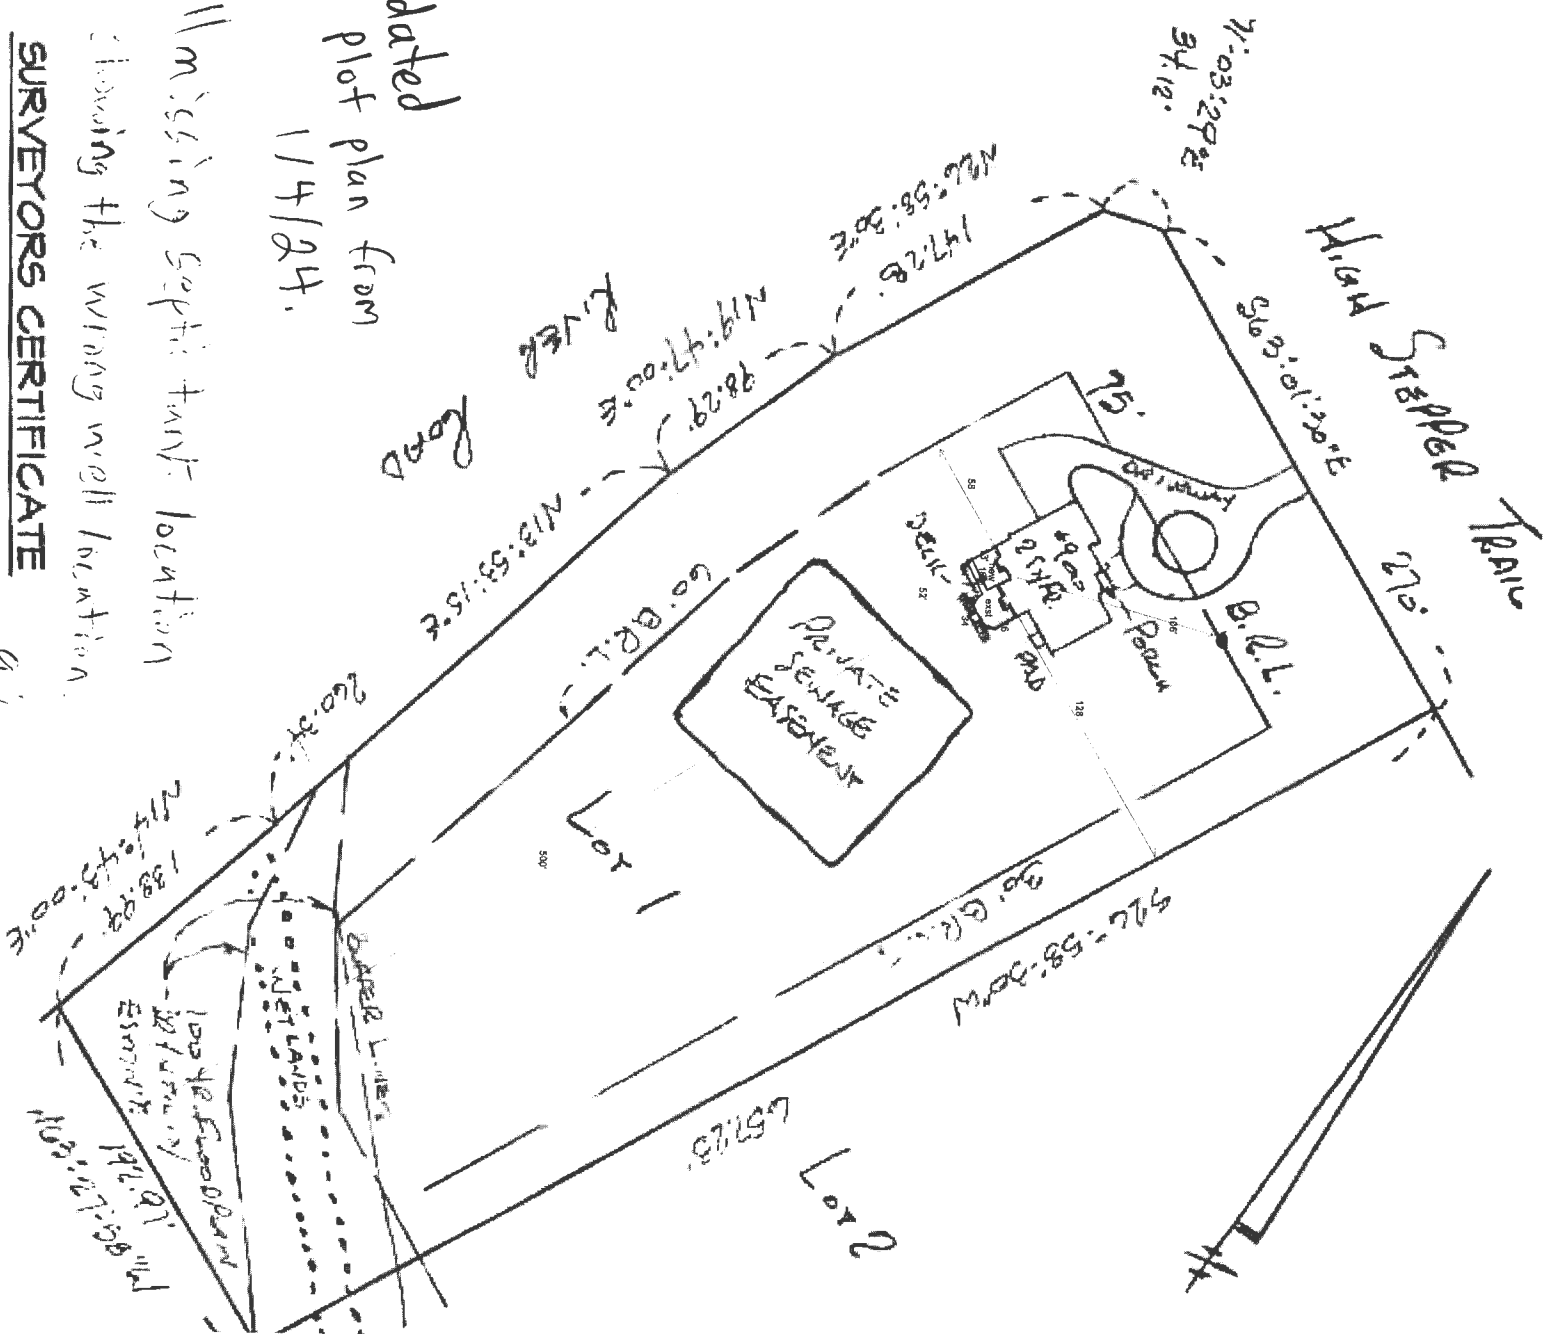


updated
plot plan from
1/4/24.

Still missing Septic tank location
and showing the well location.

SURVEYORS CERTIFICATE

9/7
1/23/24

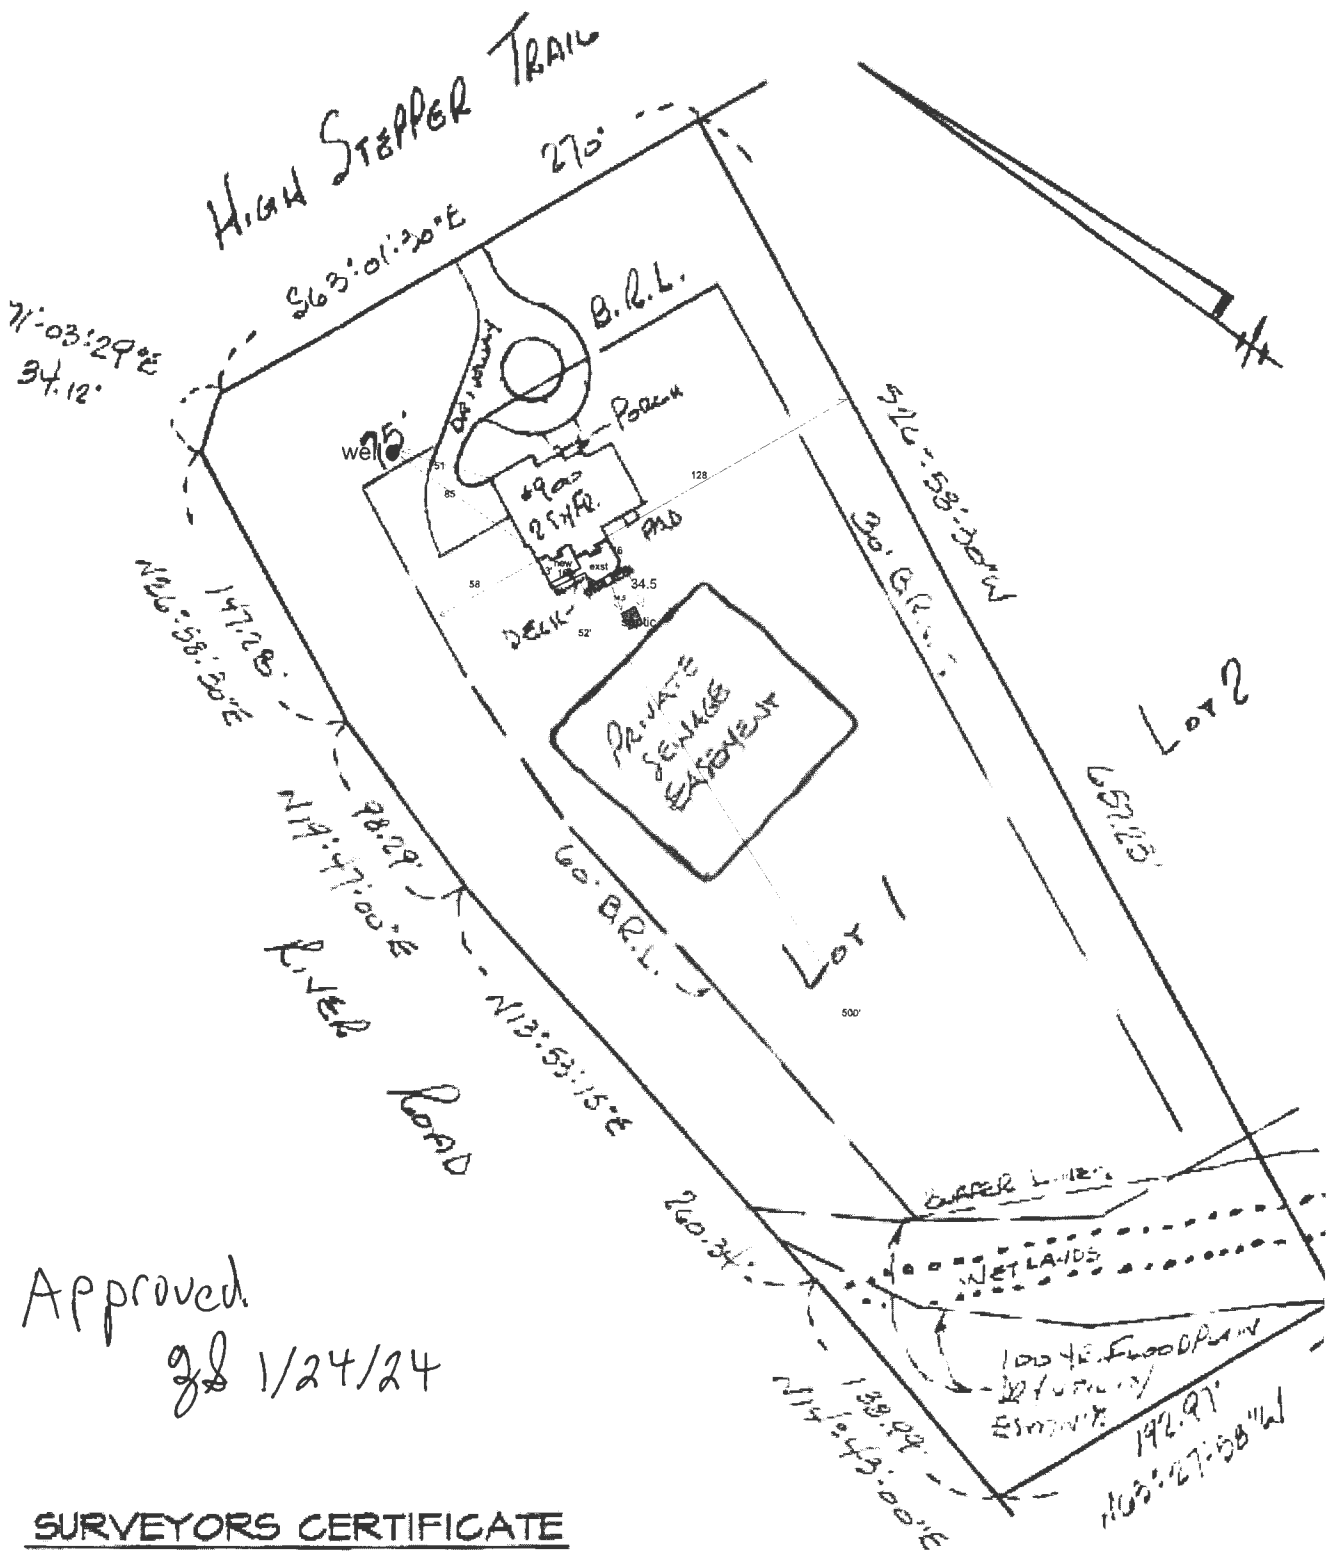

Approved
 J.S. 1/24/24

SURVEYORS CERTIFICATE