

Record Detail * (This section is required.)

Permit Type Building/Residential/Misc/Tanks	Permit Number B24000326	Opened Date 01/30/2024
Description of Work SFD/ INSTALL (1) ONE 500 GALLON UNDERGROUND PROPANE TANK		

[check spelling](#)

Address * (This section is required.)

Search	Reset	Clear	Get Parcel & Owner	
Street # 1857	Street Name FLORENCE	Street Type RD		
Unit Type --Select--	Unit #	X Coordinate -77.14252	Y Coordinate 39.31853	
City MOUNT AIRY	State MD	Zip Code 21771	Primary Yes	



Parcel * (This section is required.)


Search	Reset	Clear	Get Address & Owner			
GIS ID 909900	Parcel 238	Parcel Area 2.12	Land Value 221200	Improved Value 565800	Exemption Value 344600	Plan Area RURAL
Legal Description IMPSLOT1 2.126AR[]1857 FLORENCE RD[]FLORENCE ESTATES						

[check spelling](#)

Block 1	Lot 1	Census Tract 604001	Council Dist 5	Inspection Dist	Supervisor Dist	Map #	DAP Zone
Plan Area	State Tax Id 1404338243	Subdivision Name FLORENCE ESTATES					
Section	Area	Tax Map 6					
Grid 6-23	Zoning District RC-DEO	ADC Map 4690-H10					
SDP No.	Final Plan No.	WP File No.					
Record Plat No. 3863	WS Contract No.	FDP No.	Primary Yes				
Owner Occupied <input type="radio"/> Yes <input type="radio"/> No	Year Built 1979	Historic District <input type="radio"/> Yes <input checked="" type="radio"/> No					
Historic District Registry No.	Stat Area 4-04	Flood Plain <input type="radio"/> Yes <input checked="" type="radio"/> No					
Building No							

Owner * (This section is required.)

Search	Reset	Clear
Name CULP KEVIN		
Address Line 1 1857 FLORENCE RD		
Address Line 2		

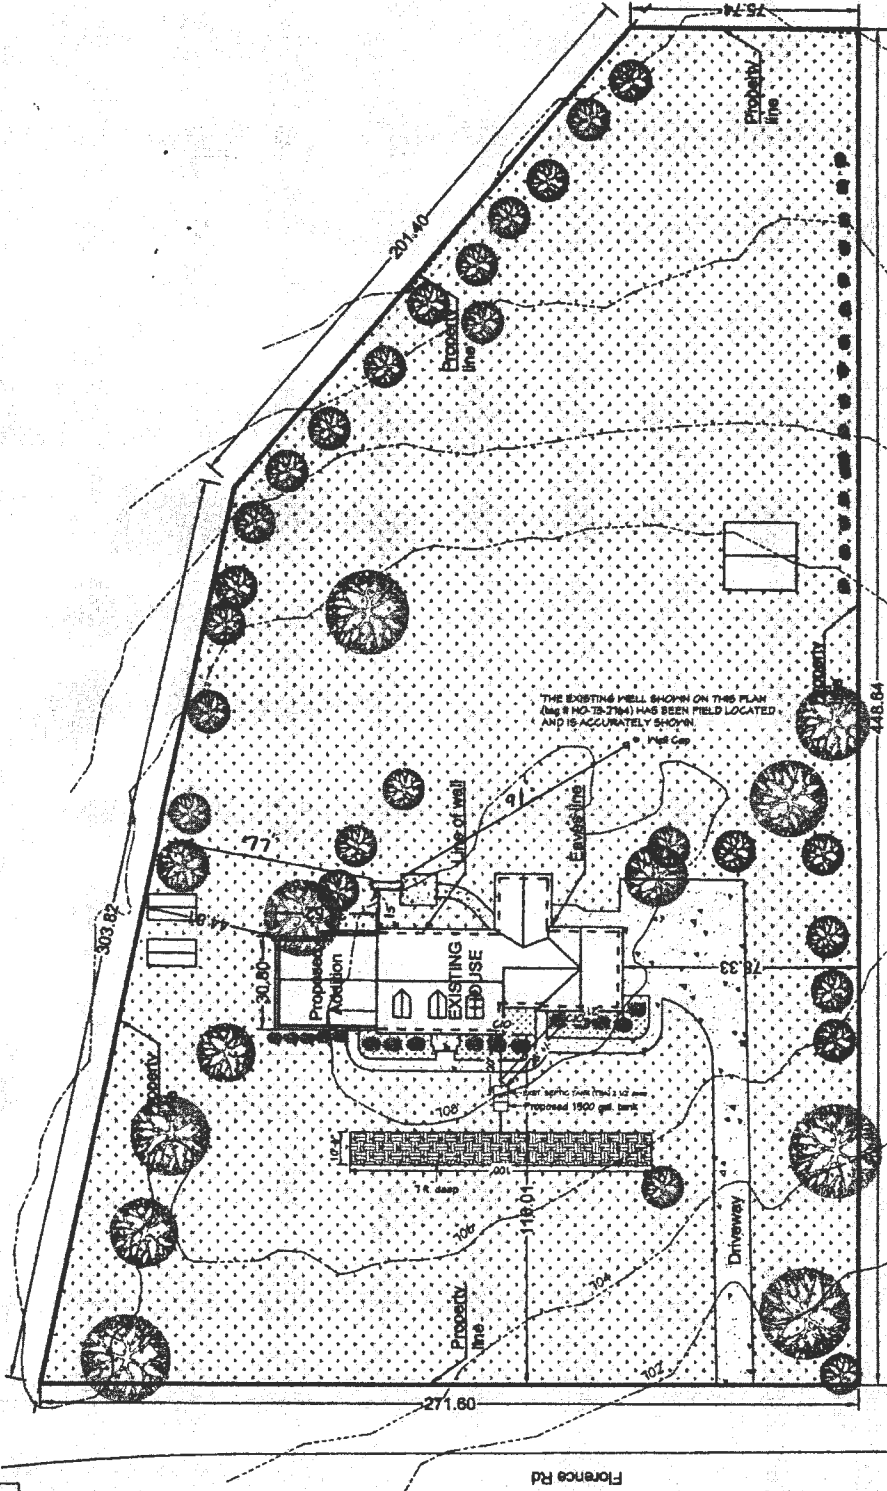

Owners: Kevin and Janet Culp
Phone: (301) 335-5339
Address: 1857 Florence Rd
MT Airy, MD 21171
Beeble 1/14/07



DESIGNED FOR: Culp
BY: Jim Cabral

ELEVATE
DESIGN | BUILD

Approved for LP tank
B24000326
JAC 2/1/24

(matches official archive)