

Record Detail * (This section is required.)

Permit Type: Building/Residential/Misc/Tanks Permit Number: B23004017 Opened Date: 10/03/2023

Description of Work: SFD/ Install 1000 gallon underground propane tank

[check spelling](#)


Address * (This section is required.)

Search Reset Clear Get Parcel & Owner

Street #: 16453 Street Name: FREDERICK Street Type: RD

Unit Type: --Select-- Unit #: X Coordinate: -77.08475 Y Coordinate: 39.33801

City: WOODBINE State: MD Zip Code: 21797 Primary: Yes

Approved 10/1/23


Parcel * (This section is required.)

Search Reset Clear Get Address & Owner

GIS ID: 831731 Parcel: 467 Parcel Area: 6.15 Land Value: 253600 Improved Value: 625800 Exemption Value: 372200 Plan Area: RURAL

Legal Description: IMPSLOT 7 6.150 AR[]16453 FREDERICK RD[]STANLEY B MILLER

[check spelling](#)

Block: Lot: 7 Census Tract: 604001 Council Dist: 5 Inspection Dist: Supervisor Dist: Map #: DAP Zone:

Plan Area: State Tax Id: 1404334884 Subdivision Name: Stanley Miller Property

Section: Area: Tax Map: 7

Grid: 7-11 Zoning District: RC-DEO ADC Map: 4691-G6

SDP No.: Final Plan No.: WP File No.:

Record Plat No.: 27/22 WS Contract No.: FDP No.: Primary: Yes

Owner Occupied: Year Built: 1988 Historic District: Yes No

Historic District Registry No.: Stat Area: 4-05 Flood Plain: Yes No

Building No:


Owner * (This section is required.)

Search Reset Clear

Name: RENE P. NUSEN

Address Line 1: 16453 FREDERICK RD

1 in. = 40 ft.

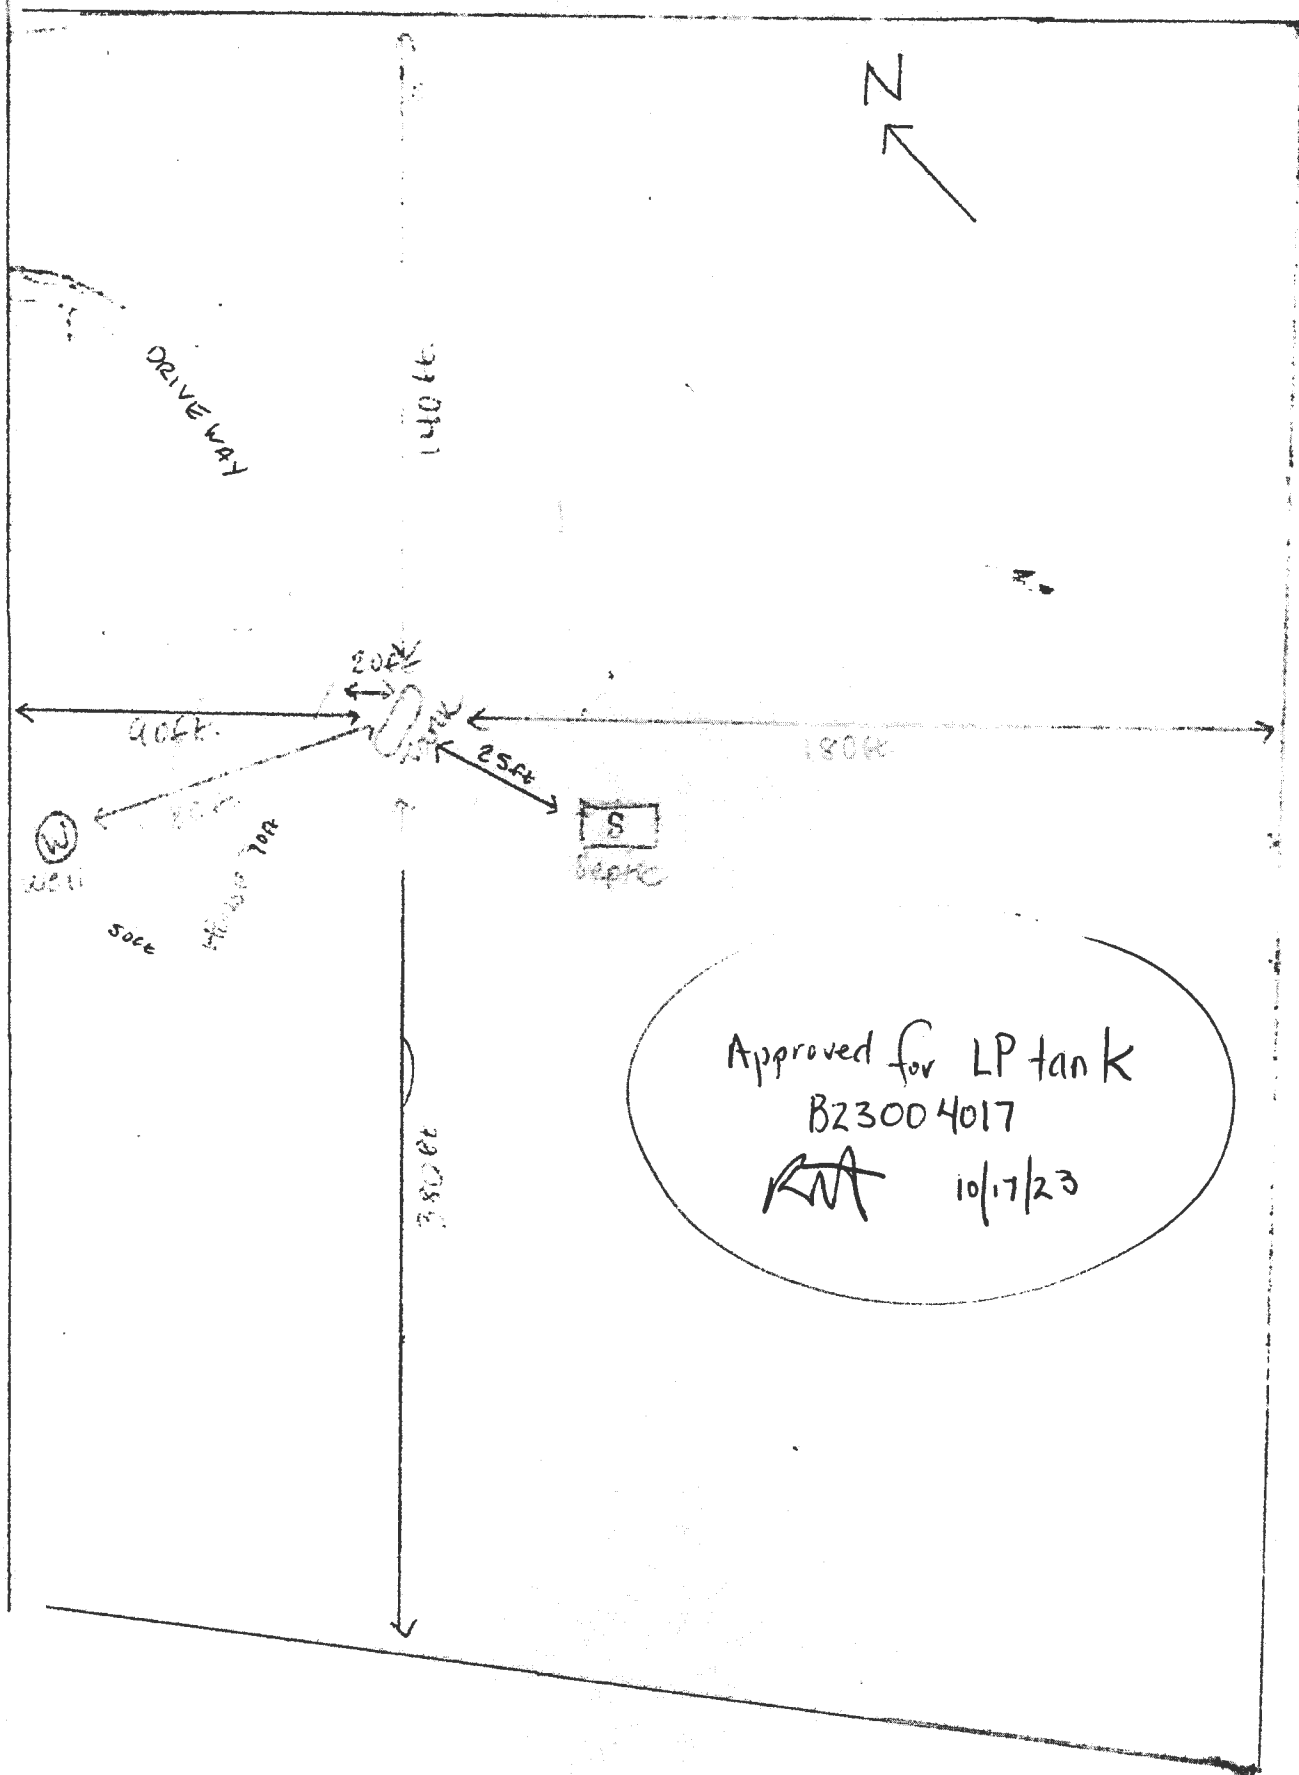

Approved for LP tank
B23004017
KAT 10/17/23