

25 permit

Record Detail * (This section is required.)

Permit Type	Permit Number	Opened Date
Building/Residential/Alteration/SFD	B23004122	10/11/2023

Description of Work

SFD/ Alterations to Existing Dwelling to Include- Finishing approx. 1,800sqft of basement space. Rooms to include, Office, Play Room, Gym, Rec Room, Full Bathroom, Storage/Mechanical room**ANY ROOM USED FOR A SLEEPING ROOM MUST MEET EGRESS REQUIREMENTS, SMOKE DETECTORS REQUIRED

[check spelling](#)

Existing house is 4BDRs, septic is OK for 5BDR. Approved.
JS

Address * (This section is required.)

Search Reset Clear Get Parcel & Owner

Street # 5640 Street Name DOSA Street Type CT

Unit Type --Select-- Unit # X Coordinate -76.95323 Y Coordinate 39.21979

City CLARKSVILLE State MD Zip Code 21029 Primary Yes

Parcel * (This section is required.)

Search Reset Clear Get Address & Owner

GIS ID *	Parcel	Parcel Area	Land Value	Improved Value	Exemption Value	Plan Area
11059759	0015	1.32	153200	0	0	RURAL

Legal Description
 LOT 6 1.32 A.[]5640 DOSA CT[]THE WOODLANDS

[check spelling](#)

Block	Lot	Census Tract	Council Dist	Inspection Dist	Supervisor Dist	Map #	DAP Zone
23	6	605101	5				

Plan Area State Tax Id 1405601711 Subdivision Name THE WOODLANDS

Section Area Tax Map 28

Grid Zoning District RC-DEO ADC Map 4933-H5

SDP No. Final Plan No. ECP-15-032 WP File No.

Record Plat No. WS Contract No. FDP No. Primary Yes

Owner Occupied Year Built Historic District
 Yes No Yes No

Historic District Registry No. Stat Area Flood Plain
 5-02A Yes No

Building No

Owner (This section is not required.)

Search Reset Clear

Name * NOWRANGI MILAP

Address Line 1 5640 Dosa Ct

Address Line 2

Address Line 3

Mail City Clarksville Mail State MD Mail Zip Code 21029

Phone 312-351-5680 Primary Yes

E-mail

Cell Number Fax Number

--Select--



Execute Expression "Run expression exception, please contact agency administrator." error:

RESIDENTIAL ALTERATION INFO

RESIDENTIAL ALTERATION INFORMATION


Total Square Footage *	No of Stories *	Basement	Bedrooms	Full Baths	Half Baths	Water *	Sewage *	
1800	SQFT 0	--Select--	▼ 0	1	0	Private	▼ Private	▼
Existing Utilities *	Existing Heating System *	Existing Sprinkler System *	Type of New Fireplace	Expiration Date	Fee Exempt *			
Gas & Electric ▼	Electric & Propane Gas ▼	NFPA #13D	▼ --Select--	▼ 4/21/2024	<input type="checkbox"/> Yes <input type="checkbox"/> No			

Submit **Cancel**


Project: NOWRANGI
5640 DOSA CT.
CLARKSVILLE, MD.

Date: 9.23
Scale: 1/4"=1'-0"

DATE	REVISION

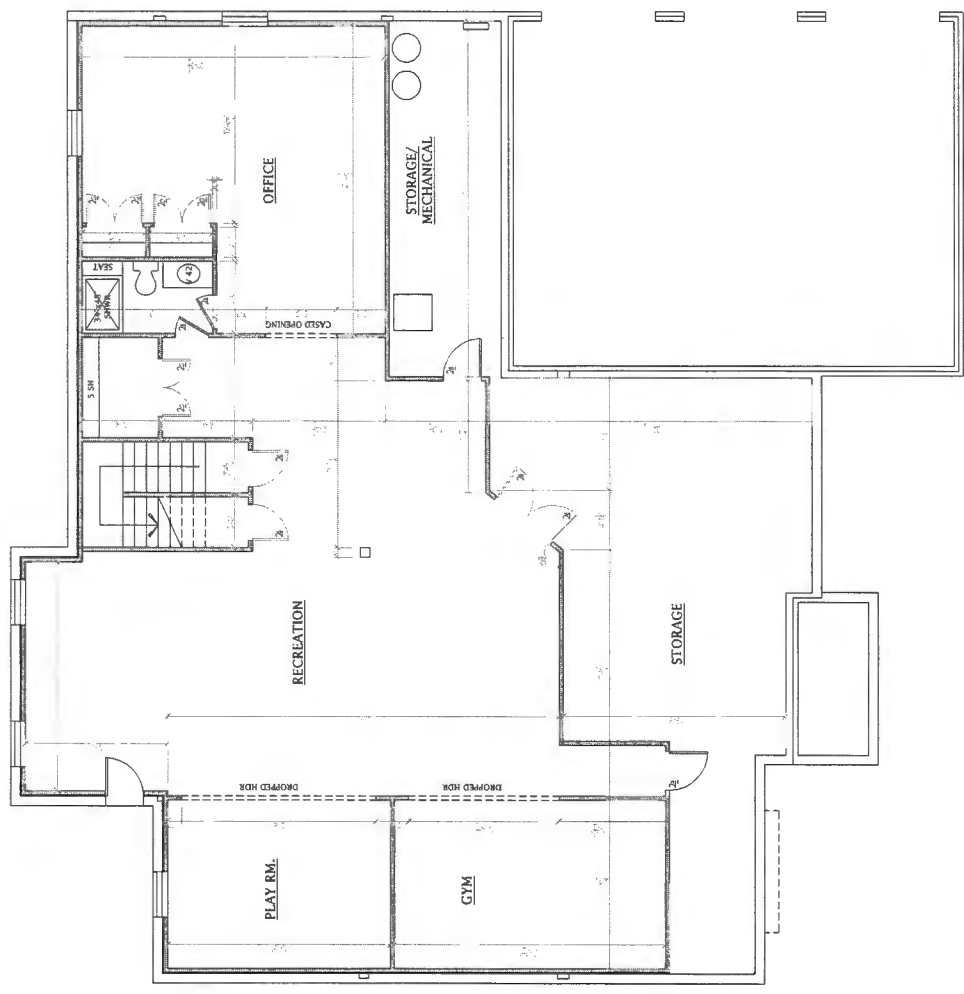

REVISED 9/20

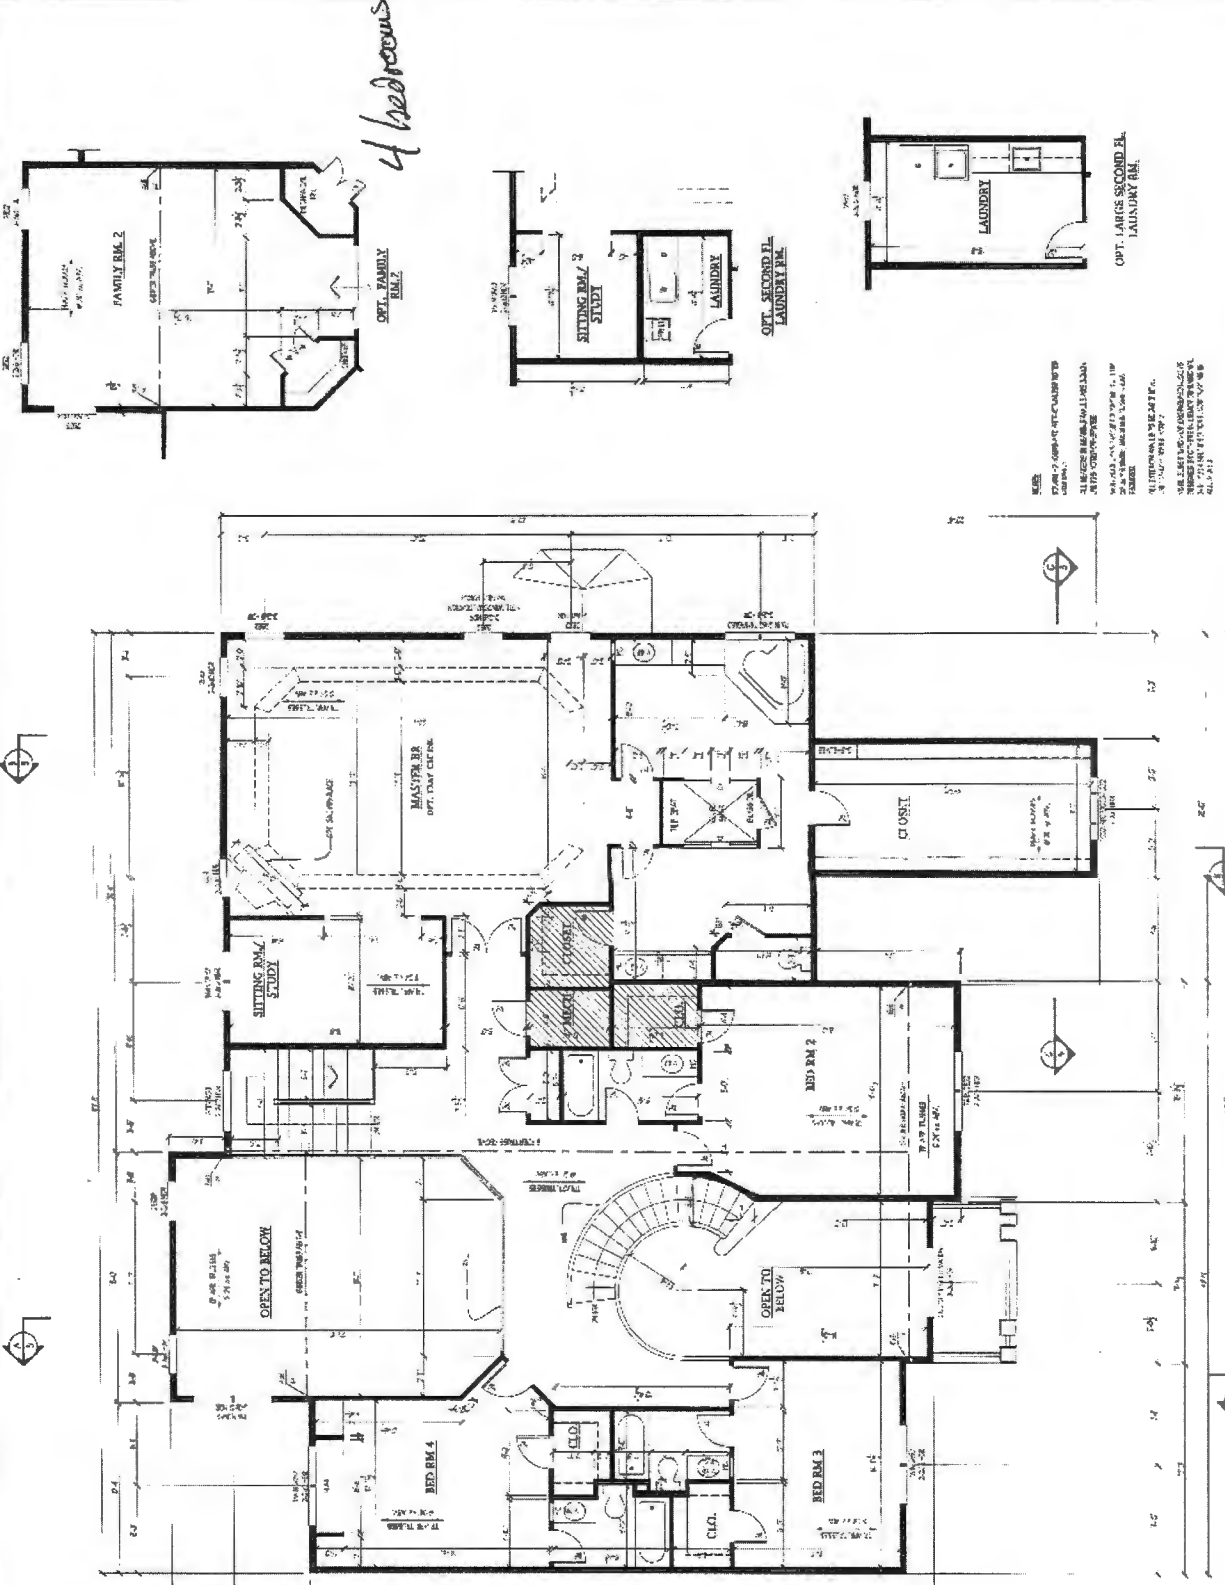

NOTES:
1. OPT. SECOND FL. LAUNDRY RM. IS TO BE CONSIDERED AS AN OPTION.
2. ALL DIMENSIONS ARE TO FACE UNLESS OTHERWISE NOTED.
3. ALL WALLS ARE 1/2" THICK UNLESS OTHERWISE NOTED.
4. ALL DOORS ARE 2'-0" WIDE UNLESS OTHERWISE NOTED.
5. ALL WINDOWS ARE 6'-0" WIDE UNLESS OTHERWISE NOTED.
6. ALL FINISHES ARE TO BE DETERMINED AT THE TIME OF CONSTRUCTION.

4 bedrooms

