

Record Detail * (This section is required.)

Permit Type Building/Residential/Misc/Other Permit Number B23004086 Opened Date 10/09/2023
Description of Work SFD/ CONSTRUCT 18 X 14 Gazebo

check spelling

Online BP.

gls 10/12/23

Address * (This section is required.)

Search Reset Clear Get Parcel & Owner
Street # 13613 Street Name HIGHLAND Street Type RD
Unit Type -Select- Unit # X Coordinate -76.98312 Y Coordinate 39.20695
City CLARKSVILLE State MD Zip Code 21029 Primary Yes

Parcel * (This section is required.)

Search Reset Clear Get Address & Owner
GIS ID * 869340 Parcel 303 Parcel Area 20.64 Land Value 287700 Improved Value 0 Exemption Value 276100 Plan Area RURAL
Legal Description IMPV20.644 A[]13613 HIGHLAND RD[]CLARKSVILLE

check spelling

Block Lot Census Tract Council Dist Inspection Dist Supervisor Dist Map # DAP Zone
Plan Area State Tax Id Subdivision Name
Section Area Tax Map
Grid Zoning District ADC Map
SDP No. Final Plan No. WP File No.
Record Plat No. WS Contract No. FDP No. Primary
Owner Occupied Year Built Historic District
Historic District Registry No. Stat Area Flood Plain
Building No

Owner * (This section is required.)

Search Reset Clear
Name * MELLINO VERONICA ANDREA
Address Line 1 13613 HIGHLAND RD
Address Line 2
Address Line 3
Mail City CLARKSVILLE Mail State MD Mail Zip Code 21029
Phone 954-673-8779 Primary
E-mail veronica.mellino@yahoo.com
Cell Number Fax Number

Approved Septic System Plan
Howard County Health Department
DBernard Signature 10-18-23 Date

Professional (This section is not required.)

License # * NA
License Type * Home Owner
Primary Yes
Business Name HOMEOWNER
First Name VERONICA
Middle Name
Last Name MELLINO
Address Line 1 13613 HIGHLAND ROAD
Address Line 2
City CLARKSVILLE
State MD
ZIP Code 21029
Phone 1 954-673-8779
Phone 2
Fax
E-mail veronica.mellino@yahoo.com

Applicant (This section is not required.)

Search As Owner As Lic. Prof As Contact

Type * Applicant
Relationship Applicant
Primary Yes
First Name veronica
MI
Last Name mellino
Full Name MELLINO VERONICA ANDREA
Organization Name
Street Address 13613 HIGHLAND RD
Address Line 2
City CLARKSVILLE
State MD
Zip Code 21029
Phone 954-673-8779
Cell
Fax
E-mail veronica.mellino@yahoo.com

Addtl Info


Est Construction Cost * 10000
Housing Units * 0
Number of Buildings * 0
Public Owned No
Construction Type 101 - Single Family Houses Detached

MISC PERMIT INFO

MISCELLANEOUS PERMIT INFO

Capital Project-No Fee * Yes No
Capital Project Number
Fee Exempt * Yes No
Roadside Tree Project Permit * Yes No
Roadside Tree Project Permit #
Existing Use * SFD
Type of Structure * Gazebo - Over 200 SQ FT
Water Supply * Private
Sewage Disposal * Private
Expiration Date 4/9/2024

Submit Cancel

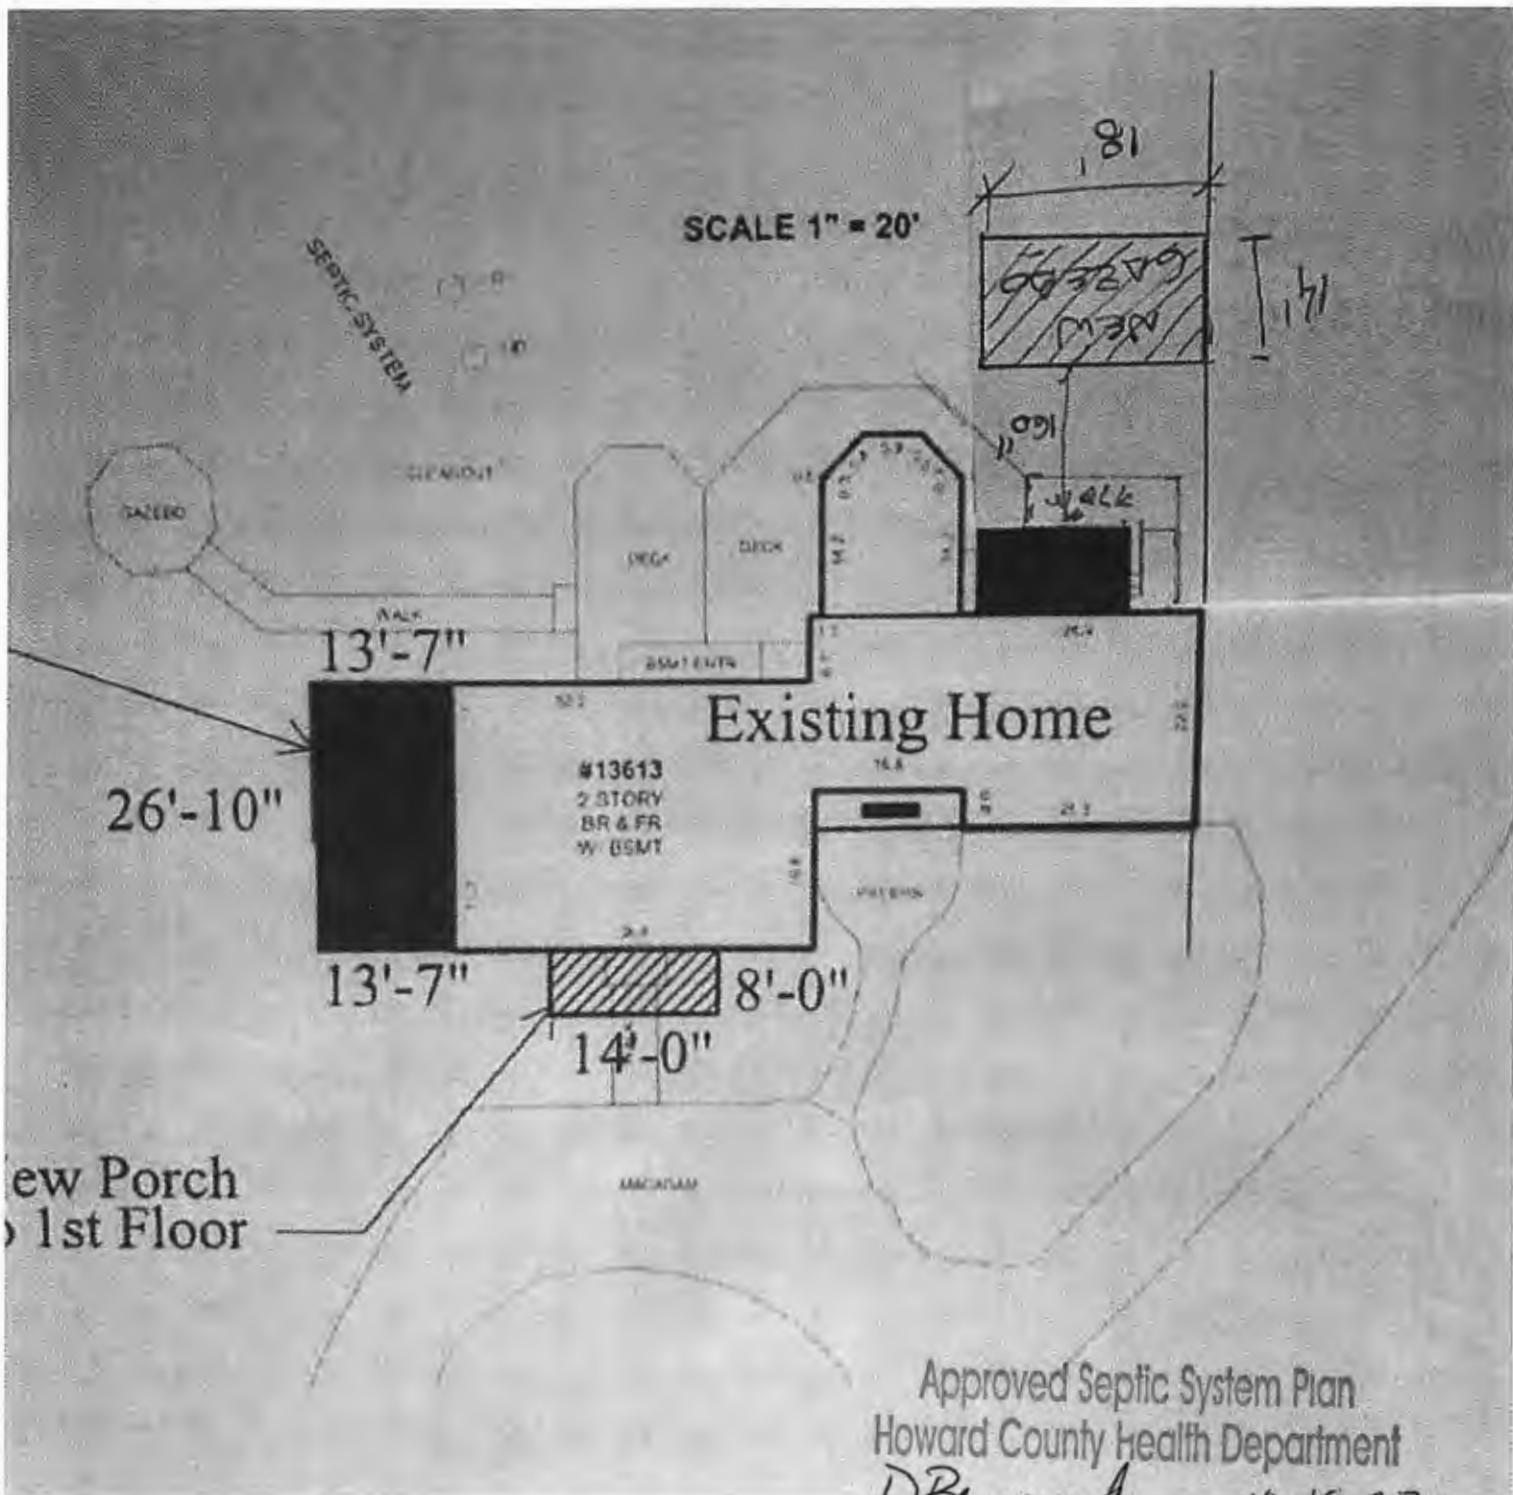

New Porch
1st Floor

Approved Septic System Plan
 Howard County Health Department
D. Bernard
 Signature 10-18-23
 Date