

Record Detail (This section is required.)

Permit Type	Permit Number	Opened Date
Building/Residential/Misc/Deck	B23003646	09/06/2023
Description of Work		
SFD/ CONSTRUCT 38 X 22 IRREGULAR SHAPED DECK WITH STEPS		

[check spelling](#)

Address (This section is required.)

Search Reset Clear Get Parcel & Owner

Street #	Street Name	Street Type
11104	DORSCH FARM	RD
Unit Type	Unit #	X Coordinate
--Select--		-76.89429
		Y Coordinate
		39.25051
City	State	Zip Code
ELLCOTT CITY	MD	21042
	Primary	
	Yes	

Parcel (This section is required.)

Search Reset Clear Get Address & Owner

GIS ID	Parcel	Parcel Area	Land Value	Improved Value	Exemption Value	Plan Area
885165	21	1.03	160300	482700	322400	RURAL
Legal Description						
IMPSLOT 46 1.038 A[]11104 DORSCH FARM RD[]GAITHER HUNT S1 A2 RSB						

[check spelling](#)

Block	Lot	Census Tract	Council Dist	Inspection Dist	Supervisor Dist	Map #	DAP Zone
9999	46	603000	5				
Plan Area	State Tax Id	Subdivision Name					
	1403327590						
Section	Area	Tax Map					
		23					
Grid	Zoning District	ADC Map					
23-22	RC-DEO	4814-G10					
SDP No.	Final Plan No.	WP File No.					
Record Plat No.	WS Contract No.	FDP No.	Primary				
13488			Yes				
Owner Occupied	Year Built	Historic District					
<input type="radio"/> Yes <input type="radio"/> No	2000	<input type="radio"/> Yes <input checked="" type="radio"/> No					
Historic District Registry No.	Stat Area	Flood Plain					
	3-09A	<input type="radio"/> Yes <input checked="" type="radio"/> No					
Building No							

Owner (This section is required.)

Search Reset Clear

Name

JACKSON KEVIN M

Address Line 1

11104 DORSCH FARM RD

Address Line 2

Address Line 3

Mail City

ELLCOTT CITY

Phone

410-549-5050

E-mail

Mail State

MD

Mail Zip Code

21042

Primary

Yes

Cell Number Fax Number

Professionals (This section is not required.)

License # 08010083116
 License Type MHIC Ind
 Primary Yes

Business Name CLASSIC DESIGN GROUP INC

First Name LUIS Middle Name Last Name BALDERRAMA

Address Line 1 5433 WOODBINE ROAD
 Address Line 2 5433 WOODBINE ROAD

City WOODBINE State MD ZIP Code 21797-0000

Phone 1 3014402640 Phone 2 Fax 4105495449

E-mail LUISBALMEN@HOTMAIL.COM

Applicant (This section is not required.)

Search As Owner As Lic. Prof As Contact

Type Applicant Relationship Applicant Primary Yes

First Name PETER MI Last Name SORGE

Full Name PETER SORGE

Organization Name CLASSIC DESIGN GROUP INC

Street Address 5433 WOODBINE RD
 Address Line 2

City WOODBINE State MD Zip Code 21797

Phone 410-549-5050 Cell 240-375-4658 Fax 410-549-5449

E-mail PSORGE28@GMAIL.COM

Addtl Info

Est Construction Cost 36450 Housing Units 0 Number of Buildings 0 Public Owned No

Construction Type 434 - Additions, Alterations and Conversions - Residential

MISC PERMIT INFO

MISCELLANEOUS PERMIT INFORMATION

Capital Project-No Fee Capital Project Number Fee Exempt Roadside Tree Project Permit Roadside Tree Project Permit #

Yes No Yes No Yes No

Existing Use Water Sewage Expiration Date

SFD Private Private 3/12/2024

Submit Cancel

JAMDA	From J.M.E.
AN	Co. CFS, INC.
WALTER HUNT	Phone # SCALE
LOT 46	1" = 40'

Approved Septic System Plan
 Howard County Health Department
 45,222

LOT 45
 49,200

Ann M. Well 7/5/99
 Date

Dist Box
 Ex Grd 481.6
 Inv. = 478.6


Total linear feet of trench
 required **240 feet**

Width of trench (as)
 SEPTIC EASEMENT
 1250 Gal Septic Tank
 Inv. In = 479.0

Depth of trench (as) **50 feet**
 Inv. Out = 478.7

Depth of stone required below
 distribution pipe **2.0 feet**

OT 47
 3,122

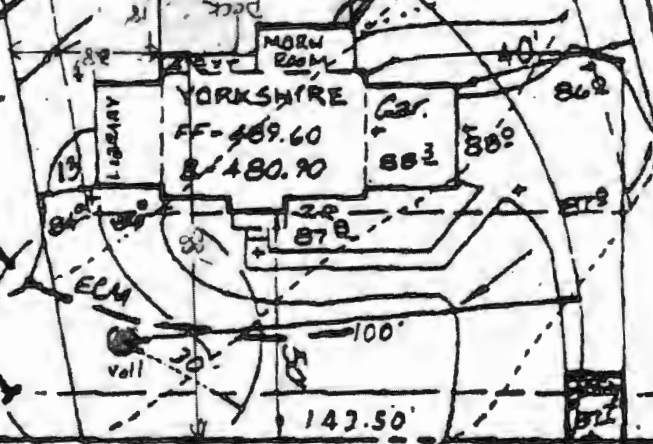

EASEMENT, WILL NOT
 SEWER BY GRAVITY

Slip Tree
 Inance
 ment