

03-290530

Menu Save Reset Cancel Help

Record Detail * (This section is required.)

Permit Type Building/Residential/Misc/Tanks Permit Number B21001402 Opened Date 04/24/2021

Description of Work SFD/Removing 1 500 Gallon Oil Tank Right side of house. Installing 1 275 Gallon tank left rear of house under deck

check spelling

Address * (This section is required.)

Search Reset Clear Get Parcel & Owner

Street # 13236 Street Name TRIADELPHIA Street Type RD
Unit Type Unit # X Coordinate Y Coordinate
City ELLICOTT CITY State MD Zip Code 21042 Primary Yes

Approved 4/29/21 [Signature]

Parcel * (This section is required.)

Search Reset Clear Get Address & Owner

GIS ID 910686 Parcel 246 Parcel Area 5.24 Land Value 228300 Improved Value 510700 Exemption Value 284400 Plan Area RURAL

Legal Description IMPS5 240 AR [13236 TRIADELPHIA RD NWS] ELLICOTT CITY

check spelling

Block Lot Census Tract Council Dist Inspection Dist Supervisor Dist Map # DAP Zone
Plan Area State Tax Id Subdivision Name
Section Area Tax Map
Grid Zoning District ADC Map
SDP No. Final Plan No. WP File No.
Record Plat No. WS Contract No. FDP No. Primary
Owner Occupied Year Built Historic District
Historic District Registry No. Stat Area Flood Plain
Building No

Owner * (This section is required.)

Search Reset Clear

Name BRADY BETH REED
Address Line 1 13236 TRIADELPHIA RD
Address Line 2
Address Line 3
Mail City ELLICOTT CITY Mail State MD Mail Zip Code 21042
Phone 240-820-8086 Primary
E-mail reedbrady@hotmail.com
Cell Number Fax Number

Professionals (This section is not required.)

Search Reset Clear

License # *	Business Name		
20020008045	CARROLL HOME SERVICES		
License Type *	First Name	Middle Name	Last Name
Plumb/Gas	DANIEL		MARSHALL
Primary	Address Line 1		
Yes	2700 LOCH RAVEN RD., SUITE 200		
	Address Line 2		
	City	State	ZIP Code
	BALTIMORE	MD	21218-0000
	Phone 1	Phone 2	Fax
	4434637036		
	E-mail		
	DMARSHALL@CARROLLHOMESERVICES.COM		

Applicant (This section is not required.)

Search As Owner As Lic. Prof As Contact

Type *	First Name	MI	Last Name
Applicant	John		Mazura
Relationship	Full Name		
Applicant	John Mazura		
Primary	Organization Name		
Yes	Carrollhomeservices.com		
	Street Address		
	1105 Camberley Ct		
	Address Line 2		
	City	State	Zip Code
	ABINGDON	MD	21009
	Phone	Cell	Fax
	410-937-5882		
	E-mail *		
	jmazura@carrollhomeservices.com		

Addtl Info

Est Construction Cost *	Housing Units *	Number of Buildings *	Public Owned
2515	0	0	No
Construction Type			
--Select--			

TANK INFORMATION


RESIDENTIAL TANK INFORMATION

Capital Project-No Fee *	Capital Project Number	Fee Exempt *	Roadside Tree Project Permit *	Roadside Tree Permit #
<input type="radio"/> Yes <input checked="" type="radio"/> No		<input type="radio"/> Yes <input checked="" type="radio"/> No	<input type="radio"/> Yes <input checked="" type="radio"/> No	
Existing Use	Number of Tanks Installed *	Number of Tanks Removed *		
SFD	1	1		
Water Supply	Sewage Disposal	Expiration Date	Relocate Existing Tank *	
Private	Private	10/26/2021	0	

PAYMENT INFORMATION

Check 1	Payee 1	Check 2	Payee 2	SAP Doc No	SAP Entered

Submit Cancel

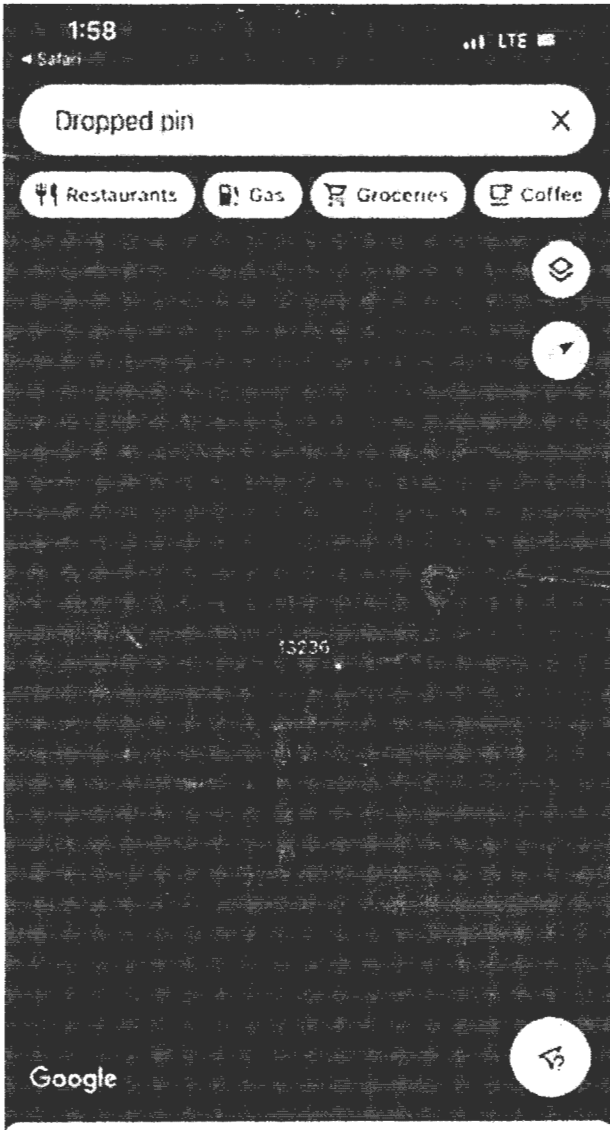

500 GAL TANK
TO BE REMOVED

Dropped pin

New 13236 Providence Rd, Detroit, MI 48242

- Directions
- Label
- Share
- Download

Dylan Oehlke
Residential Equipment Specialist
Carroll Home Services
Mobile (443) 974 8153
Work (410) 365 7628