

Approved 228.23  
-H.O.

Record Detail \* (This section is required.)

Permit Type	Permit Number	Opened Date
Building/Residential/Misc/Pool Spa	B23000503	02/15/2023
Description of Work		
SFD/INSTALL 40' X 20' Inground concrete Swimming Pool and 12' X 10' Spa, WITH FENCE TO CODE		

[check spelling](#)

Address \* (This section is required.)

Search Reset Clear Get Parcel & Owner

Street #	Street Name	Street Type	
14261	TRIADELPHIA MILL	RD	
Unit Type	Unit #	X Coordinate	Y Coordinate
--Select--		-77.00981	39.2253
City	State	Zip Code	Primary
DAYTON	MD	21036	Yes

Parcel \* (This section is required.)

Search Reset Clear Get Address & Owner

GIS ID *	Parcel	Parcel Area	Land Value	Improved Value	Exemption Value	Plan Area
918452	15	8.32	324900	0	1028000	RURAL
Legal Description						
IMPVPAR A 8.32 A BUILDAB[ ]14261 TRIADELPHIA MILL[ ]TRIADELPHIA MILL ROAD PR						

[check spelling](#)

Block	Lot	Census Tract	Council Dist	Inspection Dist	Supervisor Dist	Map #	DAP Zone
24	PAR A	605101	5				
Plan Area		State Tax Id	Subdivision Name				
		1405440637	TRIADELPHIA MILL ROAD PF				
Section		Area	Tax Map				
			27				
Grid		Zoning District	ADC Map				
27-24		RR-DEO	4932-J4				
SDP No.		Final Plan No.	WP File No.				
		F-04-032					
Record Plat No.		WS Contract No.	FDP No.	Primary			
18054-1805				Yes			
Owner Occupied		Year Built	Historic District				
<input type="radio"/> Yes <input type="radio"/> No		2009	<input type="radio"/> Yes <input checked="" type="radio"/> No				
Historic District Registry No.		Stat Area	Flood Plain				
		5-01	<input type="radio"/> Yes <input checked="" type="radio"/> No				
Building No							

Owner \* (This section is required.)

Search Reset Clear

Name \*

SANDHU AMARJEET SINGH

Address Line 1

14261 TRIADELPHIA MILL RD

Address Line 2

Address Line 3

Mail City	Mail State	Mail Zip Code
DAYTON	MD	21036
Phone	Primary	
443-878-3880	Yes	
E-mail		
Cell Number	Fax Number	

**Professionals** (This section is not required.)

**License # \***  
08050137890

**Business Name**  
PREMIER POOLS AND SPAS

**License Type \***  
MHIC Co

**Primary**  
No

**First Name**  
ANDREW

**Middle Name**

**Last Name**  
SANCOMB

**Address Line 1**  
13775 ROVER MILL ROAD

**Address Line 2**

**City**  
FRIENDSHIP

**State**  
MD

**ZIP Code**  
21794-0000

**Phone 1**  
3013439123

**Phone 2**

**Fax**

**E-mail \***  
ASANCOMB@PPAS.COM

**Applicant** (This section is not required.)

**Search**    **As Owner**    **As Lic. Prof**    **As Contact**

**Type \***  
Applicant

**Relationship**  
Applicant

**Primary**  
Yes

**First Name**  
Garrett

**MI**

**Last Name**  
Sancomb

**Full Name**

**Organization Name**

**Street Address**  
7439 Springfield ave

**Address Line 2**

**City**  
Sykesville

**State**  
MD

**Zip Code**  
21784

**Phone**  
443-878-3880

**Cell**

**Fax**

**E-mail \***  
gsancomb@ppas.com

**Addtl Info**

**Est Construction Cost \***  
150000

**Housing Units \***  
0

**Number of Buildings \***  
0

**Public Owned**  
No

**Construction Type**  
649 - All Other Buildings and Structures

**POOL INFORMATION**

MISCELLANEOUS POOL INFORMATION

**Capital Project-No Fee \***  
 Yes  No

**Capital Project Number**

**Fee Exempt \***  
 Yes  No

**Water Supply \***  
Private

**Sewage Disposal \***  
Private

**Existing Use \***  
SFD


**Type of Pool or Spa \***  
In Ground Pool and Hot Tub

**Pool Safety Device \***  
Fence

**Electrical Permit Number**

**Expiration Date**  
8/26/2023

**Submit**    **Cancel**

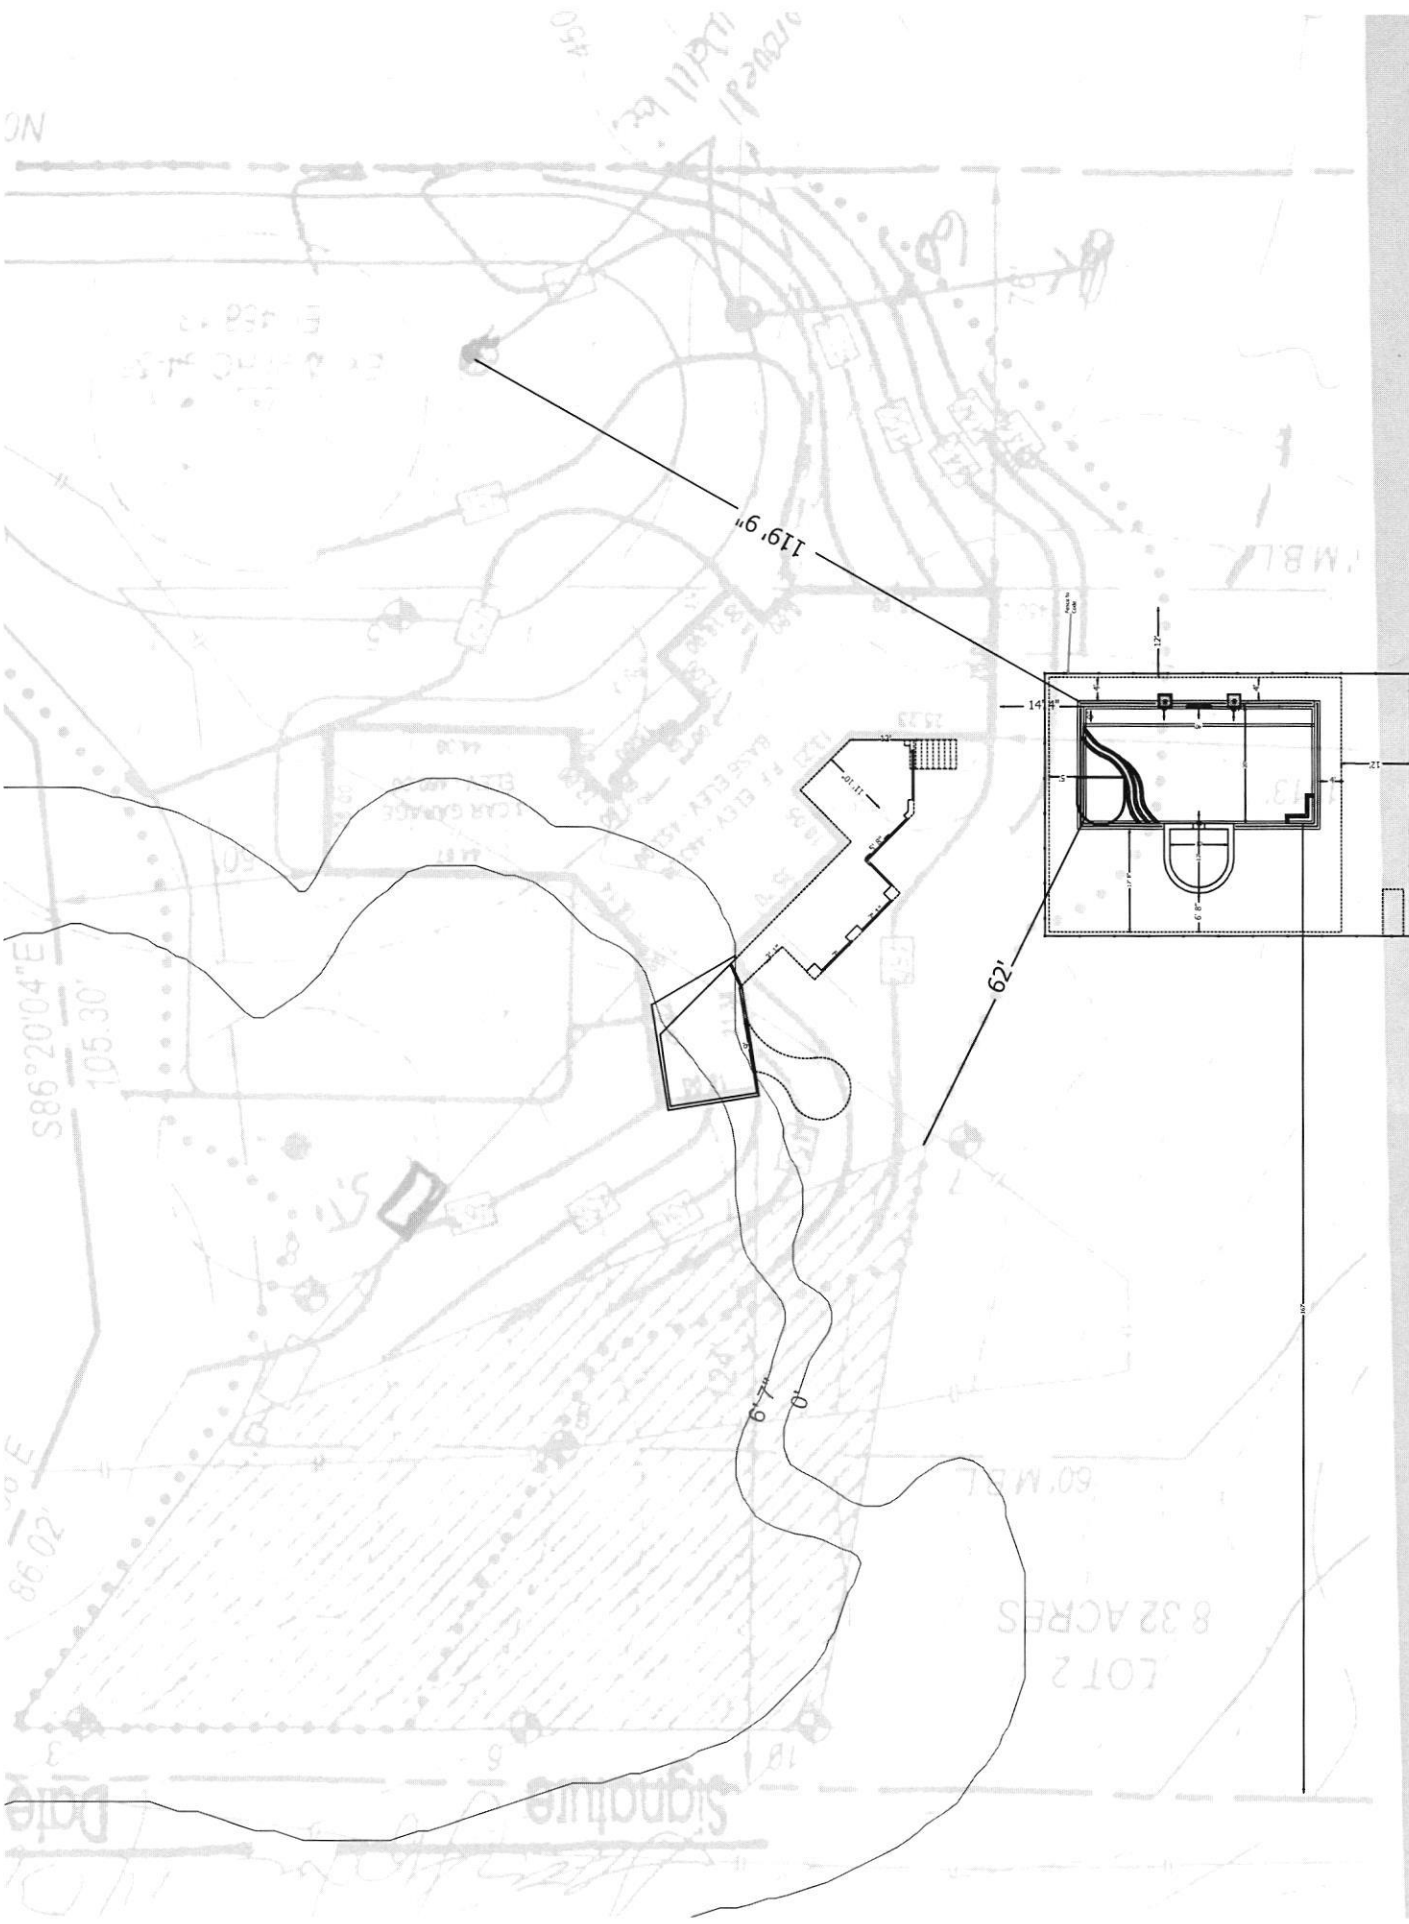

Scale: 1/32" = 1 ft

Date \_\_\_\_\_ Signature \_\_\_\_\_