

1/22/76
~~Approved~~ file OK WWB

PERMIT

P 22744

SEWAGE DISPOSAL SYSTEM

A _____

MARYLAND STATE DEPARTMENT OF HEALTH

HOWARD COUNTY

ELLICOTT CITY

INDEXED

DISTRICT 2

DATE 1/21/76

Jack Fyock IS PERMITTED TO INSTALL ALTER X

ADDRESS Ten Oaks Road, Dayton, Maryland PHONE 286-2939

A SEWAGE DISPOSAL SYSTEM LOCATED AT _____

SUBDIVISION Allenford ROAD ¹⁰²²⁶ Doliter Court LOT 6, Blk. B, Sec. 1

PROPERTY OWNER ~~Douglas Lichter~~ Charles K. Clopein

ADDRESS _____

SPECIFICATIONS

DRAIN FIELD _____ DEPTH _____ FEET, BOTTOM AREA _____ SQ. FT.

SEEPAGE PITS _____ ABSORBENT SIDE-WALL AREA _____ SQ. FT.

SEPTIC TANK CAPACITY _____ GALLONS

FOR GARBAGE GRINDER, INCREASE DISPOSAL AREA 22% & TANK CAPACITY 50%.

OTHER REPAIR - Call for inspection before ground is opened up so Sanitarian can

recommend repair system.

Hard ground starts @ 5 1/2' as per J. Fyock


PLANS APPROVED BY P. F. Wine DATE 1/21/76

FILL SEPTIC TANK AND DISTRIBUTION BOX WITH WATER BEFORE CALLING FOR AN INSPECTION. COVER NO WORK UNTIL INSPECTED AND APPROVED.

NEITHER THE HOWARD COUNTY COMMISSIONERS NOR THE HEALTH DEPARTMENT IS RESPONSIBLE FOR THE SUCCESSFUL OPERATION OF ANY SYSTEM.

REG. PERMIT SIGNER
AND RETURNED 3/29/76
Serial # 17326 - Pml

X 183774

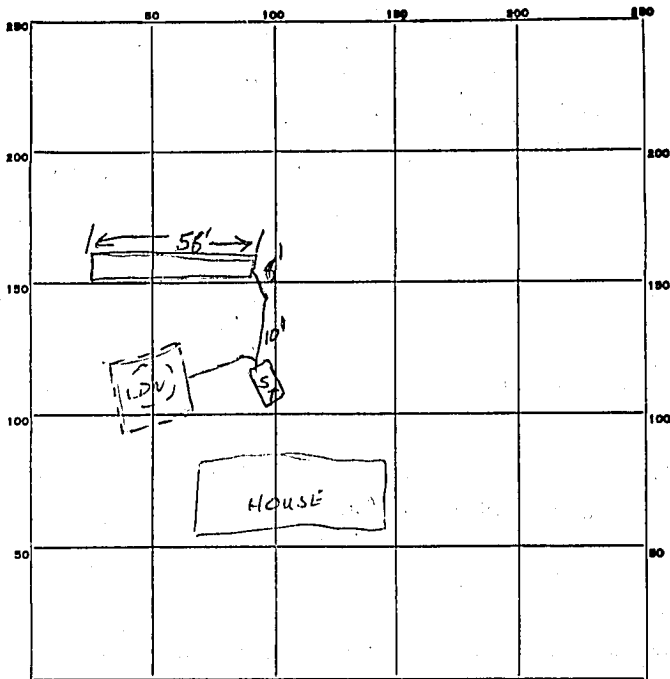

INDICATE NORTH. -- NAME ADJOINING ROADWAY AS BASE LINE.

10220

58
8
464

PERMIT CARD

SEPTIC TANK, LEVEL existing

CLEANOUTS existing

DISTRIBUTION BOX, LEVEL _____

TILE FIELD, DEPTH _____ FT. TRENCH WIDTH 2 1/2 FT.

GRAVEL DEPTH 8 FT. TOTAL LENGTH 58 FT.

NUMBER OF TRENCHES 1 SIDEWALL TOTAL-BOTTOM AREA 464 \square
EFF " " " 406 \square (below 5 1/2' clay barrier)

12-13' gravel to top
4 1/2'

SEEPAGE PITS, INSIDE DIAMETER _____ FT. DEPTH BELOW INLET _____ FT.

ABSORBENT AREA _____ SQ. FT.

REMARKS 1/22/76 Wanted sand 12 to 13 feet. I agree with the job which was done.

Mr. (Charles) K. Clapp

Ditch complete when I arrived @ 12:15. Owner signed above.

Orangeburg pipe used for ST (same as orig.)

DATE SYSTEM APPROVED 1/22/76

INSPECTOR William J. Zapp