

Record Detail * (This section is required.)

Permit Type	Permit Number	Opened Date
Building/Residential/Misc/Pool Spa	B22000077	01/12/2022
Description of Work		
40'X20' INGROOUND CONCRETE POOL, FILLED BY TRUCK, AUTO COVER, DEPTH 3 1/2' TO 6'		

[check spelling](#)

Address * (This section is required.)

Search Reset Clear Get Parcel & Owner

Street #	Street Name	Street Type
3625	BLACK WALNUT	LN
Unit Type	Unit #	X Coordinate
-Select-		-77.03777
		Y Coordinate
		39.26252
City	State	Zip Code
GLENWOOD	MD	21738
		Primary
		Yes

OK
reB
2/16/2022
B22000077

Parcel * (This section is required.)

Search Reset Clear Get Address & Owner

GIS ID *	Parcel	Parcel Area	Land Value	Improved Value	Exemption Value	Plan Area
890164	26	4.31	234800	1030700	795900	RURAL
Legal Description						
IMPSLOT 1 4.313 A[]3625 BLACK WALNUT LN[]CATTAIL CREEK OVERLOOK						

[check spelling](#)

Block	Lot	Census Tract	Council Dist	Inspection Dist	Supervisor Dist	Map #	DAP Zone
	1	605601	5				
Plan Area	State Tax Id	Subdivision Name					
	1404352211	CATTAIL CREEK OVERLOOK					
Section	Area	Tax Map					
		21					
Grid	Zoning District	ADC Map					
21-15	RC-DEO	4812-D9					
SDP No.	Final Plan No.	WP File No.					
Record Plat No.	WS Contract No.	FDP No.	Primary				
9793-9794			Yes				
Owner Occupied	Year Built	Historic District					
<input type="radio"/> Yes <input type="radio"/> No	1996	<input type="radio"/> Yes <input checked="" type="radio"/> No					
Historic District Registry No.	Stat Area	Flood Plain					
	4-09	<input type="radio"/> Yes <input checked="" type="radio"/> No					
Building No							

Owner * (This section is required.)

Search Reset Clear

Name *

MICHELLE WALKER

Address Line 1

3625 BLACK WALNUT LN

Address Line 2

Address Line 3

Mail City	Mail State	Mail Zip Code
GLENWOOD	MD	21738
Phone	Primary	
443-603-7667	Yes	

E-mail

Cell Number Fax Number

Professionals (This section is not required.)

Search Reset Clear

License # * 08010023797 Business Name STEVENSON CONSTRUCTION COMPANY INC
License Type * MHIC Ind Primary Yes
First Name DOUGLAS Middle Name Last Name STEVENSON
Address Line 1 1925 NORFOLK DRIVE
Address Line 2
City OWINGS State MD ZIP Code 20736-0000
Phone 1 3018556512 Phone 2 Fax 3018557068
E-mail JROMANO@STEVENSONPOOLS.COM

Applicant (This section is not required.)

Search As Owner As Lic. Prof As Contact

Type * Applicant Relationship Agent for Applicant Primary Yes
First Name KAREN MI H Last Name ROWLEY
Full Name KAREN H ROWLEY
Organization Name KH & K
Street Address 293 SOUTHLAND COURT
Address Line 2
City DUNKIRK State MD Zip Code 20754
Phone 410-507-7705 Cell Fax
E-mail * KHKPERMITS05@YAHOO.COM

Handwritten notes: 'OK' 2/16/2022, B22000077, 3225 Black Walnut Ln.

Addtl Info

Est Construction Cost * 70000 Housing Units * 0 Number of Buildings * 0 Public Owned No
Construction Type --Select--

POOL INFORMATION

MISCELLANEOUS POOL INFORMATION

Capital Project-No Fee * Yes No Capital Project Number Fee Exempt * Yes No Water Supply * Private Sewage Disposal * Private
Existing Use SFD Type of Pool or Spa * In Ground Pool Electrical Permit Number Expiration Date 7/12/2022


PAYMENT INFORMATION

Check 1 Payee 1 SAP Doc No SAP Entered

Related Records

Showing 1-2 of 2

Table with 7 columns: Permit Number, Record Type Alias, Status, Number, Street Name, Opened Date, Description. Contains two rows of permit records.

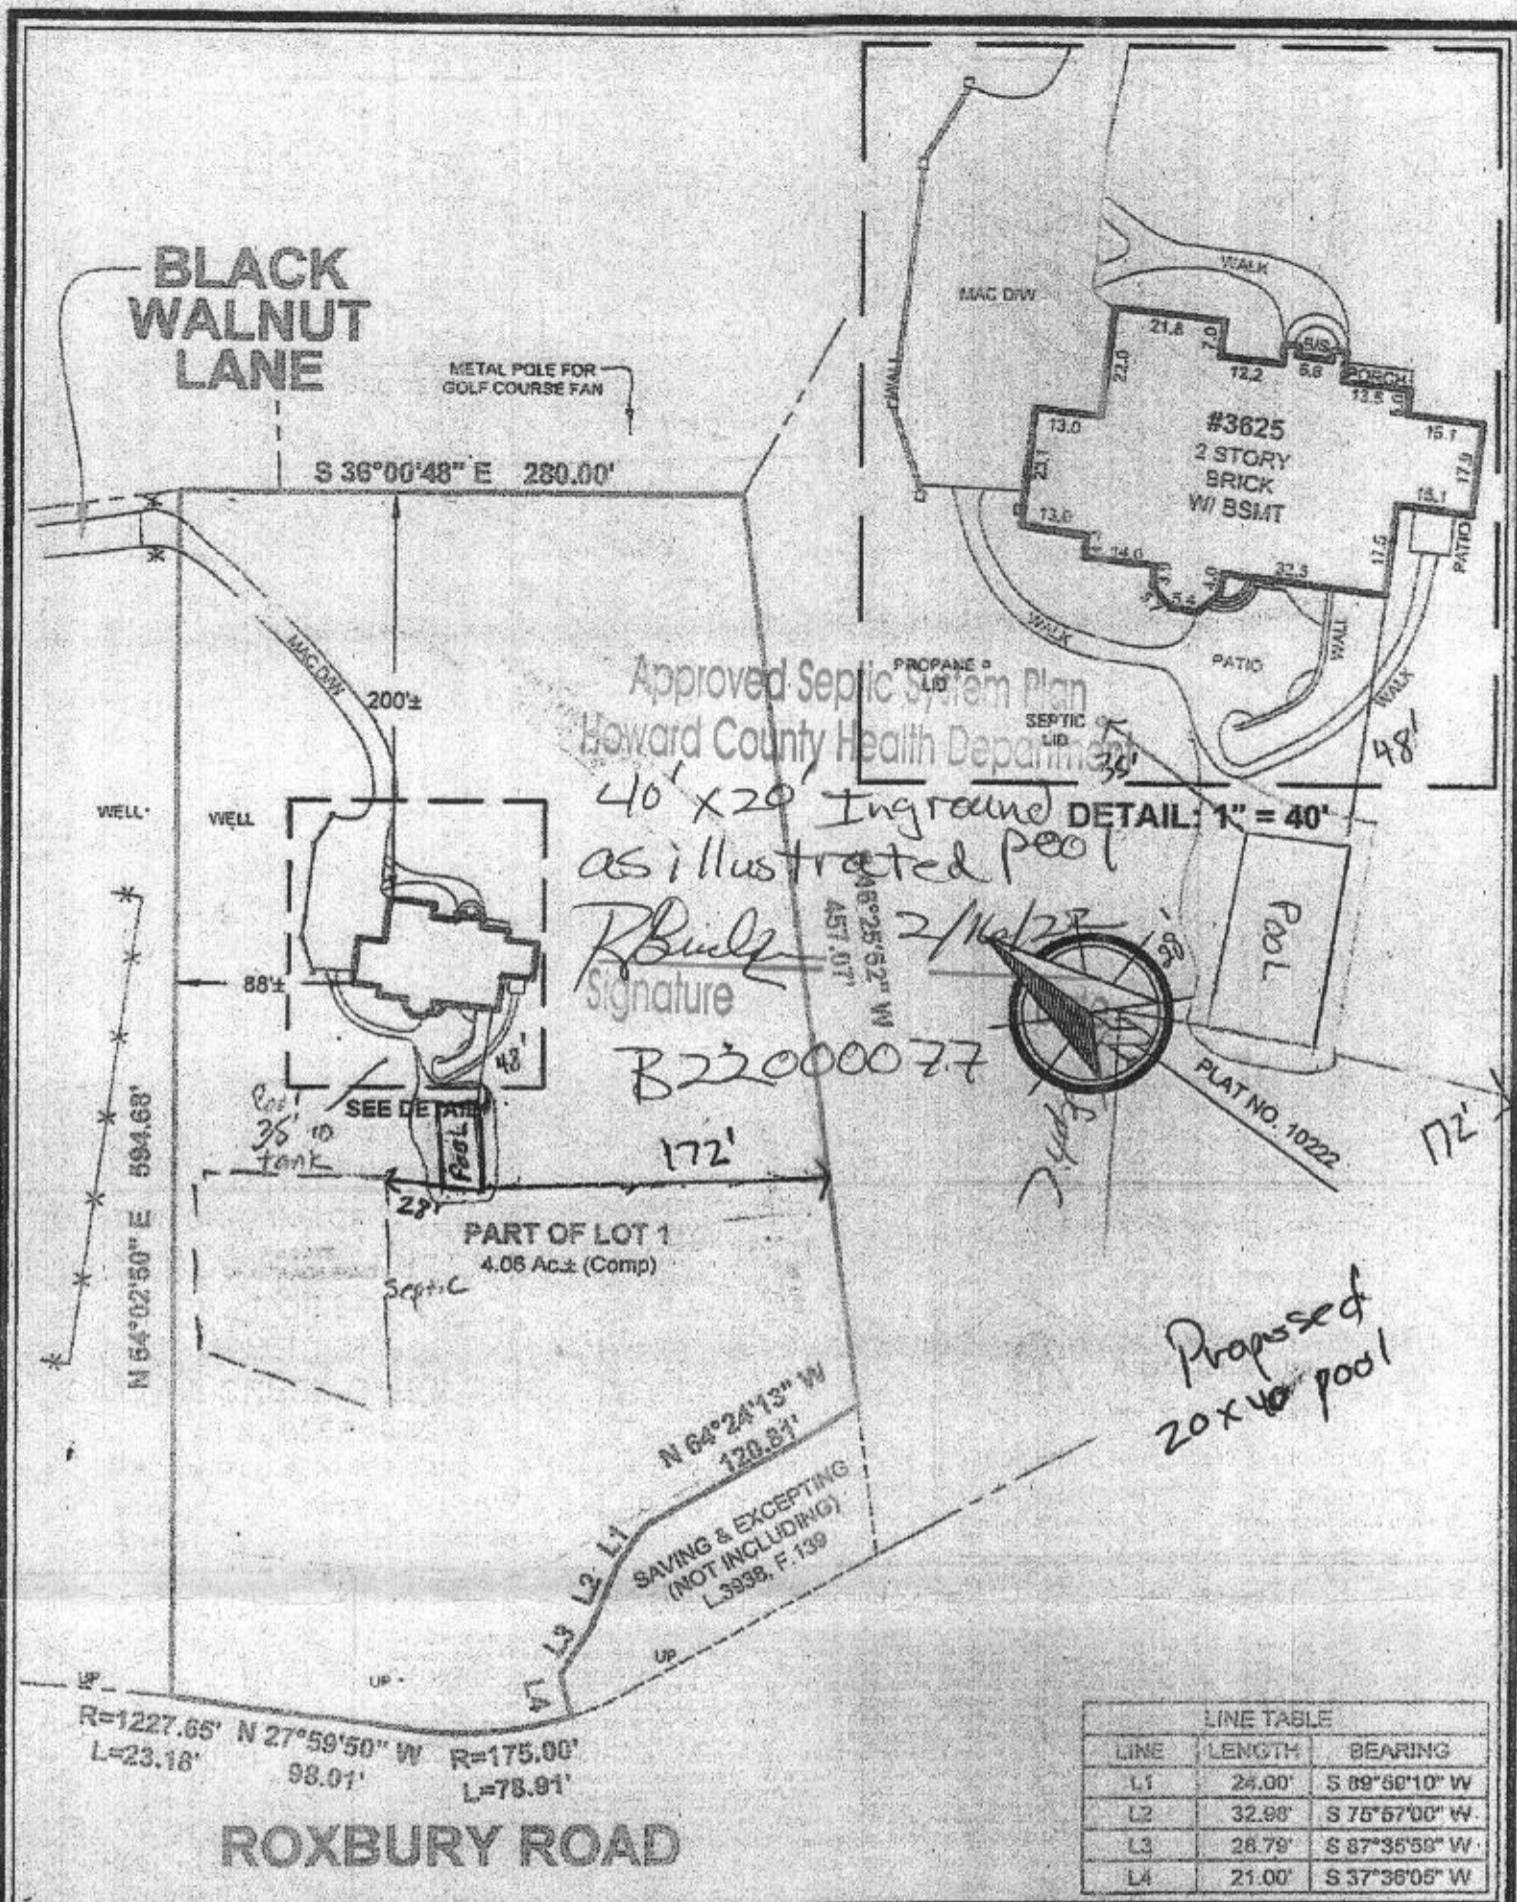

LOCATION DRAWING OF:
#3625 BLACK WALNUT LANE
PART OF LOT 1
 SHEET 1 OF 1
CATTAIL CREEK OVERLOOK
 PLAT NUMBER 10222
 HOWARD COUNTY, MARYLAND
 SCALE: 1"=100' DATE: 11-08-2021
 DRAWN BY: CP FILE #: 217302-200

LEGEND:

- X- FENCE
- BE - BASEMENT ENTRANCE
- BW - BAY WINDOW
- BR - BRICK
- BSL - BLDG. RESTRICTION LINE
- BSMT - BASEMENT
- BS - BRICK STOVE
- CONC - CONCRETE
- DRV - DRIVEWAY
- EX - EXISTING
- FR - FRAME
- MAC - MACADAM
- G - GATE
- OH - OVERHANG
- PLU - PUBLIC UTILITY ENRT.
- UP - UTILITY POLE

COLOR KEY:

- (RED) - RECORD INFORMATION
- (BLUE) - IMPROVEMENTS

A Land Surveying Company

DULEY
and
Associates, Inc.

Serving D.C. and MD.

14604 Elm Street, Upper Marlboro, MD 20772

Phone: 301-888-1111 Fax: 301-888-1114
 Email: orders@duley.biz On the web: www.duley.biz



SURVEYOR'S CERTIFICATE

I HEREBY STATE THAT I WAS IN RESPONSIBLE CHARGE OVER THE PREPARATION OF THIS DRAWING AND THE SURVEY WORK REFLECTED HEREIN AND IT IS IN COMPLIANCE WITH THE REQUIREMENTS SET FORTH IN REGULATION 12 CHAPTER 08.13.06 OF THE CODE OF MARYLAND ANNOTATED REGULATIONS. THIS SURVEY IS NOT TO BE USED OR RELIED UPON FOR THE ESTABLISHMENT OF FENCES, BUILDING, OR OTHER IMPROVEMENTS. THIS PLAT DOES NOT PROVIDE FOR THE ACCURATE IDENTIFICATION OF PROPERTY BOUNDARY LINES, BUT SUCH IDENTIFICATION MAY NOT BE REQUIRED FOR THE TRANSFER OF TITLE OR SECURING FINANCING OR REFINANCING. THIS PLAT IS OF BENEFIT TO A CONSUMER ONLY INsofar AS IT IS REQUIRED BY A LENDER OR A TITLE INSURANCE COMPANY OR ITS AGENTS IN CONNECTION WITH THE CONTEMPLATED TRANSFER, FINANCING OR REFINANCING. THE LEVEL OF ACCURACY FOR THIS DRAWING IS 1". NO TITLE REPORT WAS FURNISHED TO NDR DONE BY THIS COMPANY. SAID PROPERTY SUBJECT TO ALL NOTES, RESTRICTIONS AND EASEMENTS OF RECORD. BUILDING RESTRICTION LINES AND EASEMENTS MAY NOT BE SHOWN ON THIS SURVEY. IMPROVEMENTS WHICH IN THE SURVEYOR'S OPINION APPEAR TO BE IN A STATE OF DISREPAIR OR MAY BE CONSIDERED "TEMPORARY" MAY NOT BE SHOWN. IF IT APPEARS ENCROACHMENTS MAY EXIST, A BOUNDARY SURVEY IS RECOMMENDED.

DULEY & ASSOC.
 WILL GIVE YOU A 100%
 FULL CREDIT TOWARDS
 UPGRADING THIS
 SURVEY TO A
 "BOUNDARY/STAKE"
 SURVEY FOR ONE
 YEAR FROM THE DATE
 OF THIS SURVEY
 (EXCLUDING D.C. & BALT CITY)