

RECEIVED

PERMIT NUMBER: B

20004575

DATE ACCEPTED:

DEC 28 2020

LICENSES & PERMITS DIVISION

RESIDENTIAL BUILDING PERMIT APPLICATION

HOWARD COUNTY DEPARTMENT OF INSPECTIONS, LICENSES, AND PERMITS

3430 COURT HOUSE DRIVE, ELLICOTT CITY, MD 21043 - PHONE: (410) 313-2455 OPTION #4

www.howardcountymd.gov

BUILDING SITE ADDRESS REQUIRED

Street Address: 13846 Mill Creek Ct
City: Clarksville
State: MD
Subdivision/Village/Complex Name:
Lot: 8
Tax Map: 0034
Parcel: 05-600766
Grading Permit #:
Unit:
Zip Code: 21029
SDP/WP/BA #:

DESCRIPTION OF WORK REQUIRED

Existing Use: None
Proposed Use: Finished Basement
Estimated Cost: \$15,000.00
Trade Work to Be Completed (Separate Permits Required):
SFD/Finished basement to include: wet bar, full bath and recreation room with existing windows and door. The mechanical/laundry room, storage area will remained unfinished. The approximately 1905 sq ft total area of construction. See the attached floorplan for the details.

PROPERTY OWNER INFORMATION REQUIRED

Owner(s) Name(s) (As it appears on tax records): Anjum Dahya
Primary Residence: Yes
Owner's Street Address: 13846 Mill Creek Ct
City: Clarksville
State: MD
Phone: (240) 593-7298
Email: akil.dahya@gmail.com

APPLICANT NAME REQUIRED - INDIVIDUAL WHO SIGNS THIS APPLICATION

Business Name:
Contact Name: Anjum Dahya
Street Address: 13846 Mill Creek Ct
City: Clarksville
State: MD
Phone: (240) 593-7298
Email: akil.dahya@gmail.com

CONTRACTOR INFORMATION REQUIRED

Business Name: N/A - Self Constructing
Licensee's Name:
License #:
Street Address:
City:
State:
Zip Code:
Phone:
Email:

ARCHITECT/ENGINEER INFORMATION INDIVIDUAL WHO SIGNED PLANS, IF APPLICABLE

Business Name: N/A
Name:
Street Address:
City:
State:
Zip Code:
Phone:
Email:

BUILDING CHARACTERISTICS REQUIRED

Primary Structure: SF Dwelling
Utilities: Electric, Gas
Water Supply: Public, Private (Well)
Sewage Disposal: Public, Private (Septic)
Heating System: Electric, Natural Gas, Propane, Other
Roadside Tree Project: No, Yes
Sprinkler System: NFPA 13, NFPA 13R, NFPA 13D, None
Fire Alarm System: Yes, No, Voice Evac

ADDITIONAL RESIDENTIAL INFORMATION (PLEASE SELECT/COMPLETE ALL THAT APPLY)

Model Name & Options:
# of Bedrooms (SF):
# of efficiency units (MF\*):
# of 1 BR (MF\*):
# of 2 BR (MF\*):
# of 3 BR (MF\*):
# Rooms:
# Full Baths:
# Half Baths:
# Fireplaces:
Garage/Carport Info: Attached Garage, Detached Garage, Integral Garage, Carport, None
Basement/Foundation Info: Slab on Grade, Post & Pier, Unfinished Basement, Finished Basement: Full or Partial
1st Fl Width:
1st Fl Depth:
2nd Fl Width:
2nd Fl Depth:
Bsmt Width:
Bsmt Depth:
Energy Method: Prescriptive, Performance, UA Alternative, ERI
Gross Area: sq ft
Occupiable Area: sq ft

AGREEMENT/ DISCALIMER REQUIRED

THE UNDERSIGNED HEREBY CERTIFIES AND AGREES AS FOLLOWS: (1) THAT HE/SHE IS AUTHORIZED TO MAKE THIS APPLICATION; (2) THAT THE INFORMATION IS CORRECT; (3) THAT HE/SHE WILL COMPLY WITH ALL REGULATIONS OF HOWARD COUNTY WHICH ARE APPLICABLE THERETO; (4) THAT HE/SHE WILL PERFORM NO WORK ON THE ABOVE REFERENCED PROPERTY NOT SPECIFICALLY DESCRIBED IN THIS APPLICATION; (5) THAT HE/SHE GRANTS COUNTY OFFICIALS THE RIGHT TO ENTER ONTO THIS PROPERTY FOR THE PURPOSE OF INSPECTING THE WORK PERMITTED AND POSTING NOTICES.

Applicant's Original Signature


DATE SIGNED 12/28/2020

FOR OFFICE USE ONLY

CHECKS PAYABLE TO: DIRECTOR OF FINANCE OF HOWARD COUNTY

AGENCIES REQUIRED/APPROVALS:
PR, DPZ, DED, Health, SHA, CID
SUBMITTAL FEES:
PAYMENT:
ACCEPTED BY:


# LOWER LEVEL FLOOR PLAN

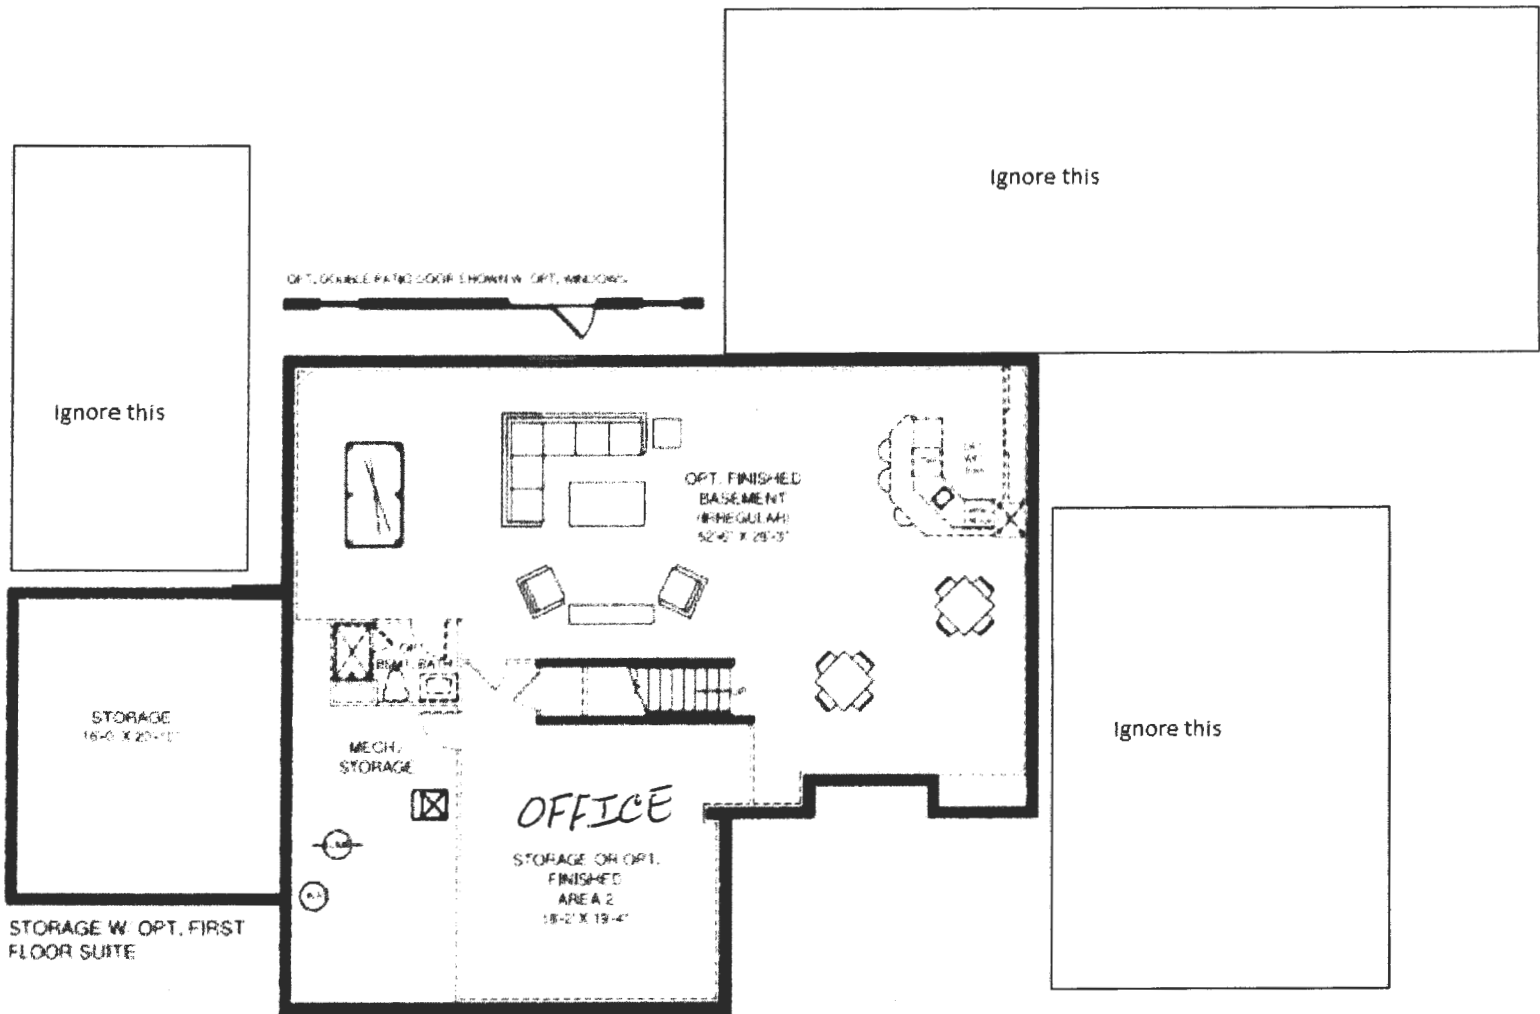

- Existing Unfinished floorplan of basement.
- The drawing is provided by builder.
- The whole area is unfinished. The kitchen & bathroom is shown as an optional.

Approved Septic System Plan  
 Howard County Health Department  
*Dave Beard* 2-8-21  
 Signature Date  
 B 2000 4515

Currently bathroom and kitchen is not built as seen in layout. It is shown as option from builder. Optional Patio door and window is installed by builder.

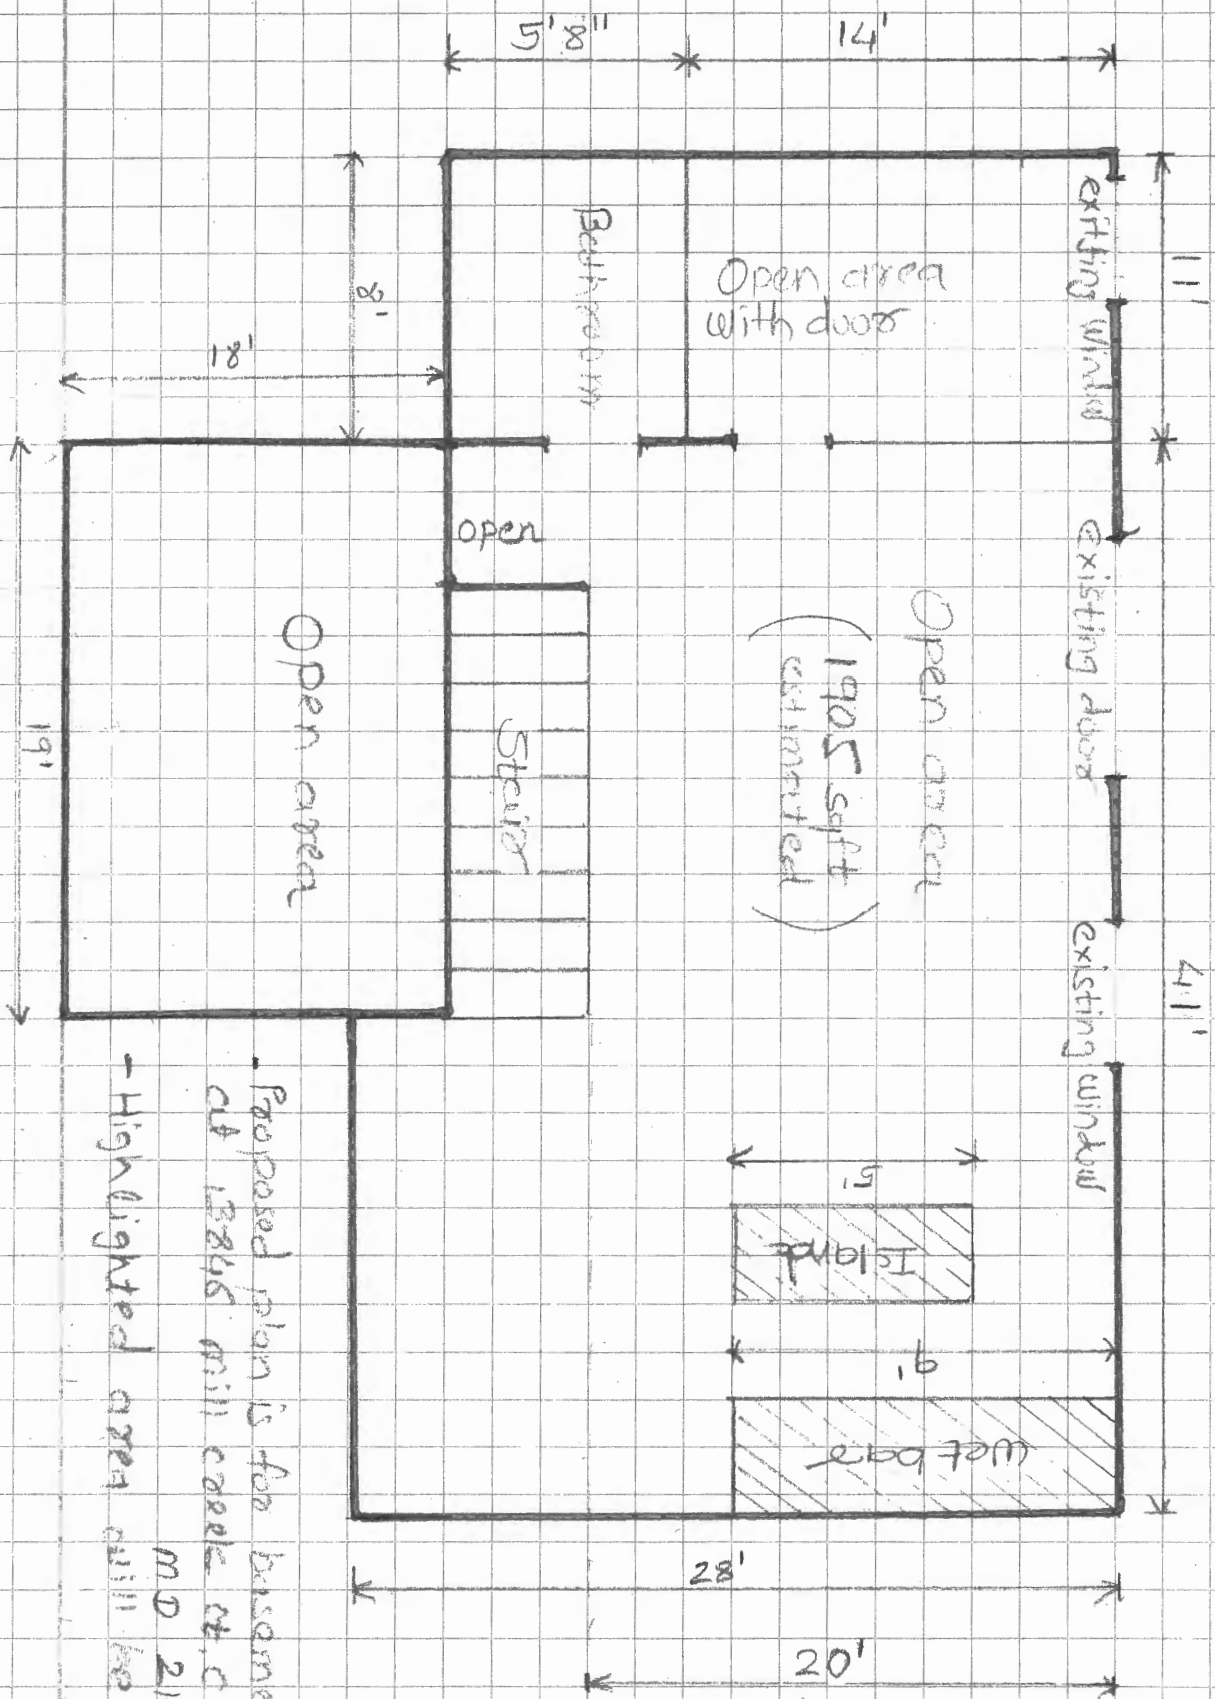

Proposed plan is for basement finish at 13846 Mill creek at Chicksville - MD 21029  
 - Highlighted area will be finished.

**RECEIVED**

DEC 28 2020

LICENSES & PERMITS  
DIVISION

Anjum Dahya  
13846 Mill Creek Ct.  
Clarksville, MD 21029  
December 27, 2020

RESIDENTIAL BUILDING PERMIT  
HOWARD COUNTY DEPARTMENT OF INSPECTIONS, LICENSES, AND PERMIT  
3430 COURT HOUSE DRIVE  
ELLCOTT CITY, MD 21043

To Whom It May Concern:

My name is Anjum Dahya. I am applying for residential building permit to complete my unfinished basement. My property address is 13846 Mill Creek Ct. Clarksville, MD 21029.

I initially hired private contractors to complete the work including all the permits, license and inspections as required by the Howard County. I found out about the permits requirement from one of the Howard County Inspector who visited our property for our recent Tesla Solar Panel inspection. I contacted my contractor right away and requested the permit copy. However, the contractors left the project without informing about anything. I suspected that they never applied for the permits. Thus; I would be completing my basement in my own and would like to request a permit.

I would like to request for the residential building permit. I am including following forms or documents listed below as per the county's requirement.

- Residential Building Permit
- 3 copies of the Existing Floor Plan
- 3 copies of the Proposed Floor Plan (computer and hand drawn)
- Check of \$135.00

Please process my application as soon as possible. If you have any concerns or questions, I can be reach on 301-613-7759 or via email [adahya1@gmail.com](mailto:adahya1@gmail.com).

*§ aekil.dahya@gmail.com*

Sincerely,

Anjum Dahya  
12/27/2020