

Hi Robert:

This wound up in  
my inbox, but I  
think it should go to  
you as it relates to  
B21004947 (pool  
permit) - Hank



# HOWARD COUNTY HEALTH DEPARTMENT

71476

4/12/02  
DATE

Received From

Walnut Creek

PHONE #

410-401-1614

For

Revised PRC Cert Plan  
Walnut Creek

CASH

CHECK

NO.

EMAX

Dollars

\$

11.00

Received By

EMAX

## Silvast, Zackary

---

**From:** Rob Vogel <Rob.Vogel@timmons.com>  
**Sent:** Monday, June 13, 2022 5:50 PM  
**To:** Bricker, Robert  
**Cc:** Silvast, Zackary  
**Subject:** RE: 12213 Bassler's Way\_revised perc cert\_comment

[Note: This email originated from outside of the organization. Please only click on links or attachments if you know the sender.]

OK

**Robert H. Vogel P.E., M.ASCE**

*Principal*

**VOGEL ENGINEERING + TIMMONS GROUP** | [www.timmons.com](http://www.timmons.com)  
3300 N. Ridge Road, Suite 110 | Ellicott City, MD 21043  
Office: 410.461.7666 | Fax: 410.461.8961  
<https://www.linkedin.com/company/timmons-group>  
*Your Vision Achieved Through Ours*

To send me files greater than 20MB [click here](#)

**From:** Bricker, Robert <RBricker@howardcountymd.gov>  
**Sent:** Monday, June 13, 2022 4:12 PM  
**To:** Rob Vogel <Rob.Vogel@timmons.com>  
**Cc:** Silvast, Zackary <zsilvast@howardcountymd.gov>  
**Subject:** 12213 Bassler's Way\_revised perc cert\_comment

CAUTION: This email originated from outside of the organization. Do not click links or open attachments unless you recognize the sender and know the content is safe.

Good afternoon Rob,

The submitted Percolation Certification Plan will not be approved as submitted. The symbol used for Removed Well Area is very nearly the same as the symbol for Proposed Well Area, and there is not a representation of the symbol for Removed Well Area in the Legend.

Also, correct the spelling for Revised in the title block.

Robert Bricker, REHS/RS, L.E.H.S.  
Environmental Sanitarian II  
Bureau of Environmental Health, Well and Septic Program  
8930 Stanford Blvd., Columbia, MD 21045

Phone: (410)313-2691  
Email: [rbricker@howardcountymd.gov](mailto:rbricker@howardcountymd.gov)

# VOGEL ENGINEERING + TIMMONS GROUP

3300 North Ridge Road, Suite 110, Ellicott City MD 21043  
P 410.461.7666 F 410.461.8961 [www.timmons.com](http://www.timmons.com)

**Date:** April 1, 2022  
**To:** Howard County Health Department  
**Attn:** Mr. Robert Bricker  
**Subject:** Walnut Creek Phase I-Lot 14  
**Project Number:** 13-21.00

## ATTACHED:

# Copies	Description
3	Revised Percolation Certification plan
3	Well Exhibit

Remarks:



Please call 410-461-7666 with any questions.

Thank you

Kathleen Makusky


Transmitted by:

\_\_\_\_\_  
Received by:

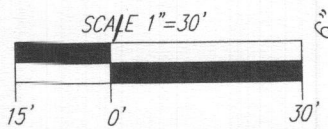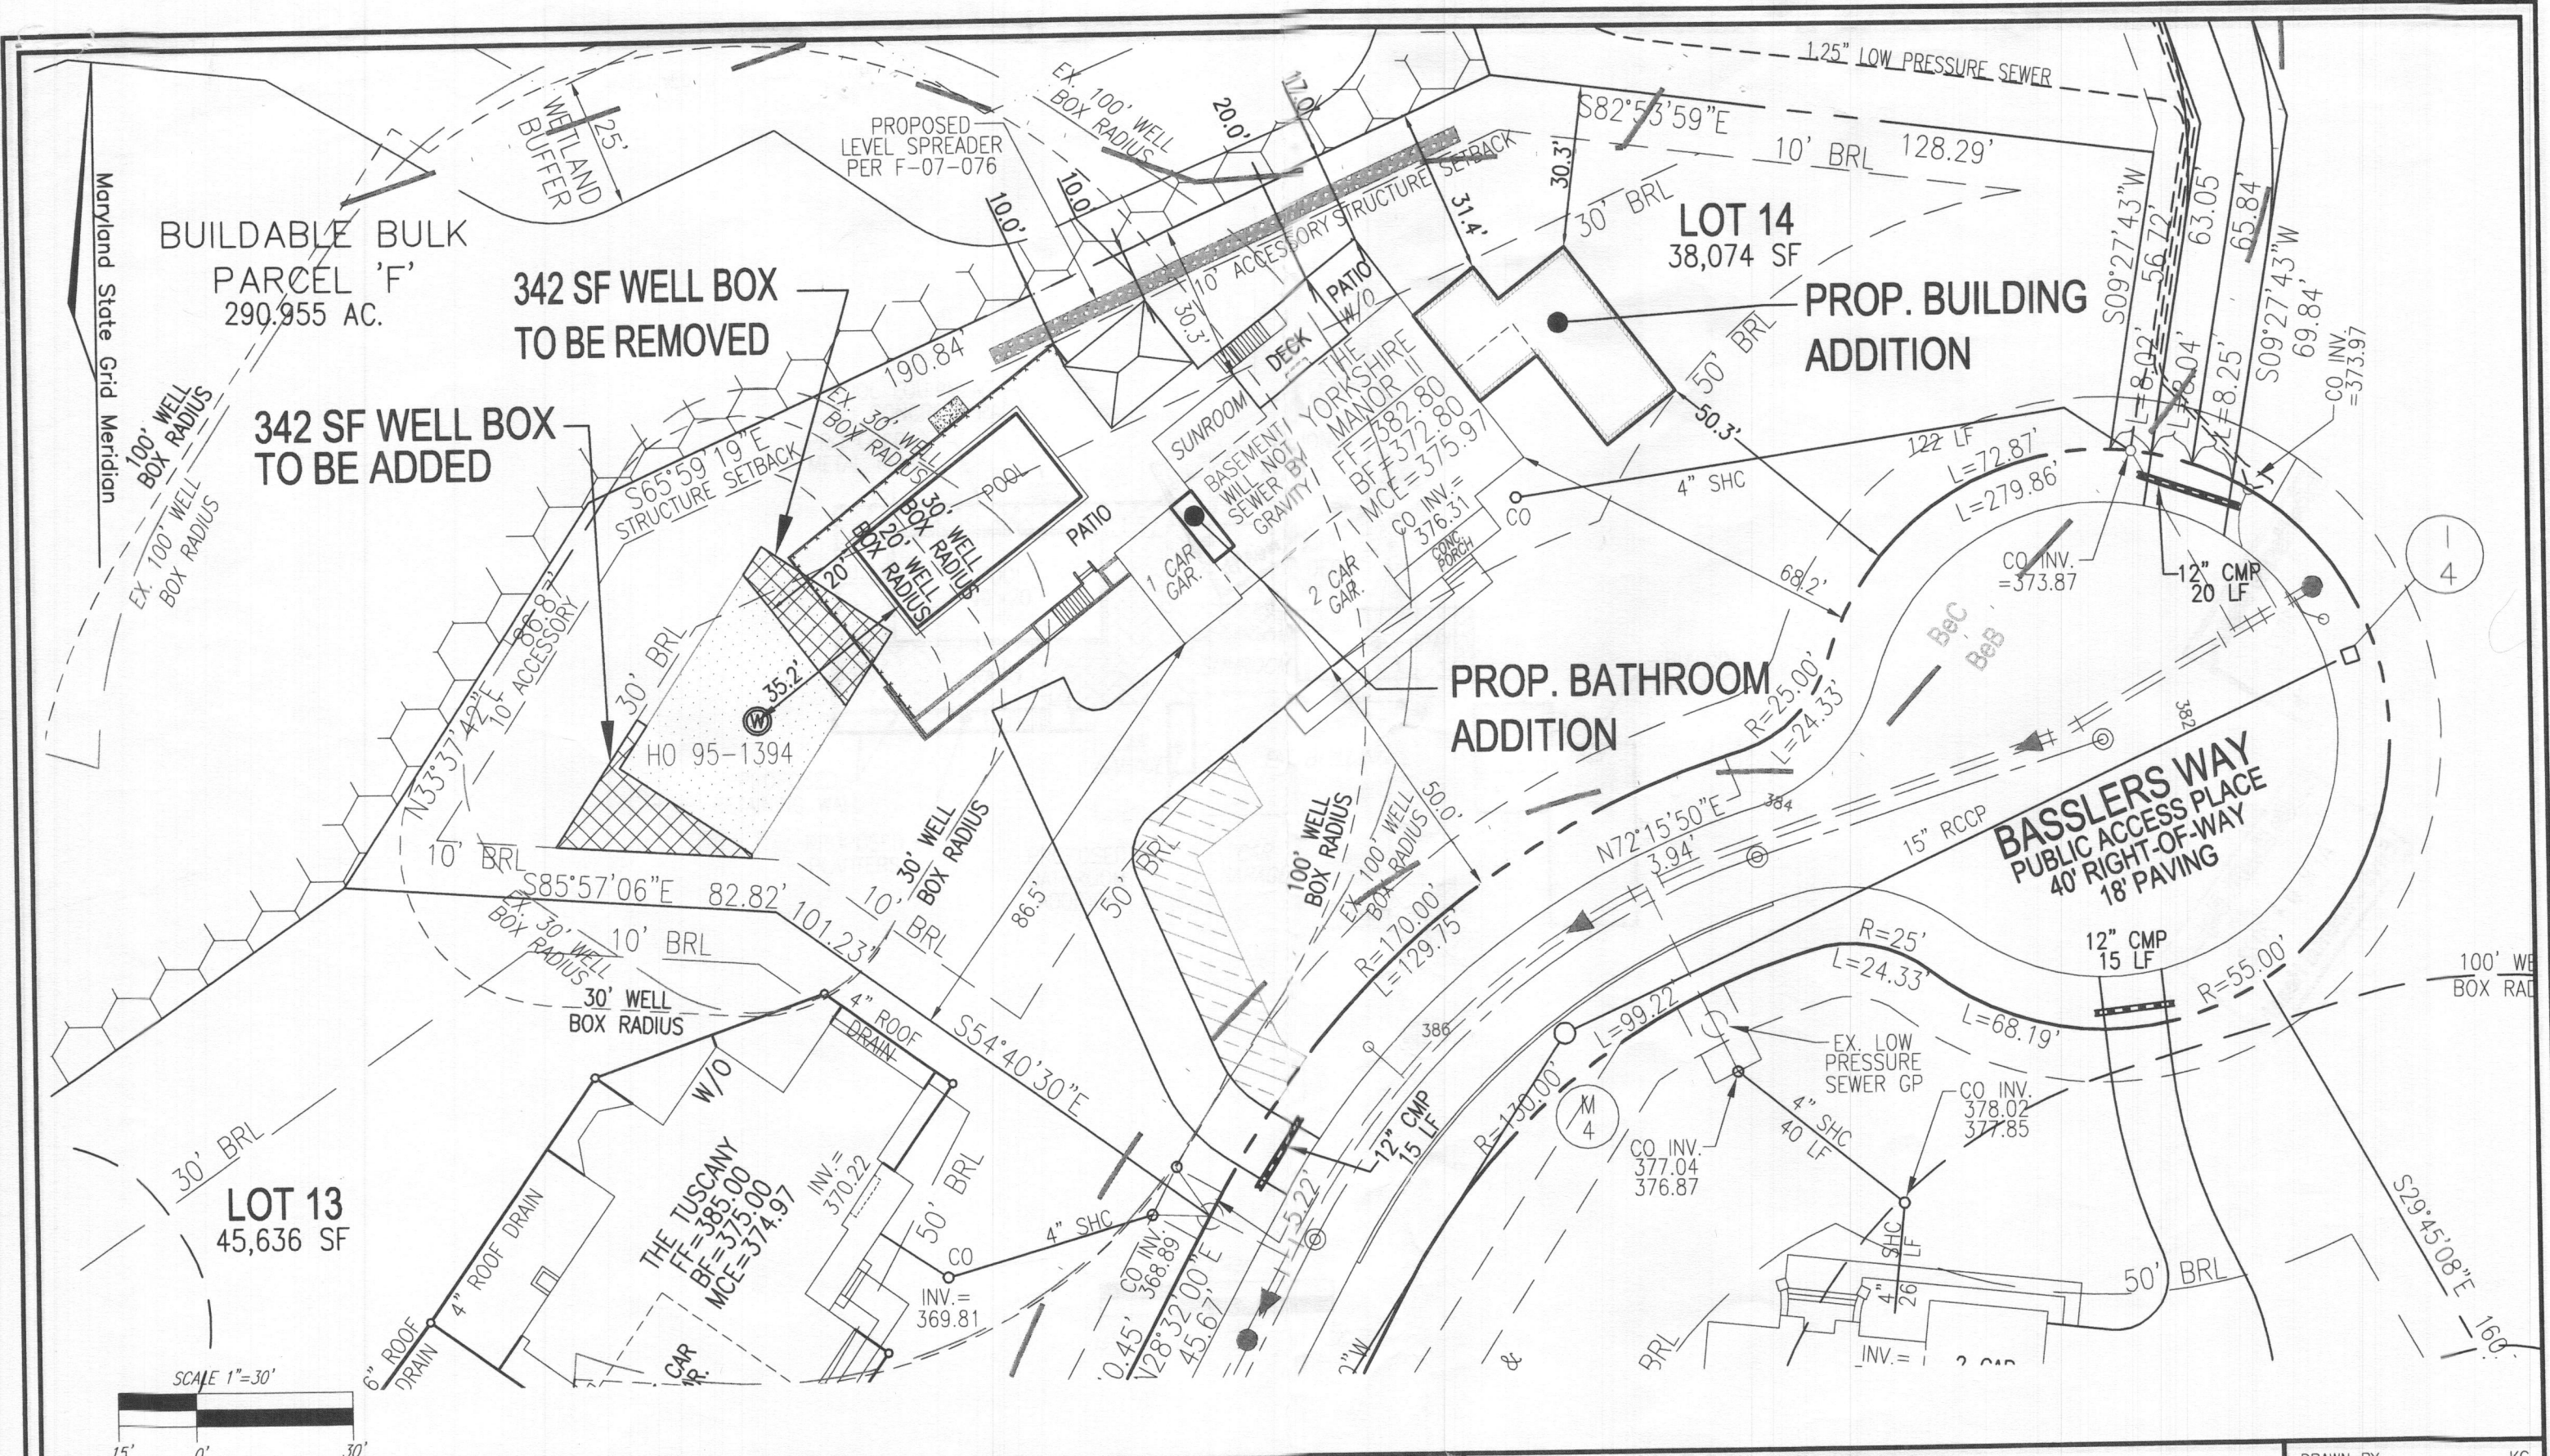

**VOGEL ENGINEERING**  
  
**TIMMONS GROUP**  
 3300 NORTH RIDGE ROAD, SUITE 110, ELLICOTT CITY, MD 21043  
 P: 410.461.7666 F: 410.461.8961 www.timmons.com

**OWNER**  
 BHATIA BEENISH  
 GURRALA SRUTHI REDDY  
 12213 BASSLERS WAY  
 CLARKSVILLE, MD 21029


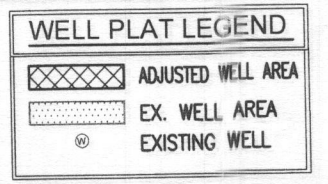


**WELL EXHIBIT**  
**WALNUT CREEK**  
 LOT 14  
 12213 BASSLERS WAY  
 ELLICOTT CITY, MD 21029

TAX MAP 28 BLOCK 11  
 5TH ELECTION DISTRICT

ZONE RC-DEO  
 PARCEL 49  
 HOWARD COUNTY, MARYLAND

DRAWN BY: \_\_\_\_\_ KG  
 DESIGN BY: \_\_\_\_\_ RHV  
 CHECK BY: \_\_\_\_\_ RHV  
 DATE: \_\_\_\_\_ MARCH 2022  
 SCALE: \_\_\_\_\_ 1"=30'  
 W.O. NO.: \_\_\_\_\_ 13-21

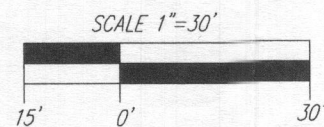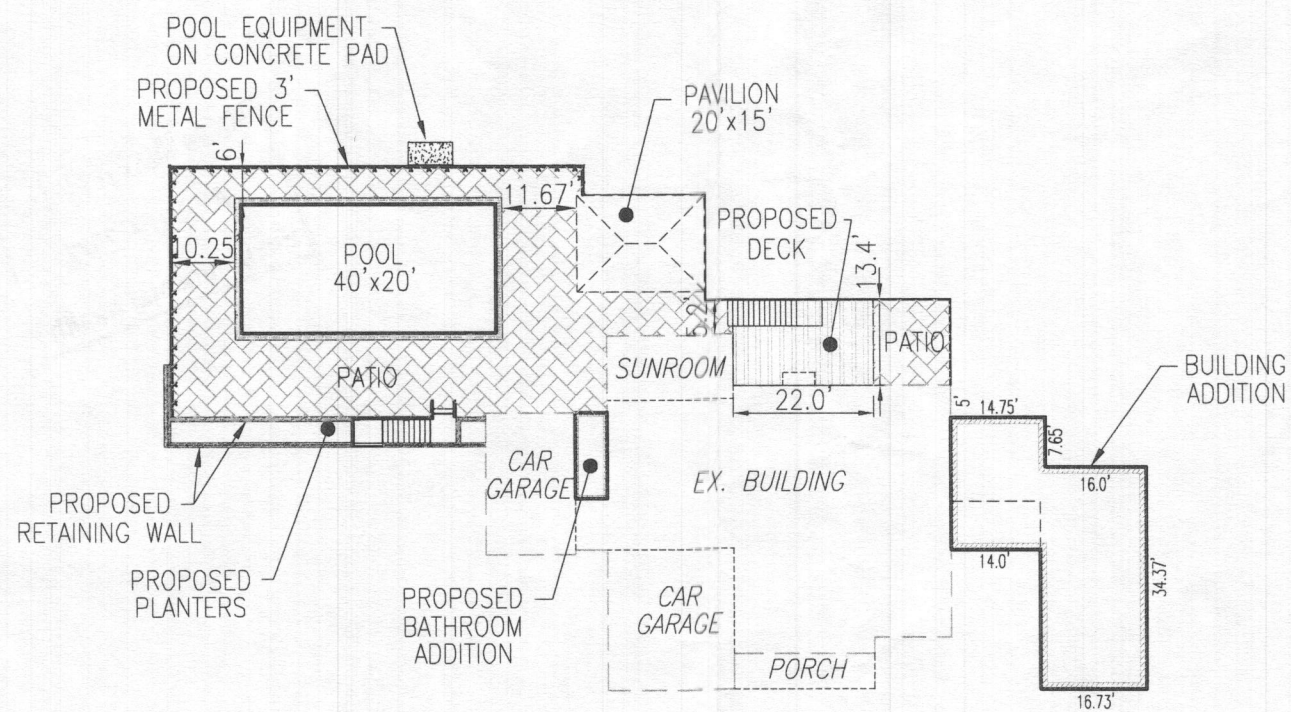

**VOGEL ENGINEERING**

**TIMMONS GROUP**  
 3300 NORTH RIDGE ROAD, SUITE 110, ELLICOTT CITY, MD 21043  
 P: 410.461.7666 F: 410.461.8961 www.timmons.com

**OWNER**

BHATIA BEENISH  
 GURRALA SRUTHI REDDY  
 12213 BASSLERS WAY  
 CLARKSVILLE, MD 21029

**WELL PLAT LEGEND**

- ADJUSTED WELL AREA
- EX. WELL AREA
- EXISTING WELL

**WELL EXHIBIT  
 WALNUT CREEK  
 LOT 14**

12213 BASSLERS WAY  
 ELLICOTT CITY, MD 21029

TAX MAP 28 BLOCK 11  
 5TH ELECTION DISTRICT

ZONE RC-DEO  
 PARCEL 49  
 HOWARD COUNTY, MARYLAND

DRAWN BY: \_\_\_\_\_ KG  
 DESIGN BY: \_\_\_\_\_ RHV  
 CHECK BY: \_\_\_\_\_ RHV  
 DATE: \_\_\_\_\_ MARCH 2022  
 SCALE: \_\_\_\_\_ 1"=30'  
 W.O. NO.: \_\_\_\_\_ 13-21