

PERMIT

SEWAGE DISPOSAL SYSTEM

MARYLAND STATE DEPARTMENT OF HEALTH

HOWARD COUNTY

INDIVIDUAL

ELLICOTT CITY

DISTRICT 6

DATE 9/14/60

025 58
P 025-58
A -02661

05-353556?

Tabelle & Levy

IS PERMITTED TO INSTALL ALTER

ADDRESS Ellicottville

PHONE 491-6-9341

A SEWAGE DISPOSAL SYSTEM LOCATED AT

SUBDIVISION Greenwood Farm

ROAD Greenwood & Greenwood

9

PROPERTY OWNER

Mark J. Tucker

ADDRESS

SPECIFICATIONS

DRAIN FIELD _____ DEPTH _____ FEET, BOTTOM AREA _____ SQ. FT.

SEPTAGE PITS _____ ABSORBENT SIDE-WALL AREA _____ SQ. FT.

SEPTIC TANK CAPACITY 750 GALLONS

FOR CHANGE OF USE, INCREASE INSTALLED TANK CAPACITY NOW

OTHER: Leaching bed - 4' x 7' top, 3' bottom area depth 3 ft. to 5 ft. Place the bed

about 50 ft. to 115 ft. from the edge of Greenwood Lane and about 190 to 220 ft.

from the edge of Green Bridge Rd.

PLANS APPROVED BY Raymond Hodges

DATE 6/28/60

FILL SEPTIC TANK AND DISTRIBUTION BOX WITH WATER BEFORE CALLING FOR AN INSPECTION. COVER NO WORK UNTIL INSPECTED AND APPROVED.

NEITHER THE HOWARD COUNTY COMMISSIONERS NOR THE HEALTH DEPARTMENT IS RESPONSIBLE FOR THE SUCCESSFUL OPERATION OF ANY SYSTEM.

SEWER PERMIT SIGNATURE

AND RETURNED 9-30-60


Serial # B10120647
Interior Alteration
Department

SEWER PERMIT SIGNATURE

AND RETURNED 9/13/60

Serial # 34621
Dept

102641
513633L

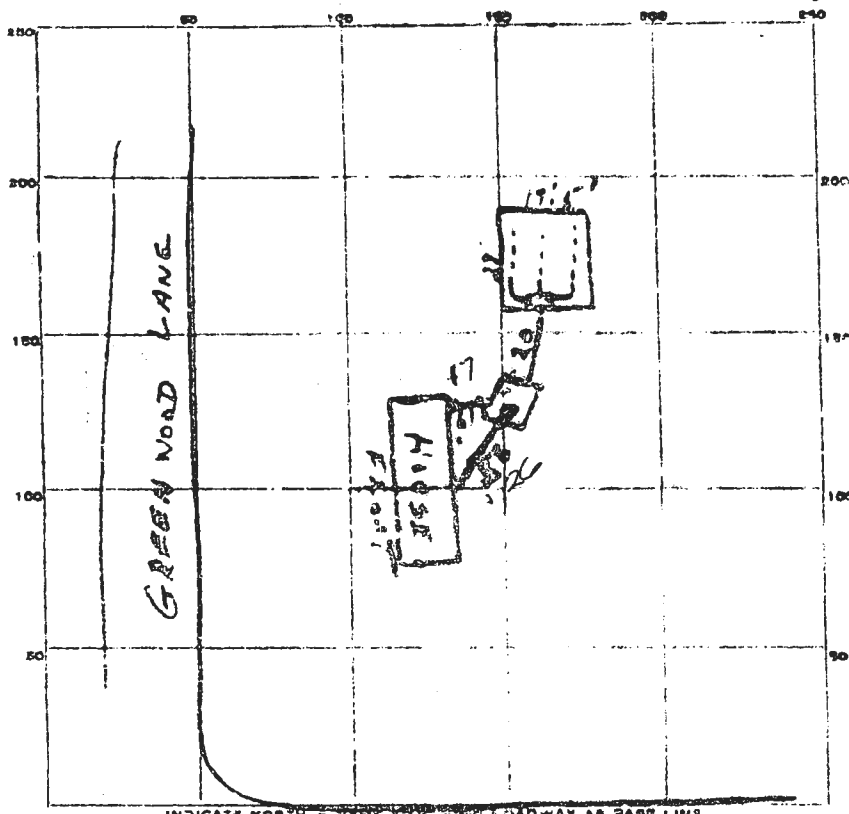

17.5
 20
 17.5
 37.5

20
 17.5
 17.5
 20
 37.5

PERMIT CARD Yes BROWN BRIDGE RD.

SEPTIC TANK, LEVEL _____ CLEANOUTS stand pipe

DISTRIBUTION BOX, LEVEL OK

Leaching Bed DEPTH 4 to 5 FT. bed WIDTH 17.5 FT.

GRAVEL DEPTH _____ IN. TOTAL LENGTH 29 FT.

NUMBER OF TRENCHES _____ TOTAL BOTTOM AREA 507.5

SEEPAGE PITS, INSIDE DIAMETER _____ FT. DEPTH BELOW INLET _____ FT.

ABSORBENT AREA _____ SQ. FT.

REMARKS Leaching bed installed

DATE SYSTEM APPROVED 9-29-60 INSPECTOR [Signature]