

APPLICATION

9/10/84
2:00 PM
Usual

SEWAGE DISPOSAL TESTING

STATE OF MARYLAND - DEPARTMENT OF HEALTH AND MENTAL HYGIENE

HOWARD COUNTY HEALTH DEPARTMENT
ENVIRONMENTAL HEALTH SERVICES

P. O. BOX 476 ELLICOTT CITY, MARYLAND 21043
TELEPHONE: 992-2330

A 33229

P _____

DISTRICT 5th

DATE Oct. 25, 1983

TO: THE COUNTY HEALTH OFFICER
ELLICOTT CITY, MARYLAND

I, HEREBY, APPLY FOR THE NECESSARY TEST IN ORDER TO CONSTRUCT (OR RECONSTRUCT) A SEWAGE DISPOSAL SYSTEM.

PROPERTY OWNER Elizabeth P. Tharin David A. Barrow

ADDRESS _____ PHONE 1-492-9049
7532 N. Arbony Way 492-8308

PROPERTY LOCATION:

SUBDIVISION HERITAGE WOODS LOT NO. 4-C

ROAD AND DESCRIPTION 7297
Brown Bridge Road near RA 216

tax map 40, parcel 476

SIZE OF LOT _____ TYPE BLDG. _____
(NUMBER OF BEDROOMS)

THE SYSTEM INSTALLED UNDER THIS APPLICATION IS ACCEPTABLE ONLY UNTIL PUBLIC FACILITIES BECOME AVAILABLE. I FULLY UNDERSTAND THE FEE CONNECTED WITH THE FILING OF THIS PERC TEST APPLICATION IS NON-REFUNDABLE UNDER ANY CIRCUMSTANCES. I ALSO AGREE TO COMPLY

WITH ALL M.O.S.H.A. REQUIREMENTS IN TESTING THIS LOT. /s/ Don Reuwer/ Williams & Hanson
(SIGNATURE OF APPLICANT)

APPROVED BY Raymond Hodge FOR Trenchard DATE 12/13/83

REJECTED BY _____ FOR _____ DATE _____







HOLD PENDING FURTHER TESTS _____ DATE _____

REASONS FOR REJECTION OR HOLDING 11/9/83 Per OK Hold for Perc Cert Plat R/H
12/13/83 Sp... R/H

BLDG. PERMIT SIGNED
AND RETURNED 12/24/84
Serial # 10961 STD
9/19/84 Revised Plan OK. F.R.S.

THIS IS NOT A PERMIT

Lot 4C

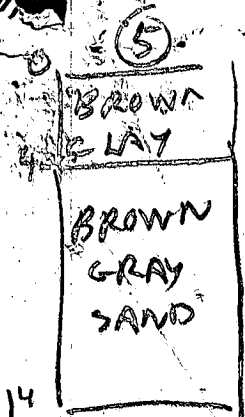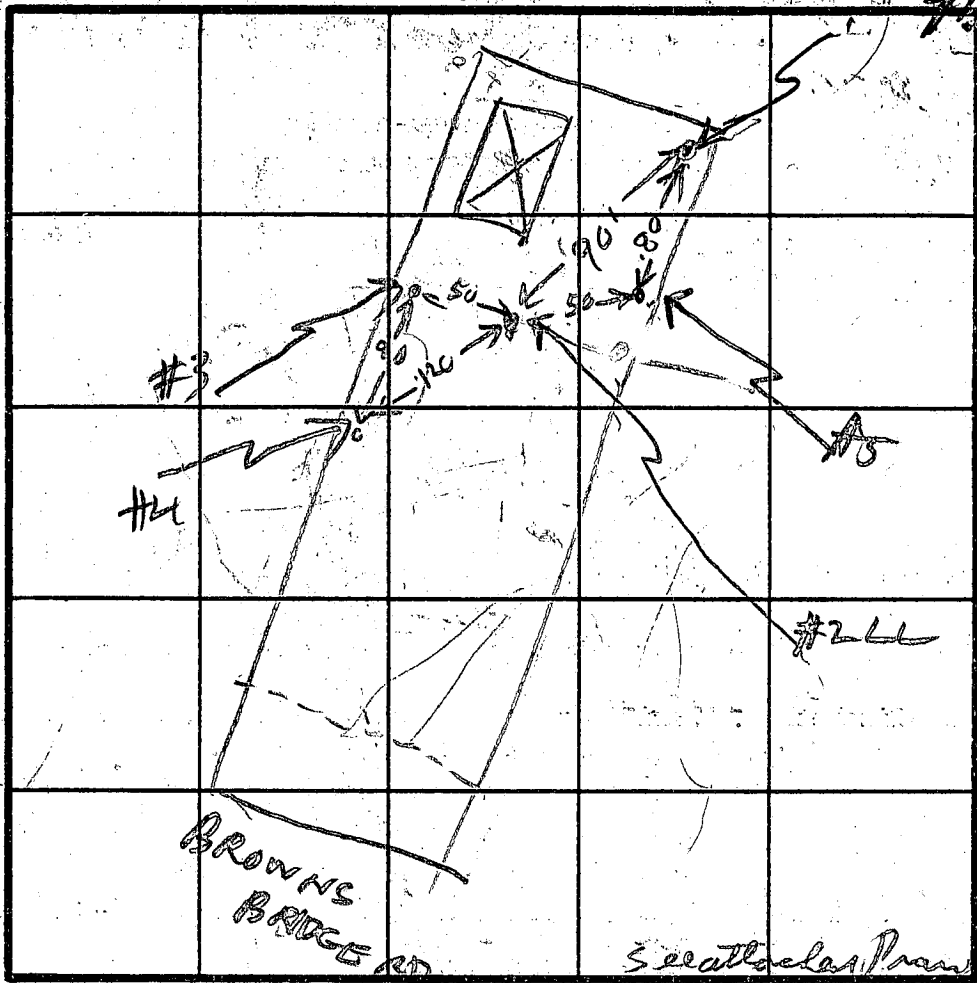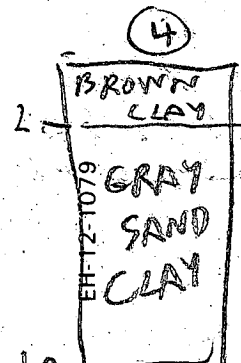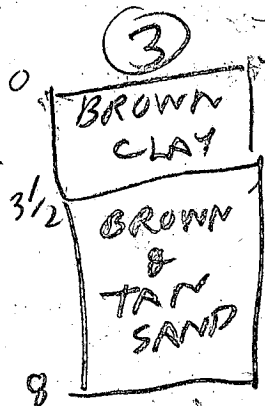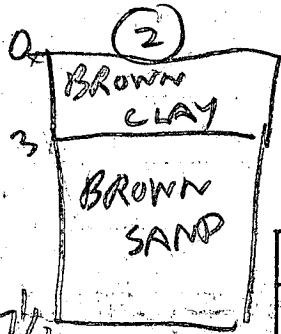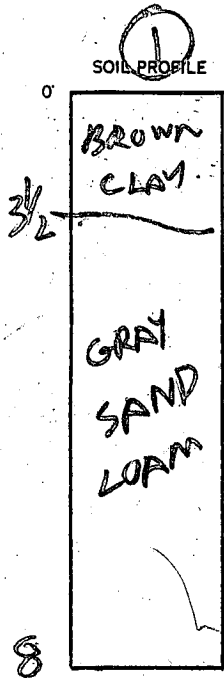

INDICATE NORTH - NAME ADJOINING ROADWAY AS BASE LINE.

DATE	R/H TEST NO.	DR #	DEPTH	PRE-WET		TEST - 1" DROP		TIME
				START	STOP	START	STOP	
11/4	1S	5	4	250	312	312	320	26
	1V	5	8	LOOKS	OK			
	2S	1	4	300	309	309	313	4
	2V	1	7 1/2	LOOKS	OK			
	3S	3	5	304	307	307	311	4
	3V	3	8	LOOKS	OK			
	4S	4	4	305	316	316	332	16
	4V	4	12	LOOKS	OK			
	5V	2	14	LOOKS	OK			

ON LINE
HOLE

ON LINE
BETWEEN
LOT 4C & 4D

ON LINE
BETWEEN
LOT 4C & 4D

REMARKS 9/10/84 6-7V - 12 2 holes water at 9 ft - see plat for location (clay from to 5 ft - sandy to 12 ft.)
IS SAID OK TO USE ON LINE HOLES FOR BOTH LOT 4C & 4D

TYPE OF SOIL _____
TESTED BY B HODGEC

ALSO PRESENT D RIVER
ORFERRMAN