

SITE INSPECTION SHEET

OWNER: CHARLES DORSEY

DATE REQUESTED: 10-20-02 10 am

ADDRESS: 14840 BUSHY PARK RD
410-489-4723


DRILLER: JOSEPH MAYNE

WELL TAG # HO-94-3512

COUNTY # A13648

PROPOSAL: REPLACE MENT WELL - OUT OF WATER

LOCATION DIAGRAM

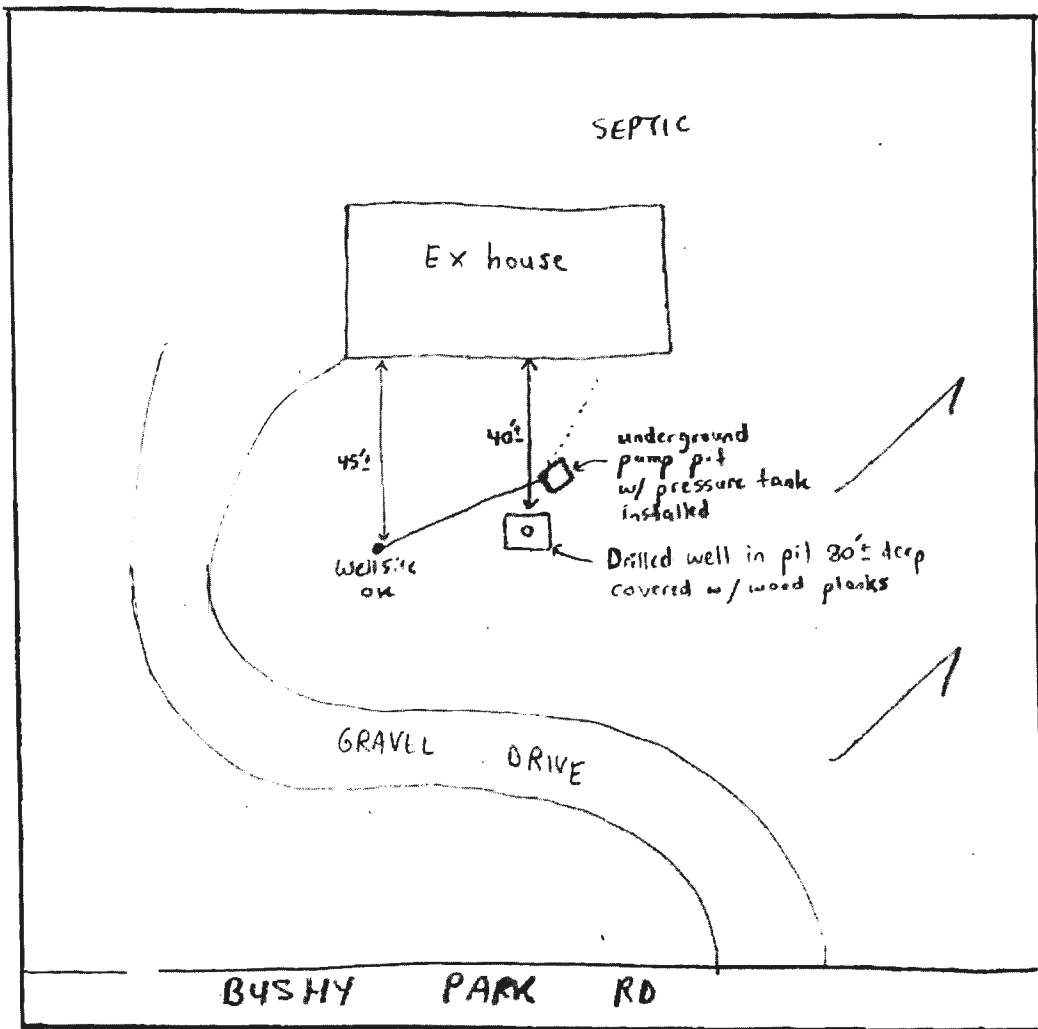

COMMENTS: Existing Drilled Well in pit going dry, to be kept as standby.
New well site OK (SRK)

DATE: 10/2/02

INSPECTOR: Steven R. Krieg



Built 1975 No Sub Room for 3 replacements

PERMIT

SEWAGE DISPOSAL SYSTEM

MARYLAND STATE DEPARTMENT OF HEALTH

HOWARD COUNTY

ELLICOTT CITY

DISTRICT 4th

DATE 8/20/74

INDEXED

Charles A. Dorsey IS PERMITTED TO INSTALL ALTER

ADDRESS Bushy Park Road, Woodbine, Md. PHONE 489-4723

A SEWAGE DISPOSAL SYSTEM LOCATED AT _____

SUBDIVISION _____ ROAD 14840 Bushy Park Road LOT _____

PROPERTY OWNER Charles A. Dorsey

ADDRESS same as above

SPECIFICATIONS 3 bedrooms

DRAIN FIELD _____ DEPTH _____ FEET. BOTTOM AREA _____ SQ. FT.

SEEPAGE PITS _____ ABSORBENT SIDE-WAL. AREA _____ SQ. FT.

SEPTIC TANK CAPACITY 1000 GALLONS

FOR GARBAGE GRINDER, INCREASE DISPOSAL AREA 25% & TANK CAPACITY 50%.

OTHER DRY WELL - Dig pit 15 ft. square - set block and top in center of pit for 12 ft. diameter and fill in rest of pit with gravel. Dry well to be 8 ft. deep below inlet pipe. Inlet pipe 3 to 4 ft. below original grade. Maximum depth permitted for dry well below original grade is 12 ft. Place dry well about 220 ft. from front lot line and about 42 ft. from right side sidewalk as seen when facing lot from front.

NOTE: ALL PIPE FROM HOUSE TO DRY WELL MUST BE CAST IRON.


PERMIT VOID AFTER THREE YEARS.

NOTE: INSTALL STAND PIPE ON SEPTIC TANK AND DRY WELL.

PLANS APPROVED BY Donald W. Monaghan DATE 8/27/68

FILL SEPTIC TANK AND DISTRIBUTION BOX WITH WATER BEFORE CALLING FOR AN INSPECTION. COVER NO WORK UNTIL INSPECTED AND APPROVED.

NEITHER THE HOWARD COUNTY COMMISSIONERS NOR THE HEALTH DEPARTMENT IS RESPONSIBLE FOR THE SUCCESSFUL OPERATION OF ANY SYSTEM.

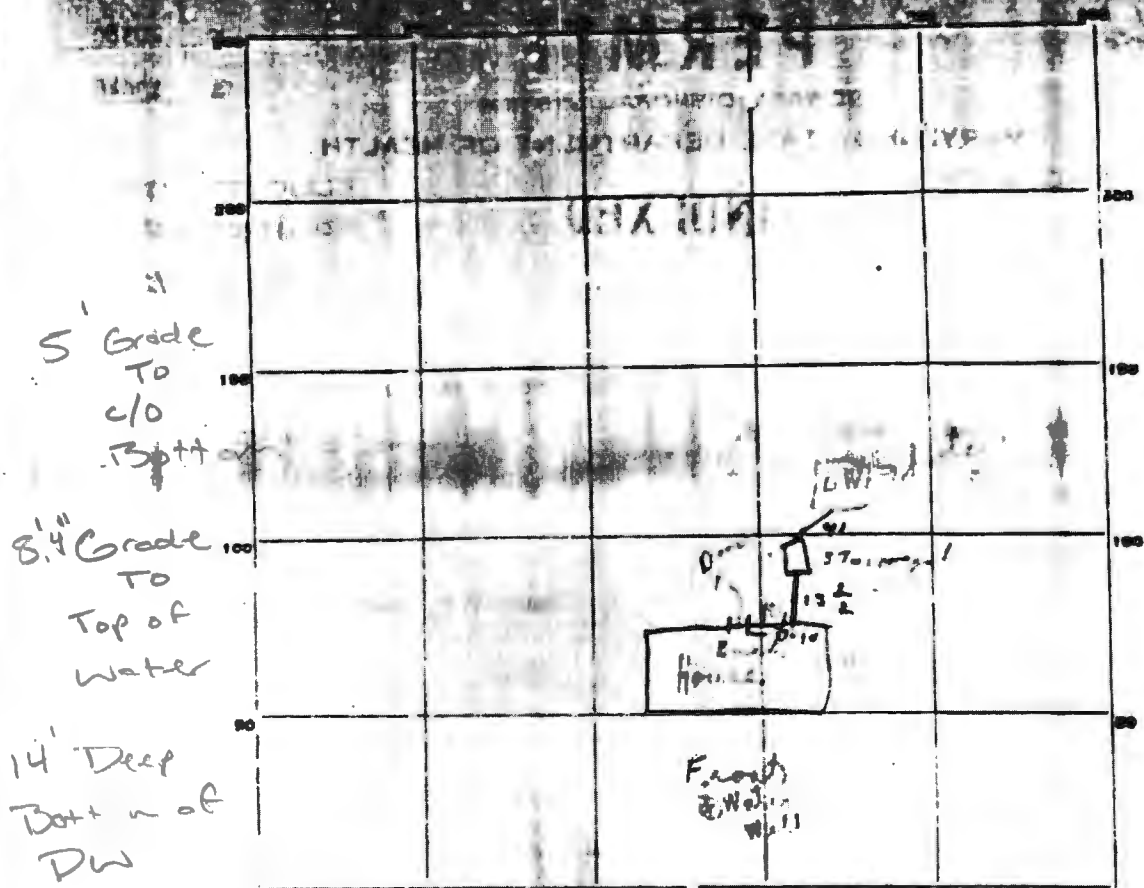

INDICATE NORTH - NAME ADJOINING ROADWAY AS BASE LINE
 Parted Back, Park Rd

PERMIT CARD

SEPTIC TANK, LEVEL None CLEANOUTS None

DISTRIBUTION BOX, LEVEL _____

PILE FIELD, DEPTH _____ FT. TRENCH WIDTH _____ FT.

GRAVEL DEPTH _____ IN. TOTAL LENGTH _____ FT.

NUMBER OF TRENCHES _____ TOTAL BOTTOM AREA _____

SEEPAGE PITS, INSIDE DIAMETER 59 FT. DEPTH BELOW INLET 9 FT.

ABSORBENT AREA 531 SQ. FT.

REMARKS
 1/29/74 ① New tank in place ② in place
 (3) P. (4) S. (5) S. (6) S.
 4-1-74 CBS
 10/23/74 - on soil in pipe has been removed.
 ③ in galvanized pipe at 10' - 12'
 ④ connect down to DW. RM

DATE SYSTEM APPROVED 10/23/74 INSPECTOR R. W. Marshall