



HOWARD COUNTY HEALTH DEPARTMENT

69572

DATE 6/10/21

PS

Received From

R & G Remodeling

PHONE #

410-374-5560

LLC - Associated Excavators

For

Septic Permit/11809

Triadelphia
MD

CASH

CHECK

NO.

2774

One hundred sixty five Dollars

\$ 165.00

Received By

AKemp



HOWARD COUNTY HEALTH DEPARTMENT

69538

DATE 6/3/81

Received From

Tyler Septic Clean PHONE # 796-5670

For

Repair septic tank

CASH

CHECK

NO.

2168


11809
three hundred thirty dollars

Dollars

\$ 330.00

Received By

J King

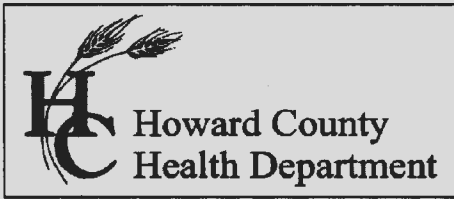

Bureau of Environmental Health
 8930 Stanford Boulevard, Columbia, MD 21045
 Main: 410-313-2640 | Fax: 410-313-2648
 TDD 410-313-2323 | Toll Free 1-866-313-6300
www.hchealth.org
 Facebook: www.facebook.com/hocohealth

Maura J. Rossman, M.D., Health Officer

RECEIPT DATE: 06/03/2021 **ONSITE SEWAGE DISPOSAL SYSTEM** P 569538

APPROVAL DATE: 6/30/2021 **PERMIT: REPAIR** A 569538

PROPERTY ADDRESS: 11809 Triadelphia Road

SUBDIVISION: Evergreen Estates LOT: 76 TAX ID: 03-289265

CONTRACTOR: Associated Excavators – Mike Johnson EMAIL: 46cuc57@gmail.com

CONTRACTOR ADDRESS: 16657 Frederick Road, Mount Airy, MD 21771 PHONE: 410-442-1886

PROPERTY OWNER: Rhyan Gamet EMAIL: _____

OWNER ADDRESS: 11809 Triadelphia Road PHONE: 757-374-5560

SEPTIC TANK SIZE (GALLONS): 1000 g (Ex.) PUMP CHAMBER CAPACITY (GALLONS): - PUMP SIZE: -

NUMBER OF BEDROOMS: 4 (5) HOUSE SQ. FT. - APPLICATION RATE: _____

DISTRIBUTION SYSTEM: GRAVITY FED LOW PRESSURE DOSED

TRENCHES:	LINEAR FEET REQUIRED: <u>Existing (1969)</u>	INLET DEPTH: <u>-</u>
	TRENCH WIDTH: <u>2'</u>	MAXIMUM BOTTOM DEPTH: <u>-</u>
	MINIMUM SPACE BETWEEN TRENCHES: <u>-</u>	EFFECTIVE AREA BEGINNING DEPTH: <u>-</u>
LOCATION:	TO BE STAKED BY SANITARIAN DURING PRE-CONSTRUCTION INSPECTION.	
NOTES:	Pump Existing Tank, Replace pipe in existing trenches with perforated PVC; ensure trench outlet from Drywell is lower than effluent line into dry well. Install trench repair to current code; spun filter fabric, stone cover, obs port at end of trenches. Owner has opted to update the drywell; fill with #2 stone; 6" perforated pipe through aggregate, solid pipe through grade. *Associated with 2021 Perc A569538	

ISSUED BY: Cabahug 001997 ISSUE DATE: 06/10/2021 EXPIRATION DATE: 06/10/2021


- NOTE: CONTRACTOR MUST SCHEDULE A PRE-CONSTRUCTION INSPECTION PRIOR TO BEGINNING ANY INSTALLATION
- NOTE: CONTRACTOR MUST SCHEDULE AN INSPECTION AND GAIN APPROVAL OF ALL COMPONENTS PRIOR TO COVERING
- NOTE: STONE MUST BE APPROVED BY HEALTH DEPARTMENT AND GRAVEL TICKET MUST BE AVAILABLE FOR REVIEW.
- NOTE: WATERTIGHT SEPTIC TANKS REQUIRED
- NOTE: ALL PARTS OF SEPTIC SYSTEM SHALL BE AT LEAST 100 FEET DOWNGRADIENT FROM ANY WATER WELL
- NOTE: MANHOLE RISERS REQUIRED ON ALL SEPTIC TANKS AND PUMP CHAMBERS
- NOTE: AN ELECTRICAL PERMIT IS REQUIRED FOR INSTALLATION OF ANY ELECTRICAL COMPONENTS OF THE SYSTEM
 ELECTRICAL PERMIT ISSUED E - _____
- NOTE: THE HCHD DOES NOT WARRANT ANY SYSTEM AND CANNOT GUARANTEE THE PERFORMANCE OF THIS SYSTEM AS DESIGNED. BY ACCEPTING THIS PERMIT, THE OWNER AND/OR APPLICANT ACKNOWLEDGE THAT THE SPECIFICATIONS DETAILED IN THIS DESIGN ARE ONE POSSIBLE OPTION AND THAT THE HCHD WILL REVIEW OTHER PROPOSALS. YOU HAVE THE OPTION TO SEEK THE ADVICE OF A QUALIFIED DESIGN CONSULTANT OR PROFESSIONAL ENGINEER FOR FURTHER GUIDANCE.
- NOTE: MDE RECOMMENDS SEPTIC TANKS, BAT, AND OTHER PRETREATMENT UNITS BE PUMPED AT A FREQUENCY ADEQUATE TO ENSURE THAT SOLIDS ARE NOT DISCHARGED TO THE DISPOSAL AREA

NEITHER THE HOWARD COUNTY COUNCIL NOR THE HEALTH DEPARTMENT IS RESPONSIBLE FOR THE SUCCESSFUL OPERATION OF ANY SYSTEM.

PERMITTEE RESPONSIBLE FOR OBTAINING FINAL APPROVAL ON THIS PERMIT.

CALL 410-313-1771 TO SCHEDULE INSPECTIONS.

NOT TO SCALE

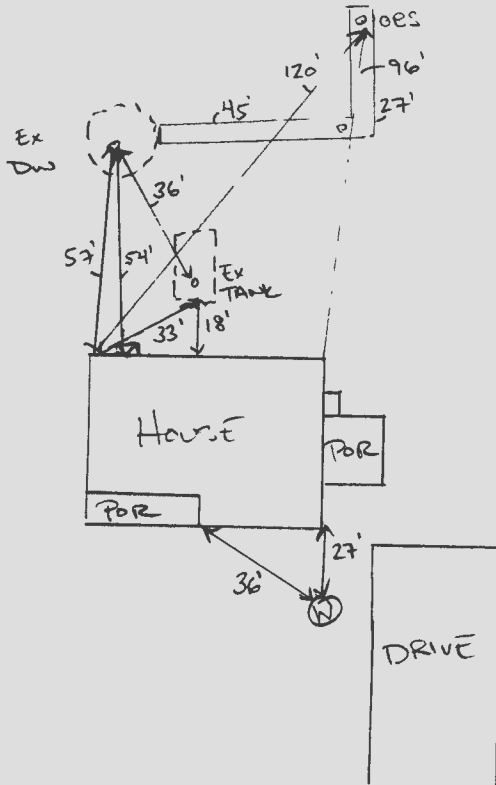

ROAD NAME
TRIADELPHIA ROAD

Ex:

TRENCH/DRAINFIELD DATA

WIDTH INLET BOTTOM

EX _____

NUMBER OF TRENCHES _____

TOTAL LENGTH _____

ABSORPTION AREA _____

DISTRIBUTION BOX LEVEL _____

DISTRIBUTION BOX BAFFLE _____

DISTRIBUTION BOX PORT _____

SEPTIC TANK DATA

SEPTIC TANK 1 LEVEL EX

MANUFACTURER _____

CAPACITY _____ GAL

SEAM LOC _____

TANK LID DEPTH _____

BAFFLES _____

BAFFLE FILTER _____

MANHOLE LOC _____

6" PORT LOC _____

WATERTIGHT TEST

SLOTTED _____

DATE ON LID _____

PUMP/SEPTIC TANK LEVEL N/A

MANUFACTURER _____

CAPACITY _____ GAL

SEAM LOC _____

TANK LID DEPTH _____

BAFFLES _____

BAFFLE FILTER _____

MANHOLE LOC _____

6" PORT LOC _____

WATERTIGHT TEST _____

SLOTTED _____

DATE ON LID _____

PRE-CONSTRUCTION:

06/21/2021 REPAIR EX TRENCHES TO FUNCTIONING STATE PER PERM T.

INSTALLATION: 06/30/2021 TRENCH UNCOVERED, ORANGEBURG PIPE REPLACED W/ LIGHT WEIGHT PERFE PVC. COVERED WITH STONE + 3/4" FILTER FABRIC. INSTALLED 1x 90 SWEEP (medium institutional; non critical) AT END OF FIRST TRENCH, OBS PORT ADDED TO END OF SECOND TRENCH IN SERIES. CONTRACTOR DID NOT THINK TRENCHES MET 1969 INSTALL SPEC.

* STONE MIGHT BE ~ 1' BELOW PIPE.

FINAL INSPECTOR

S. Puse

DATE OF APPROVAL

6/30/2021