

DILP 2016 APR 15 PM 2:50

DEPARTMENT OF INSPECTIONS, LICENSES & PERMITS 3430 COURT HOUSE DRIVE ELLICOTT CITY, MD 21043 PERMITS (410) 313-2455 INSPECTIONS (410) 313-1850	HOWARD COUNTY RESIDENTIAL HEATING-VENTILATION-AIR CONDITIONING AND REFRIGERATION PERMIT APPLICATION	HVACR PERMIT # <u>M16000330</u> BUILDING PERMIT #
---	---	--

BUILDING ADDRESS: <u>3110 Florence rd, Woodbine, md 21797</u> SUITE/APT: SUBDIVISION: CENSUS TRACT: SECTION: AREA: LOT: TAX MAP: PARCEL: BLOCK: ZONE: PROPERTY ID: MAP COORDINATES: TYPE OF IMPROVEMENTS: USE: <u>SPD</u>	OWNERS NAME: <u>Mark Staffer</u> ADDRESS: <u>3110 Florence rd</u> CITY: <u>Woodbine</u> STATE: <u>md</u> ZIP CODE: <u>21797</u> HOME PHONE: <u>410 546 0776</u> WORK PHONE:
---	---


<table border="0"> <thead> <tr> <th style="text-align: center;"><u>CHECK ONE</u></th> <th style="text-align: center;"><u>HOW MANY</u></th> <th></th> </tr> </thead> <tbody> <tr> <td>SINGLE FAMILY DWELLING <input checked="" type="checkbox"/></td> <td style="text-align: center;"><u>2</u></td> <td>ZONES</td> </tr> <tr> <td>SINGLE FAMILY TOWNHOUSE <input type="checkbox"/></td> <td style="text-align: center;">___</td> <td>ZONES</td> </tr> <tr> <td>MULTI-FAMILY / HOTEL/MOTEL <input type="checkbox"/></td> <td style="text-align: center;">___</td> <td>ROOMS</td> </tr> <tr> <td>ASSISTED LIVING HOMES (16 OR FEWER RESIDENTS) <input type="checkbox"/></td> <td style="text-align: center;">___</td> <td>ROOMS</td> </tr> </tbody> </table>	<u>CHECK ONE</u>	<u>HOW MANY</u>		SINGLE FAMILY DWELLING <input checked="" type="checkbox"/>	<u>2</u>	ZONES	SINGLE FAMILY TOWNHOUSE <input type="checkbox"/>	___	ZONES	MULTI-FAMILY / HOTEL/MOTEL <input type="checkbox"/>	___	ROOMS	ASSISTED LIVING HOMES (16 OR FEWER RESIDENTS) <input type="checkbox"/>	___	ROOMS	COMPANY NAME: <u>Supreme Air</u> LICENSEE NAME: <u>Alexander Kougioumis</u> ADDRESS: <u>4401 E Eastern Ave</u> CITY: <u>Baltimore</u> STATE: <u>md</u> ZIP CODE: <u>21224</u> PHONE: <u>410-788-1114</u> HVACR LICENSE NO: <u>47207</u>
<u>CHECK ONE</u>	<u>HOW MANY</u>															
SINGLE FAMILY DWELLING <input checked="" type="checkbox"/>	<u>2</u>	ZONES														
SINGLE FAMILY TOWNHOUSE <input type="checkbox"/>	___	ZONES														
MULTI-FAMILY / HOTEL/MOTEL <input type="checkbox"/>	___	ROOMS														
ASSISTED LIVING HOMES (16 OR FEWER RESIDENTS) <input type="checkbox"/>	___	ROOMS														

New <input type="checkbox"/> Heating and Air Conditioning <input checked="" type="checkbox"/> Geo Thermal System Replacement <input type="checkbox"/> Heating <input type="checkbox"/> Air Conditioning <input type="checkbox"/> Heating and Air Conditioning	<input type="checkbox"/> Heating System Only <input type="checkbox"/> Ductless Mini Splits <input type="checkbox"/> Other Work (Describe): <input type="checkbox"/> Thru The Wall Systems Additions and Alterations <input type="checkbox"/> Heating <input type="checkbox"/> Air Conditioning <input type="checkbox"/> Heating and Air Conditioning <div style="border: 1px solid black; border-radius: 50%; padding: 10px; display: inline-block;"> <p style="font-size: 2em; margin: 0;">Approved</p> <p style="font-size: 1.5em; margin: 0;">4/21/2016</p> </div>
---	---

****Replacement Geo Thermal Systems are not required; However, if a tax credit is being sought a permit is required****

Zones Permit Fee = # of Zones x \$40 = <u>80</u> Technology Fee (10% of Permit Fee) = <u>8</u> Plus Application Fee <u>\$50.00</u> Total Fees Due = <u>138.00</u>	Rooms Permit Fee = # of Rooms x \$80 = _____ Technology Fee (10% of Permit Fee) = _____ Plus Application Fee \$50 <u>\$50.00</u> Total Fees Due = _____
---	---

I HAVE CAREFULLY EXAMINED AND READ THIS APPLICATION AND KNOW IT IS TRUE AND CORRECT. THE WORK DESCRIBED HEREIN WILL BE PERFORMED BY A STATE HVACR LICENSED PERSON(S), AND ALL WORK WILL BE PERFORMED IN COMPLIANCE WITH APPLICABLE CODES AND STANDARDS OF HOWARD COUNTY THE STATE OF MARYLAND.


 SIGNATURE OF LICENSEE

4/15/16
 DATE

Validation

Check Number: 3673

Cash: _____

Receipt Number: 443050

Alexander Kougioumis
 PRINT NAME OF LICENSEE

Alex @ Supreme Air LLC.com
 Email Address

Make check payable to: DIRECTOR OF FINANCE OF HOWARD COUNTY

RECEIVED


APR 15 2016

LICENSES & PERMITS
 DIVISION



30.5

S53°55'37" W

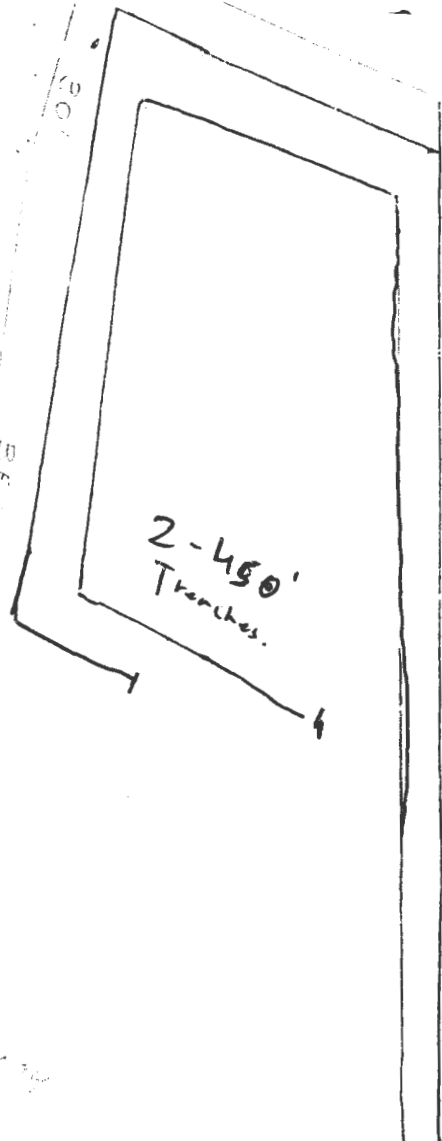

2-450'
Trenches.



Geothermal
Trenches
M16000330
Approved
4/21/2016
BB


3RL

30' BRL

4' Wrecker Fence

Macadam Driveway

3110
Florence
Road

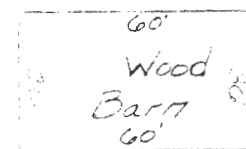

60'
Wood
Barn
60'

See info 201 Driveway Use Access
Agreement, see Note No. 7 Plat
3110

BRL

Gr