

**COMPLETE THIS FORM WHEN DROPPING OFF ANY  
CORRESPONDENCE AND/OR PLANS TO THE HOWARD COUNTY  
DEPARTMENT OF INSPECTIONS, LICENSES AND PERMITS COUNTER:**

Date: 1/17/2023

To: Health  
(Person's Name and Division)

From: Anthony Bobeck, Owner (808) 371 6170  
(Your Name, Company Name and Telephone Number)

Subject: Project name Basement  
Project site address 1151 Shaffersville Rd Mt. Airy MD 21771  
Permit # B2200 2820 SDP # N/A  
Other information pertinent to this project \_\_\_\_\_

- Please check the attachments below that you are submitting with this transmittal:
- Letter of response to address plan review comment letter
  - Revised plans and/or revised details: When submitting for a complete re-review, **duplicate sets shall be submitted.**
  - Letter Summarizing Changes
  - Energy conservation calculations
  - Copies of \_\_\_\_\_ (be specific). *Approved as proposed, no septic upgrade required. g/s 1/31/23*
  - Health Department Request       DPZ/ DED Request       Applicant's Request
  - Two sets of single family dwelling model plans to be placed on permanent file: Model name and/or # \_\_\_\_\_
  - Other Revised Floor plan to make Door 4ft. to Office space in Basement

**Contact Person Information: (Required)**


Anthony Bobeck  
Please Print Name


Telephone No: 808 371 6170

E-Mail Address: anthony.bobek@gmail.com

**PLEASE ASSURE ALL DOCUMENTS AND/OR REVISIONS ARE APPROPRIATELY SIGNED AND SEALED, IF NECESSARY, BY A LICENSED ARCHITECT OR ENGINEER. PLEASE BE ADVISED THAT INSUFFICIENT INFORMATION MAY RESULT IN THE DELAY OF REVIEW BY THE PLANS EXAMINER. THE DEPARTMENT OF INSPECTIONS, LICENSES AND PERMITS WILL CONTACT YOU IF THERE IS A PROBLEM. IN ADDITION, ONCE THE BUILDING PERMIT IS APPROVED BY THE PLAN REVIEW DIVISION AND ALL OTHER REQUIRED SIGNATORY AGENCIES, AND THE BUILDING PERMIT IS READY FOR ISSUANCE, THE PERMIT DIVISION WILL NOTIFY THE APPROPRIATE CONTACT PERSON FOR PERMIT PICK UP. ALL PERMIT STATUS INQUIRIES SHALL BE DIRECTED TO THE PERMIT DIVISION AT 410-313-2455. CODE RELATED QUESTIONS AND PLAN REVIEW INQUIRIES SHALL BE DIRECTED TO THE PLAN REVIEW DIVISION AT 410-313-2436. PLEASE ALLOW A MINIMUM OF FIVE (5) WORKING DAYS FOR ANY PLAN SUBMITTALS TO BE REVIEWED. THANK YOU.**

**RECEIVED**  
JAN 17 2023  
LICENSES & PERMITS  
DIVISION

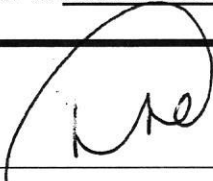Received by 

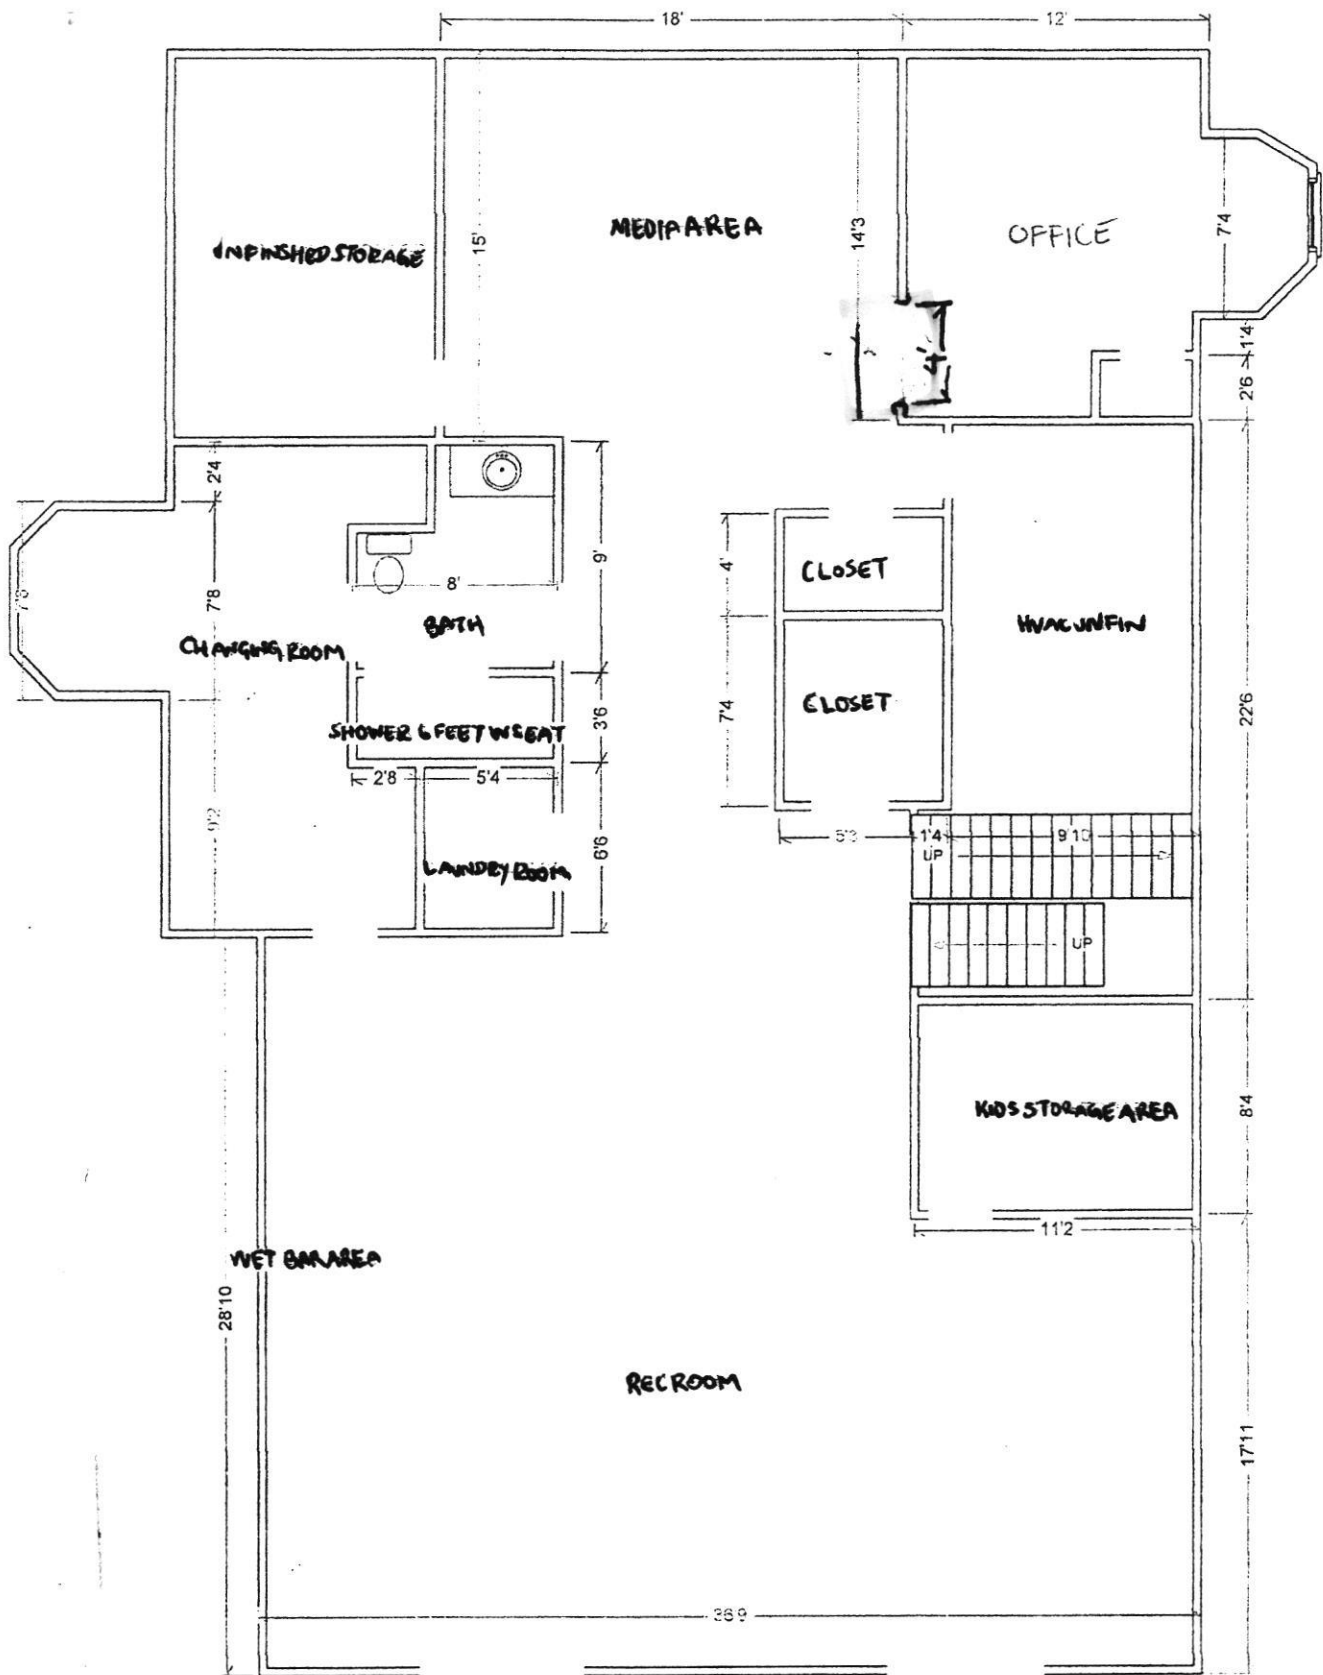

Basement  
 LIVING AREA  
 3/13/18