

Record Detail \* (This section is required.)

Permit Type	Permit Number	Opened Date
Building/Residential/Misc/Tanks	B23000307	01/30/2023

Description of Work  
SFD//INSTALL (2) 120 GAL ABOVE GROUND ASME PROPANE TANKS

[check spelling](#)

Address \* (This section is required.)

Search Reset Clear Get Parcel & Owner

Approved 1/31/23  
*[Signature]*

Street #	Street Name	Street Type	
760	MIDDLETRAIL	CT	
Unit Type	Unit #	X Coordinate	Y Coordinate
--Select--		-77.08354	39.34903
City	State	Zip Code	Primary
MOUNT AIRY	MD	21771	Yes

Parcel \* (This section is required.)

Search Reset Clear Get Address & Owner

GIS ID *	Parcel	Parcel Area	Land Value	Improved Value	Exemption Value	Plan Area
830573	408	2.36	198600	410400	211800	RURAL

Legal Description  
IMPSLOT 16CD 2.364 A[ ]760 MIDDLETRAIL CT[ ]MIDDLE TRAIL PROPERTY

[check spelling](#)

Block	Lot	Census Tract	Council Dist	Inspection Dist	Supervisor Dist	Map #	DAP Zone
	16 CD	604001	5				
Plan Area	State Tax Id	Subdivision Name					
	1404319265						
Section	Area	Tax Map					
		2					
Grid	Zoning District	ADC Map					
2-23	RC-DEO	4691-G5					
SDP No.	Final Plan No.	WP File No.					
Record Plat No.	WS Contract No.	FDP No.	Primary				
			Yes				
Owner Occupied	Year Built	Historic District					
<input type="radio"/> Yes <input type="radio"/> No	1988	<input type="radio"/> Yes <input checked="" type="radio"/> No					
Historic District Registry No.	Stat Area	Flood Plain					
	4-02	<input type="radio"/> Yes <input checked="" type="radio"/> No					
Building No							

Owner \* (This section is required.)

Search Reset Clear

Name \*  
LEE LACHMAN  
Address Line 1  
760 MIDDLETRAIL CT

Address Line 2  
 Address Line 3

Mail City: MOUNT AIRY  
 Mail State: MD  
 Mail Zip Code: 21771

Phone: 443-472-3080  
 Primary: Yes

E-mail

Cell Number  
 Fax Number

Professionals (This section is not required.)

License # \*: 20100085886  
 License Type \*: Propane Gs  
 Primary: Yes

Business Name: GREAT VALLEY PROPANE INC.

First Name: SCOTT  
 Middle Name: ERIC  
 Last Name: ANTKOWIAK

Address Line 1: 57 LANCASTER AVENUE  
 Address Line 2:

City: MALVERN  
 State: PA  
 ZIP Code: 19355-0000

Phone 1: 4104584767  
 Phone 2:  
 Fax: 4103742425

E-mail: SANTKOWIAK@TEVISPROPANE.COM

Applicant (This section is not required.)

Search As Owner As Lic. Prof As Contact

Type \*: Applicant  
 Relationship: Applicant  
 Primary: Yes

First Name: MICHELLE  
 MI:  
 Last Name: CLANCY

Full Name: MICHELLE CLANCY

Organization Name: APPLIED & APPROVED PERMITS LLC

Street Address: P.O. BOX 310  
 Address Line 2:

City: PERRY HALL  
 State: MD  
 Zip Code: 21128

Phone: 443-340-1229  
 Cell:  
 Fax:

E-mail \*: MICHELLE@APPLIEDANDAPPROVED.COM

Addtl Info

Est Construction Cost \*: 500  
 Housing Units \*: 0  
 Number of Buildings \*: 0  
 Public Owned: No

Construction Type: --Select--

TANK INFORMATION

RESIDENTIAL TANK INFORMATION

Capital Project-No Fee \*:  Yes  No  
 Capital Project Number:   
 Fee Exempt \*:  Yes  No  
 Roadside Tree Project Permit \*:  Yes  No  
 Roadside Tree Permit #:

Existing Use \*: SFD  
 Number of Tanks Installed \*: 2  
 Number of Tanks Removed \*: 0

Water Supply Sewage Disposal Expiration Date Relocate Existing Tank \*

P42180 A 31802

1760 Middle Trail Ct  
(Former 16277 or 16877 Old Fred Rd)

Lot 16 A-D


B00127359

760 Middle Trail Court  
Aldy Addition - Detached Garage

No Conflict with  
well or Septic. Recommended  
approval. RPP 11/9/00

Approved for LP tank  
B2-3000 307  
1/31/23

COPY

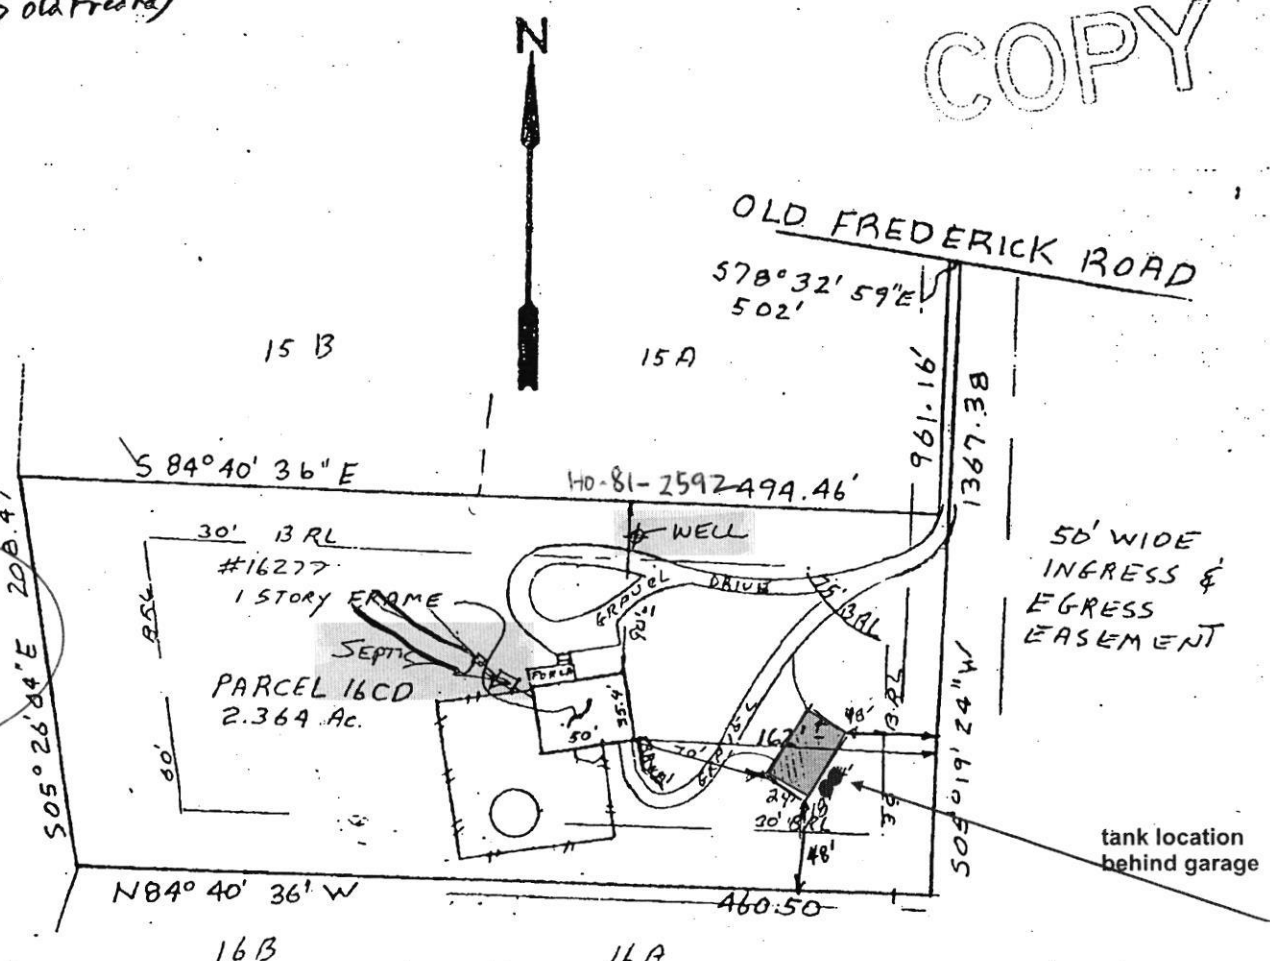

This is to certify that I have surveyed  
the property shown hereon for the  
purpose of locating the improvements  
thereon and that the improvements  
are located as shown



LOCATION SURVEY  
760 MIDDLETRAIL COURT  
ATH ELECTION DISTRICT  
HOWARD COUNTY MD

NTT ASSOCIATES, INC.  
16205 Old Frederick Road  
Mt. Airy, Maryland 21771

Scale 1"=100'  
Date 12-7-91  
Field By JCH  
Drawn By TJA

THIS PLAT SHOWS ONLY THAT THE IMPROVEMENTS ARE  
CONTAINED WITHIN THE OUTLINES OF THE LOT AND IS  
NOT TO BE USED TO ESTABLISH PROPERTY LINES