


Menu Refine Search GIS Help My Filters

Showing 1 of 1

<input type="checkbox"/> Permit #	Status	Record Type Alias	Street #	Street Name	Type	Unit Type	Unit #	City
<input type="checkbox"/> <u>B23000901</u>	Review In Process	Residential Pool or Spa Permit	15685	OLD FREDERICK	RD			WOODB


Page of 1

Approved Septic System Plan
 Howard County Health Department
D. Bernard 3-21-23
 Signature Date

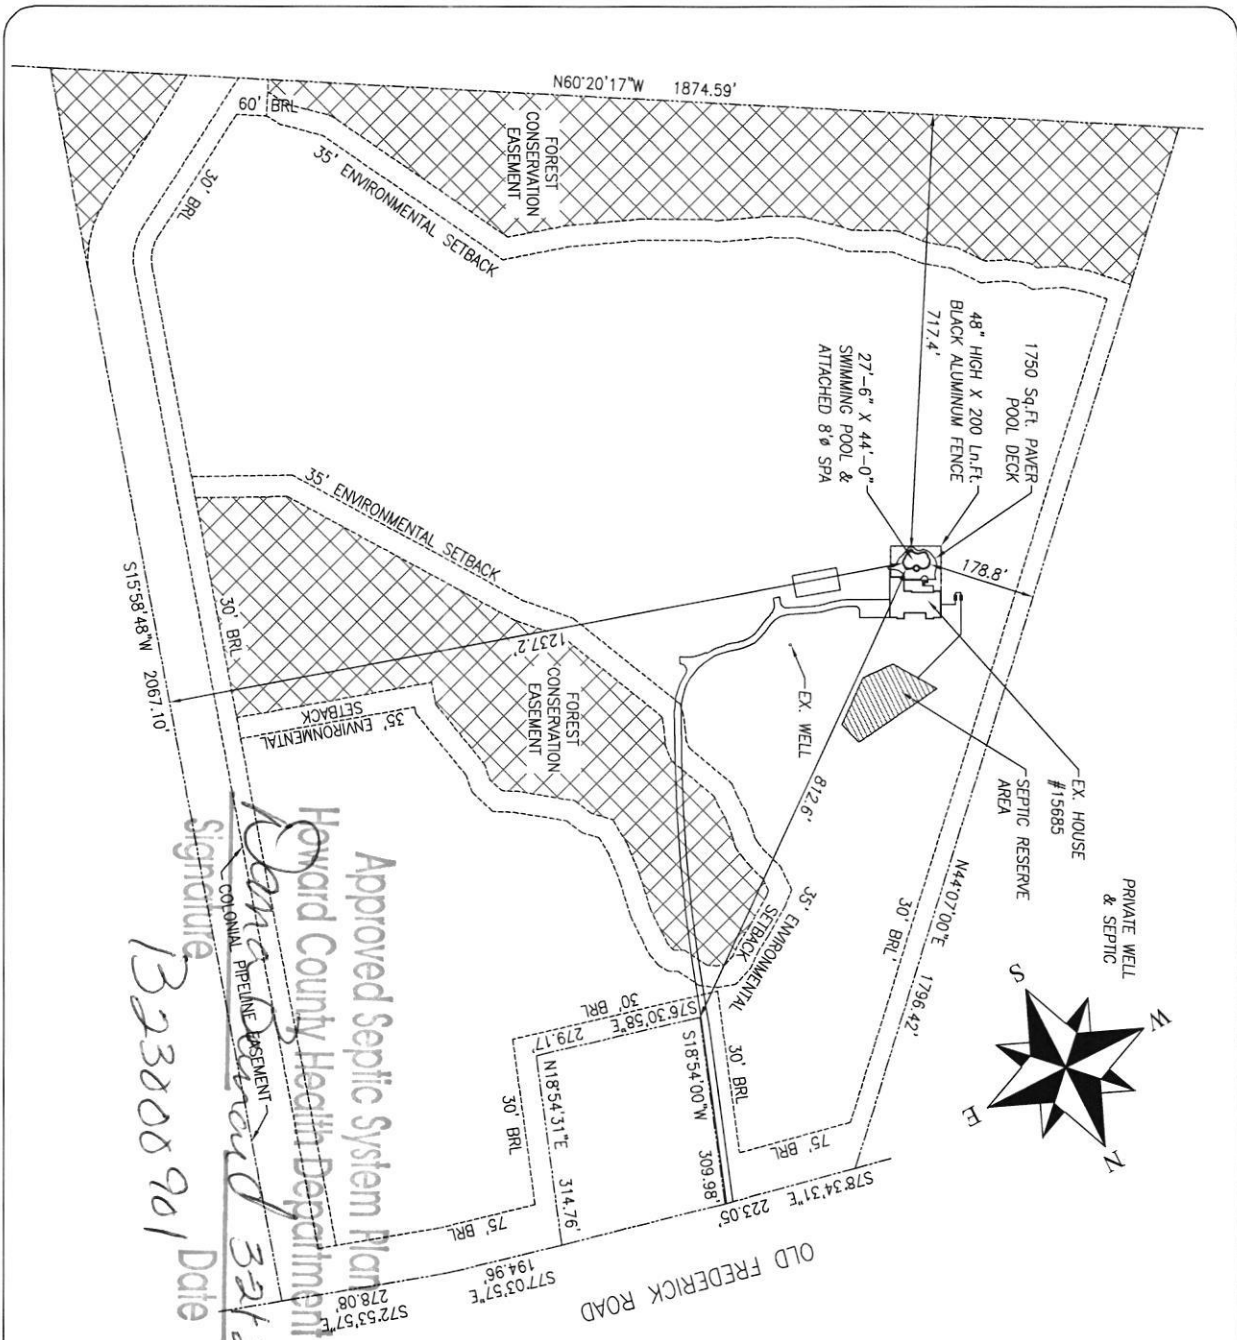

Approved Septic System Plan
 Howard County Health Department
 Signature: *[Signature]*
 Date: 3/21/23
 1323008901

VICINITY MAP

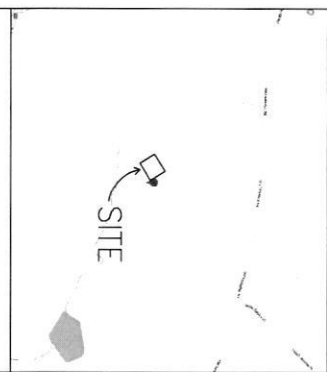

DIRECTIONS TO SITE

POOL DATA

DIMENSIONS	27'-0" X 44'-0" FREESTORM
PERIMETER	132 Ln.Ft.
SURFACE AREA	925 SQ.FT.
GALLONAGE	36,000 GALLONS
DEPTHS	3'-6" TO 5'-0" TO 8'-0"
FILTER RATE	75 GPM
TURNOVER TIME	8 HOURS
POOL DECK AREA	1750 SQ.FT.

JOB NOTES

PROPERTY OWNER: BRUN & BOBER WYNNE
 PROPERTY OWNER ADDRESS: WOODBINE RD 21797
 HOME PHONE: 410-881-0865 (VA)
 CELL PHONE: 410-881-0865 (VA)
 LOT NUMBER: 15685 OLD FREDERICK ROAD
 SUBDIVISION NAME: TAX MAP: 0008
 GRID & PARCEL: GRID 0001, PARCEL 0002
 TAX ACCOUNT NUMBER: 04-31263
 ELECTION DISTRICT: 4
 ZONING: UNLITES, WELL & SEPTIC

SITE PLAN A


REVISIONS

Sheet	1	Of	2
Job:	ATL2022-0160		
Date:	03/08/2023		
Scale:	1"=200'		
Drawn:			


Wynne Residence
 15685 Old Frederick Road
 Woodbine, Maryland 21797
 4th Election District, Howard County



P.O. Box 148 - Mt. Airy, Maryland 21771
 Office: 301-829-4004 · Fax: 301-829-4770
 Toll Free: 866-757-POOL
 www.atlanticpools.net

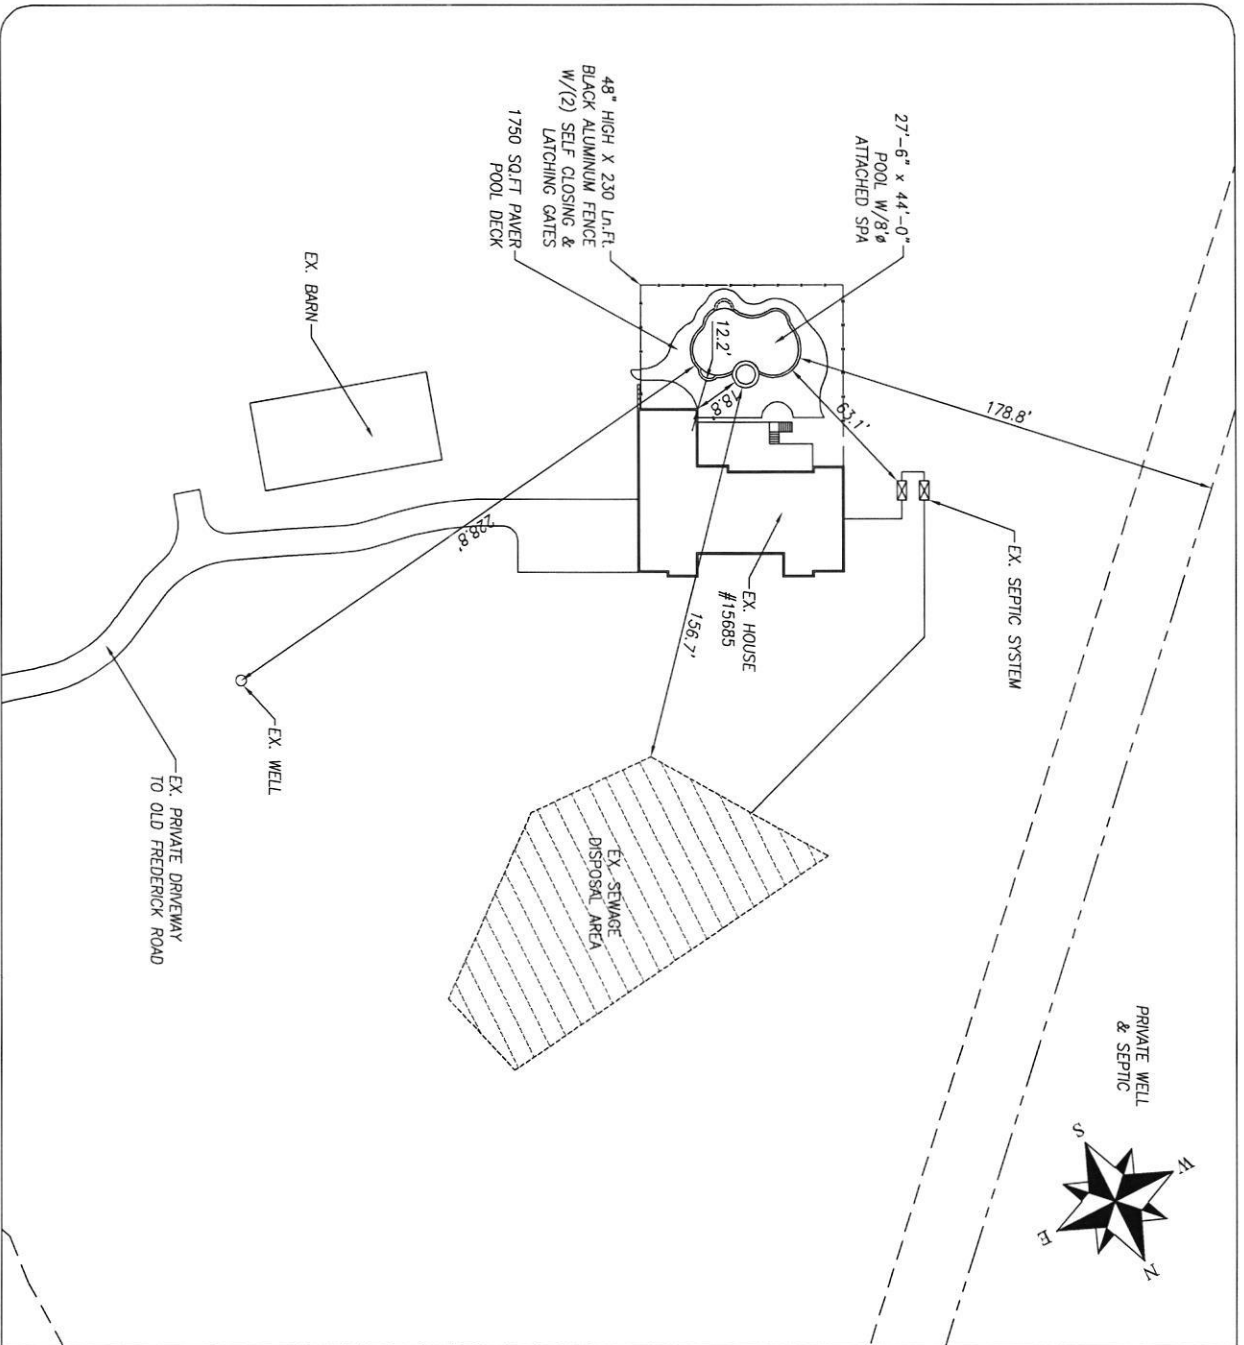

VICINITY MAP

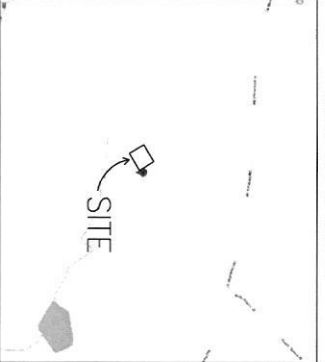

DIRECTIONS TO SITE

1-1/2 MILE WEST TO DIRT ONTO 1-1/4 MILE WOODBINE ROAD, RIGHT, GO APPROXIMATELY 1/2 MILE TO A 9/7 ON Rt. 508 OLD FREDERICK ROAD. FOLLOW 1/4 MILE TO A 9/7 ONTO PRIVATE DRIVE. ● 15685 OLD FREDERICK ROAD.

POOL DATA

DIMENSIONS	27'-0" X 44'-0" FREEFORM
PERIMETER	132 Ln.Ft.
SURFACE AREA	925 Sq.Ft.
GALLONAGE	36,000 GALLONS
DEPTHS	3'-6" TO 5'-0" TO 8'-0"
FILTER RATE	75 GPM
TURNOVER TIME	8 HOURS
POOL DECK AREA	1750 Sq.Ft.

JOB NOTES

PROPERTY OWNER: BRAY & KAREN WYNNE
 PROPERTY OWNER ADDRESS: 5685 OLD FREDERICK ROAD
 WOODBINE, MD 21797
 HOME PHONE: 410-891-0865 (M/F)
 OFFICE PHONE: wynnresidence@gmail.com,
 CELL PHONE: wynnresidence@gmail.com
 LOT NUMBER:
 SUBDIVISION NAME: 15685 OLD FREDERICK ROAD
 TAX MAP: 0008
 ORD & PARCEL: ORD 0001, PARCEL 0002
 TAX ACCOUNT NUMBER: 04-3153A3
 ELECTION DISTRICT: 4
 ZONING:
 UTILITIES: WELL & SEPTIC

SITE PLAN B

REVISIONS



P.O. Box 148 • Mt. Airy, Maryland 21771
 Office: 301-829-4004 • Fax: 301-829-4770
 Toll Free: 866-757-POOL
 www.atlanticpools.net

Wynne Residence
 15685 Old Frederick Road
 Woodbine, Maryland 21797
 4th Election District, Howard County

Date:	03/08/2023
Scale:	1" = 50'
Drawn:	
Job:	ATL2022-0160
Sheet:	2
Of:	2