

Bureau of Environmental Health
 8930 Stanford Boulevard, Columbia, MD 21045
 Main: 410-313-2640 | Fax: 410-313-2648
 TDD 410-313-2323 | Toll Free 1-866-313-6300
www.hchealth.org
 Facebook: www.facebook.com/hocohealth

Maura

J. Rossman, M.D., Health Officer

RECEIPT DATE: 8/18/20 **ONSITE SEWAGE DISPOSAL SYSTEM** P 567946

INSTALLATION APPROVAL DATE: 09/04/2020 **PERMIT** A _____

MINOR REPAIR

PROPERTY ADDRESS: 16005 Frederick Road

SUBDIVISION: _____ LOT: _____ TAX ID: 04-327942

CONTRACTOR: Dirt Doctor EMAIL: _____

CONTRACTOR ADDRESS: 13877 Foggy Bottom Court, 2nd fl, Woodbine, MD 21797 PHONE: 443-745-8081

PROPERTY OWNER: Orion Land Development LLC., Paul Sill EMAIL: _____

OWNER ADDRESS: 11130 Doverdale Court, Marriottsville, MD 21104 PHONE: _____

NUMBER OF BEDROOMS: _____ SEPTIC TANK SIZE: _____ DRAINFIELD SIZE/TYPE: _____

LOCATION:	
NOTES:	

ISSUED BY: _____ ISSUE DATE: _____ EXPIRATION DATE: _____

- NOTE: CONTRACTOR MUST SCHEDULE AN INSPECTION AND GAIN APPROVAL OF ALL COMPONENTS PRIOR TO COVERING
- NOTE: AN ELECTRICAL PERMIT IS REQUIRED FOR INSTALLATION OF ANY ELECTRICAL COMPONENTS OF THE SYSTEM
- NOTE: MDE RECOMMENDS SEPTIC TANKS, BAT, AND OTHER PRETREATMENT UNITS BE PUMPED AT A FREQUENCY ADEQUATE TO ENSURE THAT SOLIDS ARE NOT DISCHARGED TO THE DISPOSAL AREA

NEITHER THE HOWARD COUNTY COUNCIL NOR THE HEALTH DEPARTMENT IS RESPONSIBLE FOR THE SUCCESSFUL OPERATION OF ANY SYSTEM. PERMITTEE RESPONSIBLE FOR OBTAINING FINAL APPROVAL ON THIS PERMIT. CALL 410-313-1771 FOR INSPECTION OF SEPTIC SYSTEM.



HOWARD COUNTY HEALTH DEPARTMENT

67946

DATE 8/18/20

PS

Received From Sell Engineering PHONE # _____

Group

For Well Septic - ~~16005 Frederick Rd~~

16005 Frederick Rd.

CASH
 CHECK

NO. 3043

Fifty-Five Dollars

\$ 55.00

Received By J King

Maura J. Rossman, M.D., Health Officer

INFORMATION FORM - SEPTIC SYSTEM REPAIR/UPGRADE

Reason for Request:

- Failing System
- System relocation for proposed addition
- System upgrade for proposed addition
- Inadequate treatment zone
- Collapsed septic tank
- Collapsed drywell

Existing system design

- Drywell
- Trench
- Mound
- Unknown
- Other: _____

Is discharge surfacing on the ground?

- Yes
- No

Additional Comments:

Please consider this request somewhat urgent, as a re-clog in the line will lead to back up. The cracked line was diagnosed after a back up was discovered in the crawl space of the building.

Has the septic tank been pumped within the last month?

- Yes Date pumped: 11.2.2019
- No

Was a visual inspection of the septic tank and/or drain fields conducted?

- Yes Explain observation: Cracked cast iron sewage line between building and septic tank (which has created a concave belly in the line. To be replaced with PVC piping
- No

Was a visual inspection of the sewage line conducted?

- Yes
- No

Blockage Leading to the field

- Yes Explain Cracked cast iron causing a belly in the line. Recent camera-ing of the line cleared the clog but it will redevelop.
- No

*For REPAIRS, are the owners proposing, or do they plan to add in the future any additions or modifications to the property, i.e. pools, living space additions, garages, etc? This information must be disclosed at the time of this application. The Health Department will not be able to accommodate requests in the field for property modifications unrelated to the repair request. Such requests may require an additional fee, testing, and submittal of a Percolation Certification Plan, if the property does not meet current Code and Regulations.

Septic Contractor: Dirt Doctor Contractor's Phone: 443.745.8081

Contractor's Address: 13877 Foggy Bottom Court, Mt. Airy, MD 21771

Property Address: 16005 Frederick Road, 2nd Floor Woodbine, MD 21797 County File: _____

Subdivision: N/A Lot: 33/83 Year Built: 1819

Owner's Name: Orion Land Development, LLC, Paul Sill Existing bedrooms: N/A

Name of previous owners: Cissel Partnership #1, LLP, Steve Cissel Existing bedrooms: N/A

3370 Jennings Chapel Road, Woodbine, MD 21797 Proposed bedrooms: N/A

*A Sanitarian will be in contact within three business days, depending upon the urgency of the situation, to coordinate the scheduling/review of the repair or upgrade.

Prior to scheduling inspections, scaled plans should be submitted to clarify the nature of the addition.

Print out a copy of Real Property Data via Dept. of Taxation website _____ Indexed file found _____


If soil/site conditions are limited and sewer and/or Metro District status is not conducive to connection, the Sanitarian may recommend pursuit of Emergency Sewer Extension or Emergency Metro District Inclusion. The Owner should contact the Bureau of Utilities for details.

No permit is to be issued nor inspection to be scheduled without prior fee collection at the office unless an emergency exists.

The contractor is to notify the office of the emergency as soon as possible.

2/2020

NOT TO SCALE

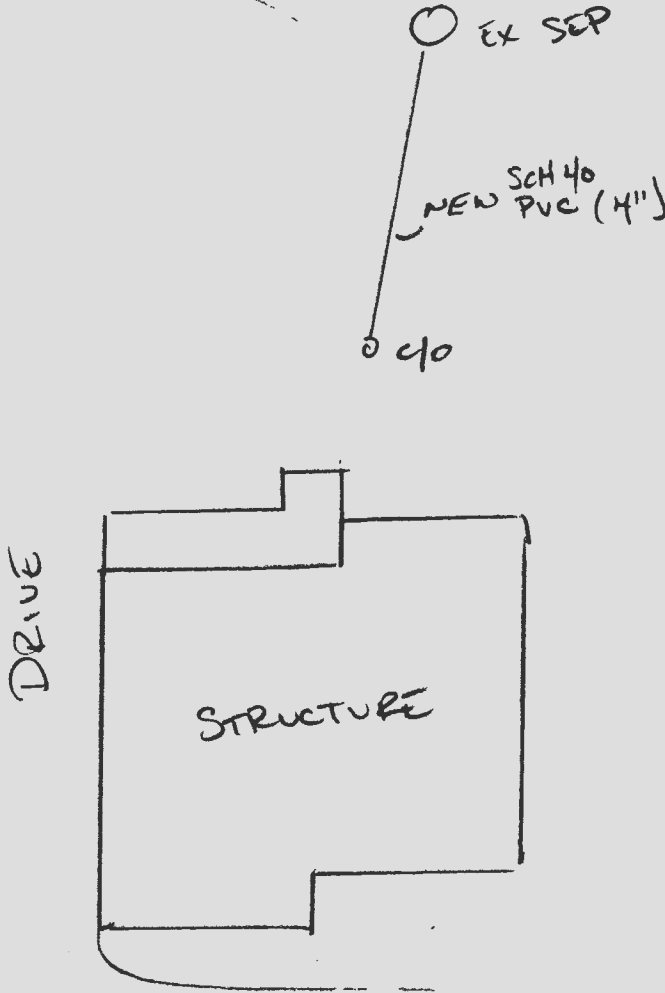

ROAD NAME
FREDERICK ROAD

TRENCH/DRAINFIELD DATA


WIDTH	INLET	BOTTOM
_____	_____	_____
NUMBER OF TRENCHES _____		
TOTAL LENGTH _____		
ABSORPTION AREA _____		
DISTRIBUTION BOX LEVEL _____		
DISTRIBUTION BOX BAFFLE _____		
DISTRIBUTION BOX PORT _____		

SEPTIC TANK DATA

EXISTING	SEPTIC TANK 1 LEVEL _____
	MANUFACTURER _____
	CAPACITY _____ GAL
	SEAM LOC _____
	TANK LID DEPTH _____
	BAFFLES _____
	BAFFLE FILTER _____
	MANHOLE LOC _____
	6" PORT LOC _____
	WATERTIGHT TEST _____
SLOTTED _____	
DATE ON LID _____	
PUMP/SEPTIC TANK LEVEL _____	
MANUFACTURER _____	
CAPACITY _____ GAL	
SEAM LOC _____	
TANK LID DEPTH _____	
BAFFLES _____	
BAFFLE FILTER _____	
MANHOLE LOC _____	
6" PORT LOC _____	
WATERTIGHT TEST _____	
SLOTTED _____	
DATE ON LID _____	

PRE-CONSTRUCTION:

INSTALLATION: 09/04/2020 REPLACE SEWERLINE W SCH 40 PVC. SMC REPORTED
CAST IRON. CONNECTED TO EX. ST.

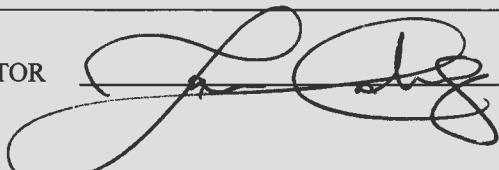FINAL INSPECTOR  DATE OF APPROVAL 09/04/2020