

Tax
6/24/84

ge _____ of _____
te _____

FIELD DATA SHEET
COUNTY WELL YIELD TEST

Review _____

1 Permit No. H0-81-0580
 Location of property (road) Brown's Bridge Rd. Election District _____
 Division HERITAGE WOODS Lot 92 Block _____ Plat _____ Sec. _____
 Driller _____ Owner DAVID BARROW

Depth of well 200'
 Distance of measuring point (M.P.) above ground 2'
 Static water level (S.W.L.) below M.P. 10'

High rate pumping--reservoir drawdown
 Time pump started 11:15 AM Pumping rate 10 Gpm
 Total time 60 MIN. to reach pumping water level 140 ft. below M.P.
 Recovery pump test data-observations to be recorded every 15 minutes.

TIME	WATER LEVEL below M.P.	PUMPING RATE time to fill gallon bucket	FLOW METER READING (if used)	CALCULATED FLOW gallons per minute
10:30	135	60 SEC		
10:45	130	60 SEC		5
1:00	130	50 SEC		6
1:15	130	50 SEC		6
1:30	130	50 SEC		6
1:45	130	50 SEC		6
2:00	130	50 SEC		6
2:15	130	50 SEC		6
2:30	130	50 SEC		6
2:45	130	50 SEC		6
3:00	130	50 SEC		6
3:15	130	50 SEC		6

pump SET AT 190'
 TESTED by BLAKE

WELL PUMP INSPECTION

Owner's Name: DAVID BARROW

Address: 7532 NORTH ARBORY WAY
LAUREL, MD 20707

Location of Property:

7297 BROWN BRIDGE RD
FULTON, MD 20759

Plumber or Certified Pump Installer:

ROBERT S. BECK

Phone Number: 421-9279

License Number: 2163

Well Tag Number:

Receipt Number:

34685

Date:

12/18/84

Comments:


Inspection:

Date Well Pump Inspection was approved:

Inspector:

Heritage Woods

VICINI
SCALE

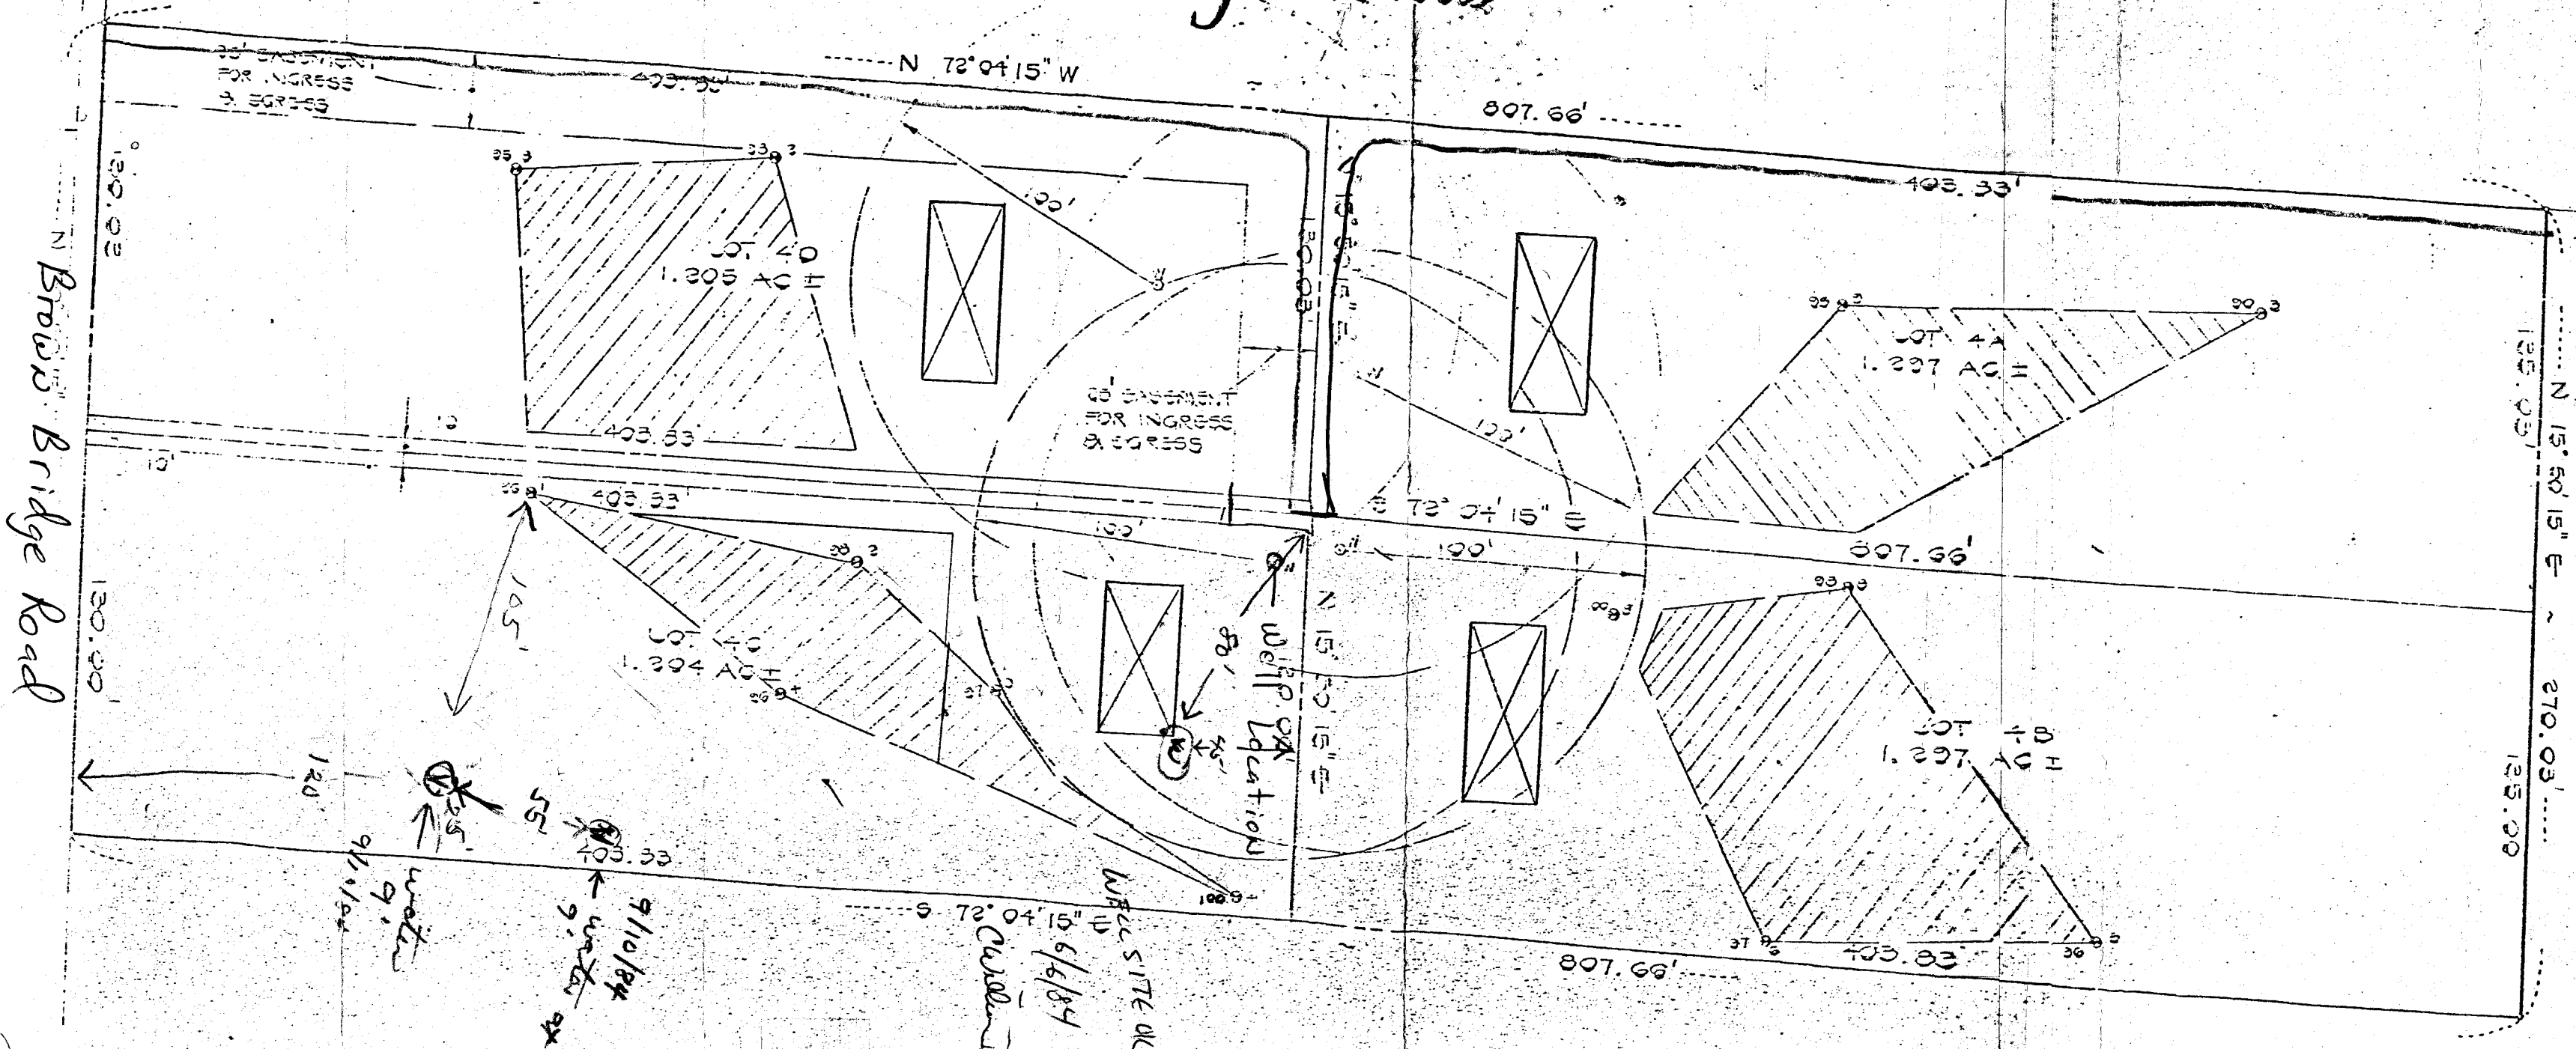

N Brown Bridge Road

RECEIVED
HOWARD COUNTY
HEALTH DEPT.
ELICOTT CITY, MD.
APR 30 10 14 AM '84

Jack C. Fryrock Co.
Bob Fryrock
988-9270

well ban → Cross reference

12:00 Noon Trs

1997 MAY -1 P 3:50
HOWARD CO. HEALTH DEPT.
ENVIRONMENTAL HEALTH