


Record Detail * (This section is required.)

Permit Type Building/Residential/Misc/Tanks	Permit Number B24001381	Opened Date 04/17/2024
Description of Work SFD//INSTALL (1) ONE 500 GALLON UNDERGROUND PROPANE TANK		

[check spelling](#)

Address * (This section is required.)

Search	Reset	Clear	Get Parcel & Owner		
Street # 14620	Street Name BURNTWOODS	Street Type RD			
Unit Type --Select--	Unit #	X Coordinate -77.02166	Y Coordinate 39.28233		
City GLENWOOD	State MD	Zip Code 21738	Primary Yes		

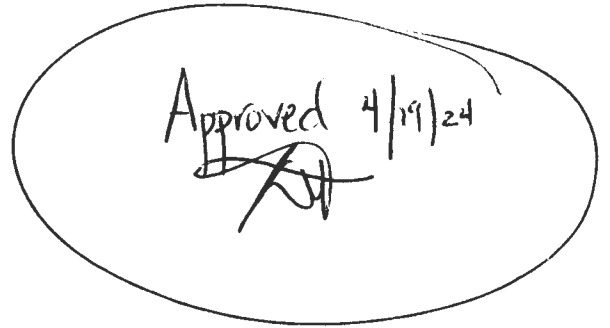

Parcel * (This section is required.)

Search	Reset	Clear	Get Address & Owner			
GIS ID * 900274	Parcel 235	Parcel Area 3	Land Value 250000	Improved Value 618400	Exemption Value 368400	Plan Area RURAL
Legal Description IMPSLOT 10 3.000 A[]14620 BURNTWOODS RD[]ELLERSLIE ESTATES						

[check spelling](#)

Block 10	Census Tract 605601	Council Dist 5	Inspection Dist	Supervisor Dist	Map #	DAP Zone
Plan Area	State Tax Id 1404348842	Subdivision Name ELLERSLIE ESTATES				
Section	Area	Tax Map 21				
Grid 21-4	Zoning District RR-DEO	ADC Map 4812-G5				
SDP No.	Final Plan No.	WP File No.				
Record Plat No. 8487	WS Contract No.	FDP No.		Primary Yes		
Owner Occupied <input type="radio"/> Yes <input type="radio"/> No	Year Built 1990	Historic District <input type="radio"/> Yes <input checked="" type="radio"/> No				
Historic District Registry No.	Stat Area 4-06	Flood Plain <input type="radio"/> Yes <input checked="" type="radio"/> No				
Building No						

Owner * (This section is required.)

Search	Reset	Clear
Name * VOGT RICHARD C		
Address Line 1 14620 BURNTWOODS RD		

Address Line 2

Address Line 3

Mail City
 GLENWOOD
Phone
 410-239-9515
E-mail

Mail State
 MD
Primary
 Yes

Mail Zip Code
 21738

Cell Number

Fax Number

Professionals (This section is not required.)

License # *
 20020089549
License Type *
 Plumb/Gas
Primary
 Yes

Business Name
 MODERN COMFORT SYSTEMS LLC
First Name
 FRANK
Middle Name
 E
Last Name
 HENSLEY
Address Line 1
 P.O. BOX 26
Address Line 2

City
 WESTMINSTER
State
 MD
ZIP Code
 21157-0000
Phone 1
 4432777364
Phone 2

Fax

E-mail
 FHENSLEY@MODERNCOMFORTSYSTEMS.COM

Applicant (This section is not required.)

Search
 As Owner
 As Lic. Prof
 As Contact

Type *
 Applicant
Relationship
 Applicant
Primary
 Yes

First Name
 MICHELLE
MI

Last Name
 CLANCY
Full Name
 MICHELLE CLANCY
Organization Name
 APPLIED & APPROVED PERMITS LLC
Street Address
 P.O. BOX 310
Address Line 2

City
 PERRY HALL
State
 MD
Zip Code
 21128
Phone
 443-340-1229
Cell

Fax

E-mail *
 MICHELLE@APPLIEDANDAPPROVED.COM

Adttl Info

Est Construction Cost *
 900
Construction Type
 --Select--

Housing Units *
 0

Number of Buildings *
 0

Public Owned
 No

TANK INFORMATION

RESIDENTIAL TANK INFORMATION

Capital Project-No Fee *
 Yes
 No
 Capital Project Number
 Fee Exempt *
 Yes
 No
 Roadside Tree Project Permit *
 Yes
 No
 Roadside Tree Permit #


Existing Use *
 SFD
Number of Tanks Installed *
 1
Number of Tanks Removed *
 0
Water Supply
Sewage Disposal
Expiration Date
Relocate Existing Tank *

4/19/2024

LOT 10
3.000 AC.

Approved for LP tank
B24001381

4/19/24

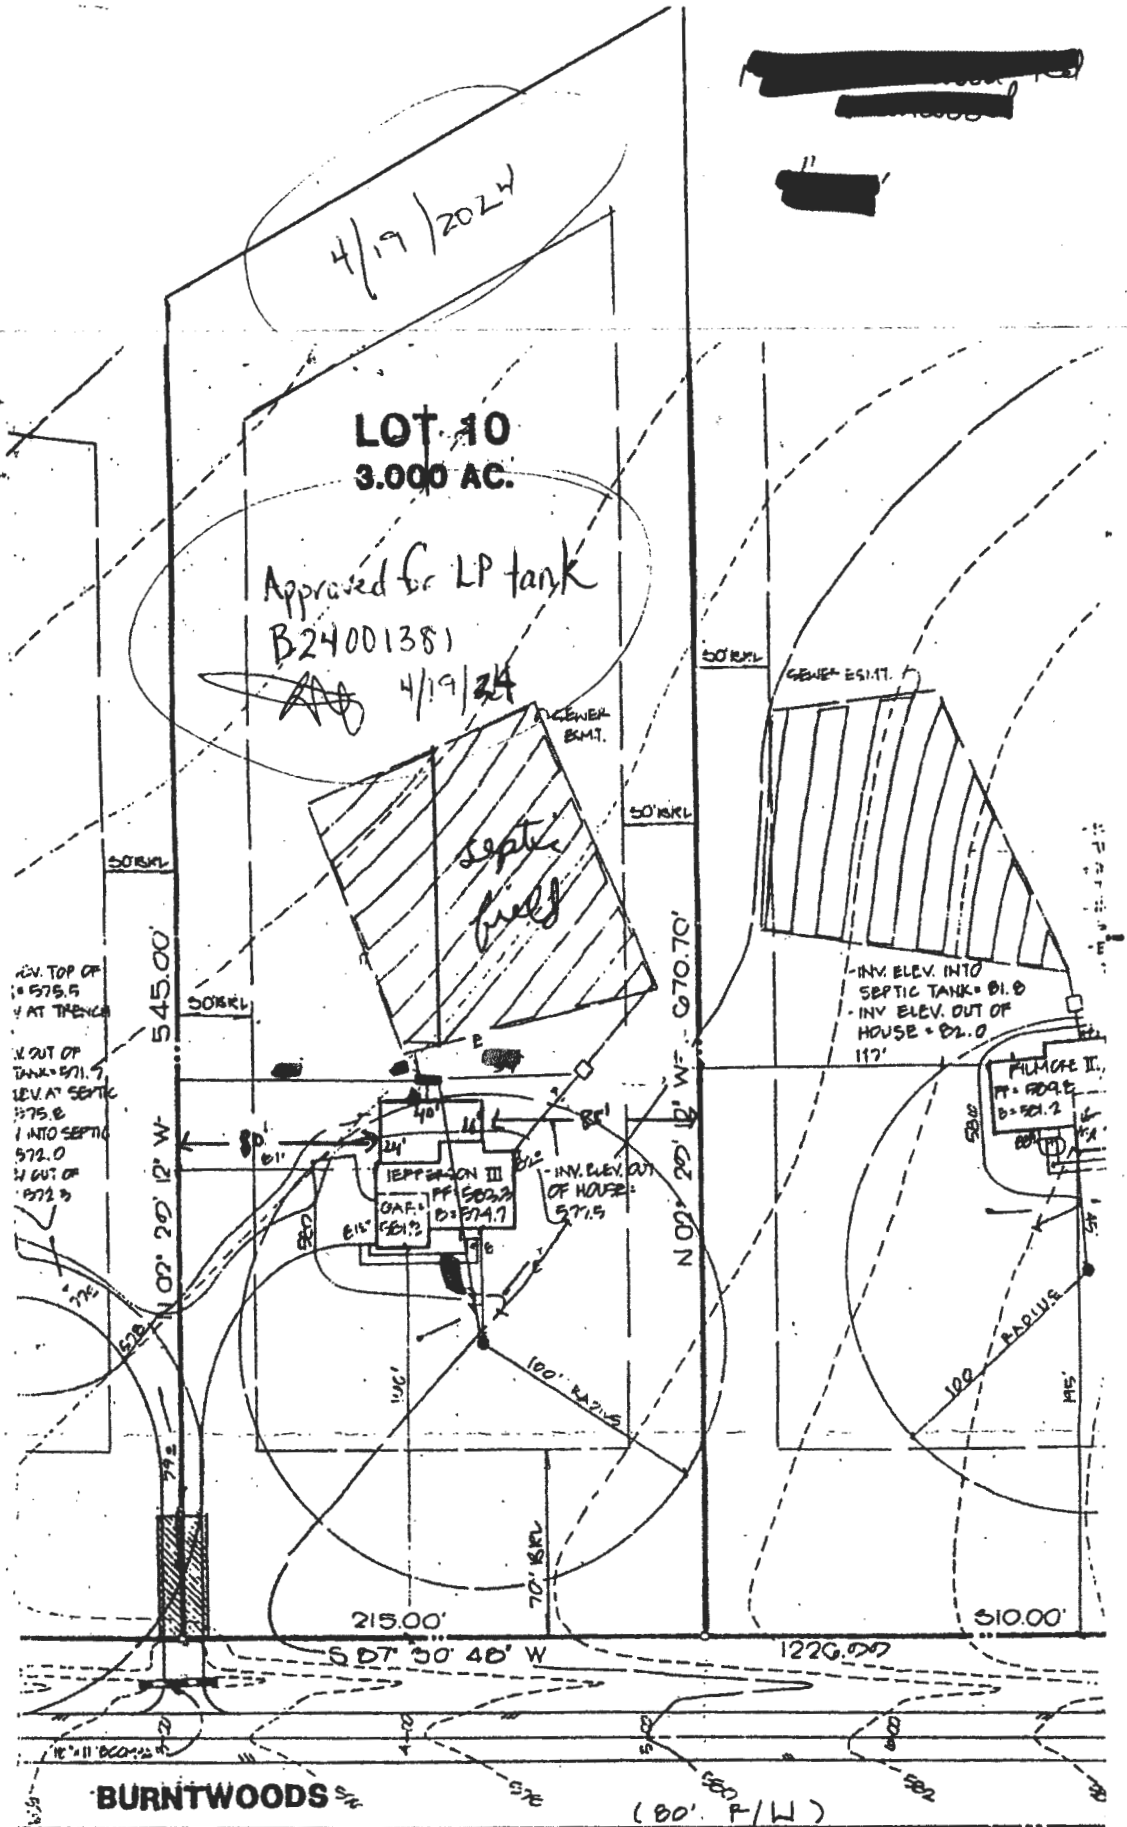

INV. TOP OF
 TANK = 575.5
 AT TRENCH
 INV. OUT OF
 TANK = 571.7
 INV. AT SEPTIC
 TANK = 575.8
 INV. INTO SEPTIC
 TANK = 572.0
 INV. OUT OF
 TANK = 572.5

INV. ELEV. INTO
 SEPTIC TANK = 61.0
 INV. ELEV. OUT OF
 HOUSE = 62.0
 117'

INV. ELEV. OUT
 OF HOUSE =
 571.5

BURNTWOODS SW

Richard Christou

Revised Plat #8487

60 scale 10/19/90

[Hatched Box] - 20' x 50' PRIVATE USE IN
 COMMON EASEMENT FOR
 INGRESS & EGRESS TO LOT

AK TO SIGN