

Record Detail * (This section is required.)

Permit Type Building/Residential/Alteration/SFD Permit Number B24002525 Opened Date 07/08/2024

Description of Work SFD/ Finish unfinished basement by adding Home theater, Prayer room, Gym, & bathroom**SLEEPING ROOMS ARE NOT PERMITTED UNLESS EGRESS IS MET, SMOKE DETECTORS REQUIRED, SUBJECT TO FIELD INSPECTION**

[check spelling](#)

4 BDR → 166'
180' existing
2000 GAL tank

Address * (This section is required.)

Search Reset Clear Get Parcel & Owner

Street # 14886 Street Name MICHELE Street Type DR

Unit Type -Select- Unit # X Coordinate -77.01678 Y Coordinate 39.25222

City GLENELG State MD Zip Code 21737 Primary Yes

Need updated floor plans
JAS 7/16/24

Parcel * (This section is required.)

Search Reset Clear Get Address & Owner

GIS ID *	Parcel	Parcel Area	Land Value	Improved Value	Exemption Value	Plan Area
927335	114	1.19	278100	1104100	826000	RURAL

Legal Description IMPSPLOT 48 1.197 A[]14886 MICHELE DR[]THE WARFIELDS II S2 RSB

New floor plans
OK. Approved.

[check spelling](#)

Block	Lot	Census Tract	Council Dist	Inspection Dist	Supervisor Dist	Map #	DAP Zone
	48	605101	5				

Plan Area State Tax Id 1405452198 Subdivision Name The Warfields II

Section Area Tax Map 21

Grid Zoning District RC-DEO ADC Map 4812-H10

SDP No. Final Plan No. F-07-040 WP File No.

Record Plat No. 20250 WS Contract No. FDP No. Primary Yes

Owner Occupied Year Built 2011 Historic District Yes No

Historic District Registry No. Stat Area 5-01 Flood Plain Yes No

Building No

JAS 8/11/24

Owner (This section is not required.)

Search Reset Clear

Name * KODIP

Address Line 1 14886 MICHELE DR

Address Line 2

Address Line 3

Mail City GLENELG


Mail State MD

Mail Zip Code 21737

Phone 251-375-6337


Primary Yes

E-mail

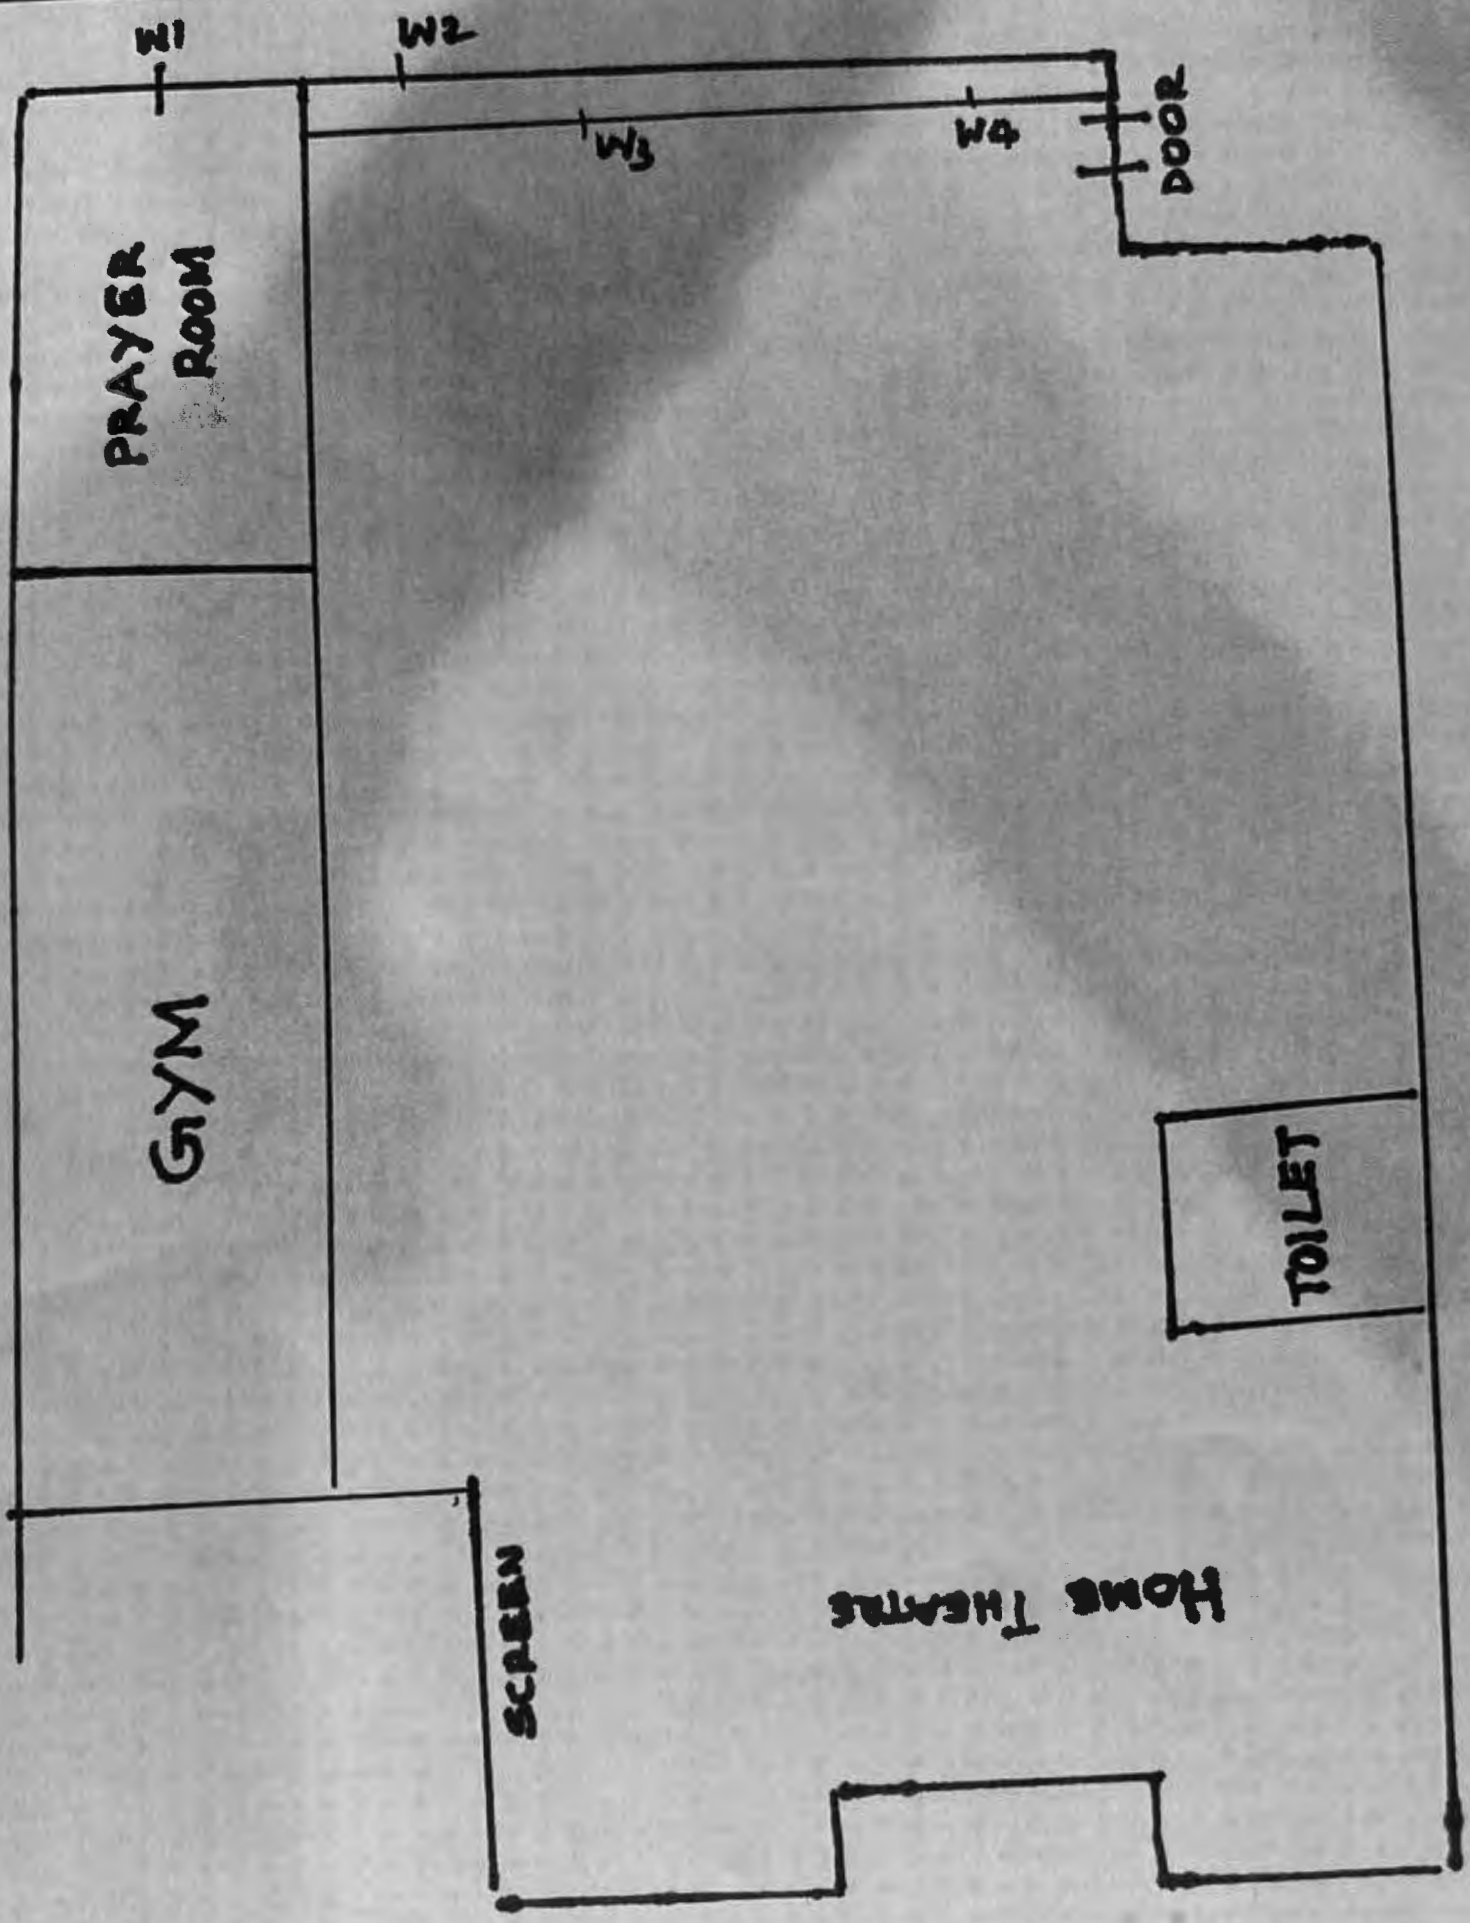


Revised Plans

Proposed
BASEMENT
FLOOR PLAN

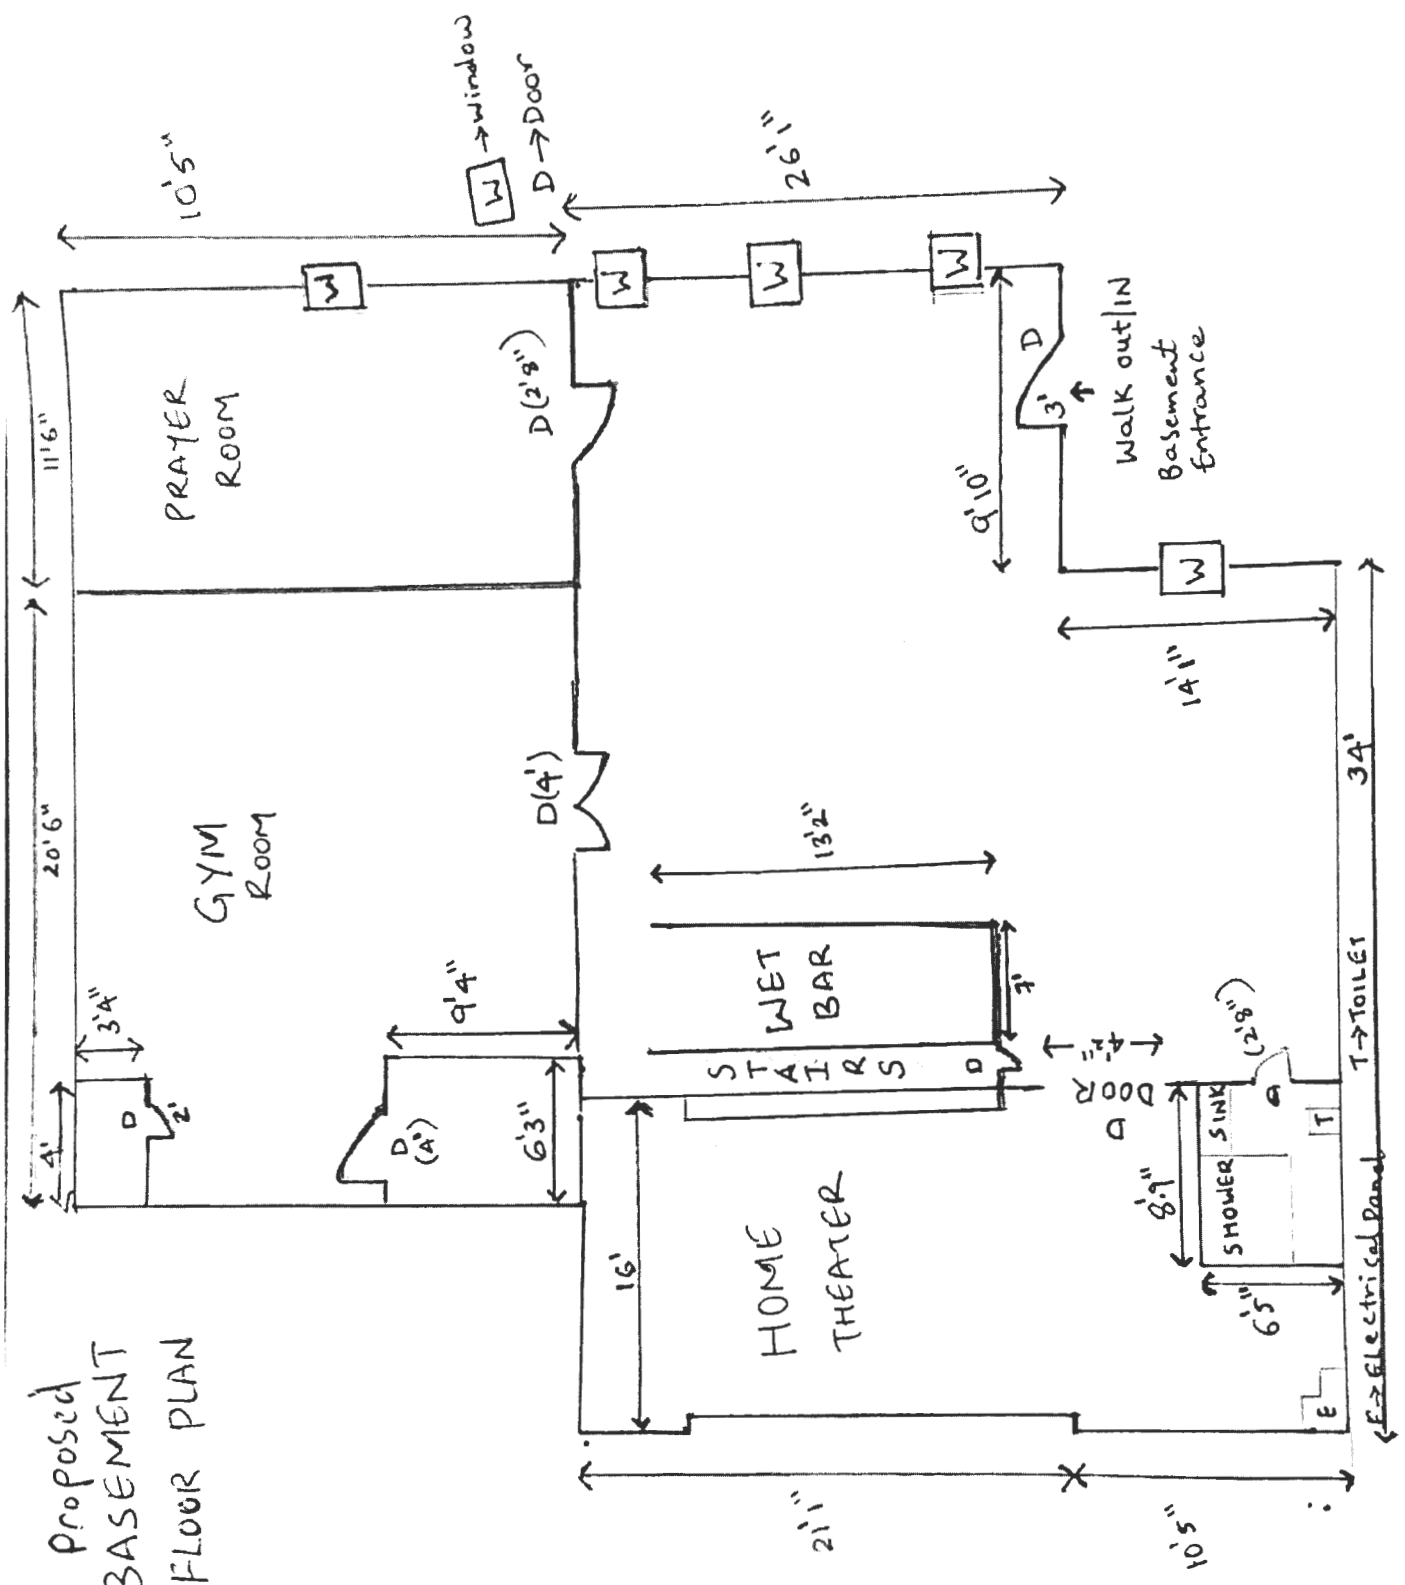

SECOND STORY

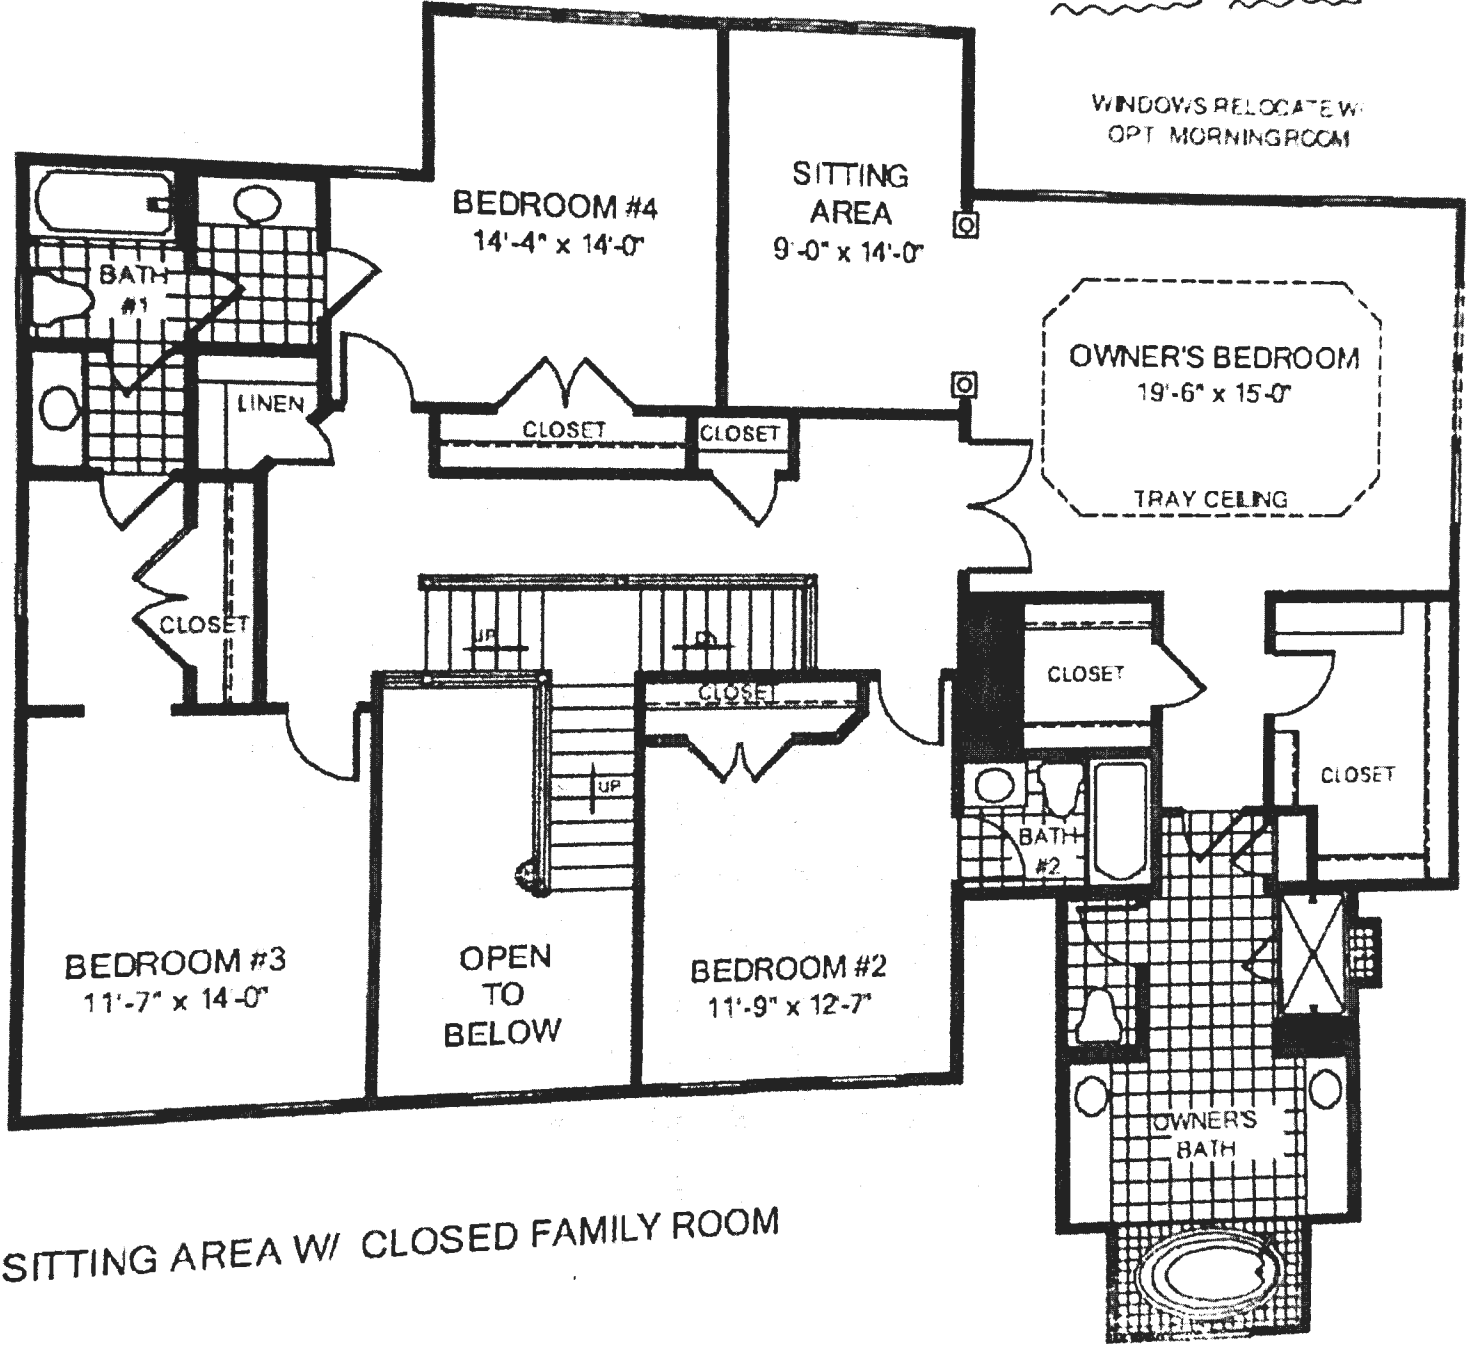

SITTING AREA W/ CLOSED FAMILY ROOM