


Approved Septic System Plan
 Howard County Health Department

Bernard
 Signature
 8-7-24
 Date
 Approved as shown

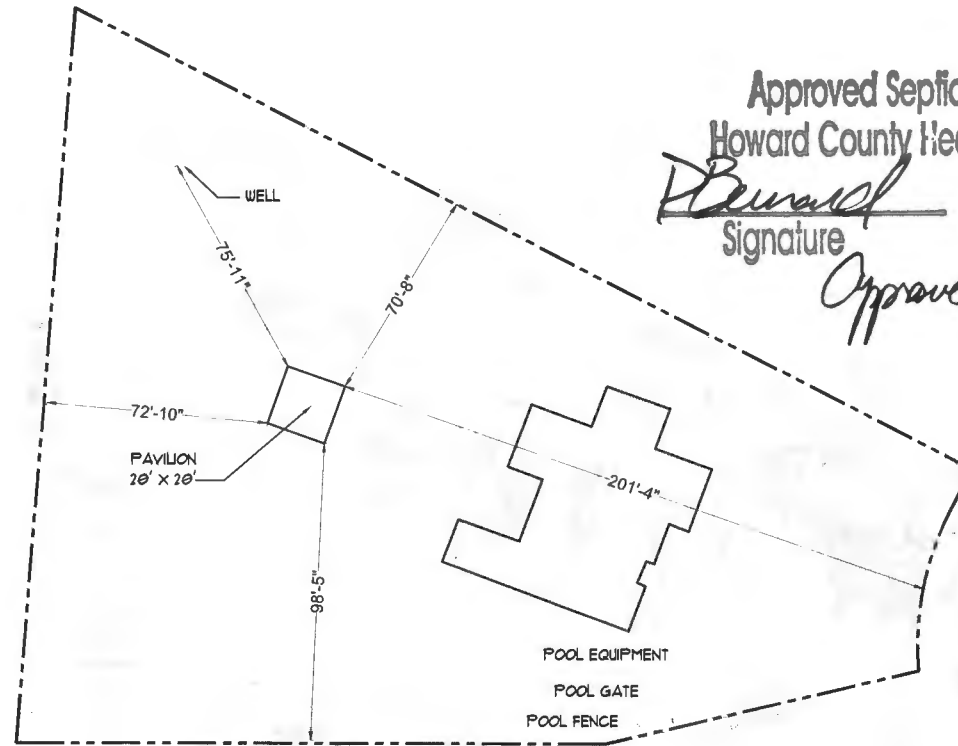

Elite Pools

400 EAST PRATT STREET, SUITE 200
 BALTIMORE, MARYLAND 21202
 410-454-7846 OFFICE
 WWW.ELITEPOOLS.COM

YOON RESIDENCE

10536 PUDDING LANE
 ELLICOTT CITY, MD 21042

NO.	REVISIONS	DATE

PAVILION PERMIT

DATE: 07/27/24
 SCALE: 1"=40'-0"

SHEET

L3

Record Detail * (This section is required.)

Permit Type	Permit Number	Opened Date
Building/Residential/Misc/Pavilion	B24002784	07/26/2024

Description of Work
 SFD/Construction of a 20'x20' pavilion standing at 13.5' in height in rear of property.**SUBJECT TO FIELD INSPECTION**

[check spelling](#)

Online BP assigned to OB.
 g & 7/30/24

Address * (This section is required.)

Search	Reset	Clear	Get Parcel & Owner		
Street #	Street Name	Street Type			
10536	PUDDING	LN			
Unit Type	Unit #	X Coordinate	Y Coordinate		
-Select-		-76.88279	39.2533		
City	State	Zip Code	Primary		
ELLCOTT CITY	MD	21042	Yes		

Parcel * (This section is required.)

Search	Reset	Clear	Get Address & Owner			
GIS ID *	Parcel	Parcel Area	Land Value	Improved Value	Exemption Value	Plan Area
11061237	0148	1.13	222400	1254000	1031600	RURAL
Legal Description						
IMPSLOT 23, 1.126 A.[]10536 PUDDING LANE[]KINGS FOREST						

[check spelling](#)

Block	Lot	Census Tract	Council Dist	Inspection Dist	Supervisor Dist	Map #	DAP Zone
24	23	602303	5				
Plan Area	State Tax Id	Subdivision Name					
	1403603433	Kings Forest					
Section	Area	Tax Map					
		23					
Grid	Zoning District	ADC Map					
23-24	RC-DEO	4814-J10					
SDP No.	Final Plan No.	WP File No.					
	ECP-14-046						
Record Plat No.	WS Contract No.	FDP No.	Primary				
25764-2576			Yes				
Owner Occupied	Year Built	Historic District					
<input type="radio"/> Yes <input type="radio"/> No	2023	<input checked="" type="radio"/> Yes <input type="radio"/> No					
Historic District Registry No.	Stat Area	Flood Plain					
	2-08B	<input type="radio"/> Yes <input checked="" type="radio"/> No					
Building No							

Owner * (This section is required.)

Search	Reset	Clear
--------	-------	-------

Name *
 YOON
 Address Line 1
 10536 PUDDING LANE

Approved Septic System Plan
 Howard County Health Department
D. B. Beward
 Signature
 8-7-24
 Date

Address Line 2

Address Line 3

Mail City

ELLICOTT CITY

Mail State

MD

Mail Zip Code

21042

Phone

240-506-0902

Primary

Yes

E-mail

dae.yoon@nm.com

Cell Number

Fax Number

Professionals (This section is not required.)

License #

71753

License Type

MHIC Co

Primary

Yes

Business Name

HERITAGE ELITE LLC

First Name

MICHAEL

Middle Name

Last Name

SHAFFERY

Address Line 1

8335 PULASKI HIGHWAY

Address Line 2

City

ROSEDALE

State

MD

ZIP Code

21237

Phone 1

410-808-6988

Phone 2

Fax

E-mail

Dustin@elitepools.com

Applicant (This section is not required.)

Search

As Owner

As Lic. Prof

As Contact

Type

Applicant

Relationship

Applicant

Primary

Yes

First Name

Dustin

MI

Last Name

Gacon

Full Name

Organization Name

Elite Pools

Street Address

8335 Pulaski Highway

Address Line 2

City

Rosedale

State

MD

Zip Code

21237

Phone

443-220-3781

Cell

Fax

E-mail

dustin@elitepools.com

Addtl Info

Est Construction Cost

20000

Housing Units

0

Number of Buildings

0

Public Owned

No

Construction Type

434 - Additions, Alterations and Conversions - Residential

PAVILION

PAVILION INFORMATION

Capital Project-No Fee

Yes No

Capital Project Number

(Text)

Fee Exempt

Yes No

Roadside Tree Project Permit

Yes No

Roadside Tree Project Permit #

(Text)

Existing Use

SFD

Total Square Footage

▼ 400

Water Supply

SQFT (Number) Private

Sewage Disposal

▼ Private

Expiration Date

▼ 1/25/2025



Submit

Cancel