

Record Detail \* (This section is required.)

<b>Permit Type</b>	<b>Permit Number</b>	<b>Opened Date</b>
Building/Residential/Alteration/SFD	B24000611	02/26/2024
<b>Description of Work</b>		
SFD/ALTERATIONS TO EXISTING DWELLING TO INCLUDE: REMODEL KITCHEN ON 1ST FLOOR, APPROXIMATELY 560 SQ FT **WORK IS FOR KITCHEN ONLY, NO WALLS, WINDOWS OR STRUCTURAL		

[check spelling](#)

Address \* (This section is required.)

Search Reset Clear Get Parcel & Owner

<b>Street #</b>	<b>Street Name</b>	<b>Street Type</b>
13509	SILENT LAKE	DR
<b>Unit Type</b>	<b>Unit #</b>	<b>X Coordinate</b>
-Select-		-76.98108
		<b>Y Coordinate</b>
		39.19854
<b>City</b>	<b>State</b>	<b>Zip Code</b>
CLARKSVILLE	MD	21029
		<b>Primary</b>
		Yes

Online BA.  
gls 3/15/24

Parcel \* (This section is required.)

Search Reset Clear Get Address & Owner

<b>GIS ID *</b>	<b>Parcel</b>	<b>Parcel Area</b>	<b>Land Value</b>	<b>Improved Value</b>	<b>Exemption Value</b>	<b>Plan Area</b>
861885	423	3.26	241900	1497500	1255600	RURAL
<b>Legal Description</b>						
IMPSLOT 15 3.2662 A[ ]13509 SILENT LAKE DR[ ]SPRINGDALE ESTATES						

[check spelling](#)

<b>Block</b>	<b>Lot</b>	<b>Census Tract</b>	<b>Council Dist</b>	<b>Inspection Dist</b>	<b>Supervisor Dist</b>	<b>Map #</b>	<b>DAP Zone</b>
	15	605101	5				
<b>Plan Area</b>	<b>State Tax Id</b>	<b>Subdivision Name</b>					
	1405422221						
<b>Section</b>	<b>Area</b>	<b>Tax Map</b>					
		34					
<b>Grid</b>	<b>Zoning District</b>	<b>ADC Map</b>					
34-14	RR-DEO	4933-C9					
<b>SDP No.</b>	<b>Final Plan No.</b>	<b>WP File No.</b>					
<b>Record Plat No.</b>	<b>WS Contract No.</b>	<b>FDP No.</b>	<b>Primary</b>				
12383			Yes				
<b>Owner Occupied</b>	<b>Year Built</b>	<b>Historic District</b>					
<input type="radio"/> Yes <input type="radio"/> No	1999	<input type="radio"/> Yes <input checked="" type="radio"/> No					
<b>Historic District Registry No.</b>	<b>Stat Area</b>	<b>Flood Plain</b>					
	5-04A	<input type="radio"/> Yes <input checked="" type="radio"/> No					
<b>Building No</b>							

Owner (This section is not required.)

Search Reset Clear

**Name \***  
AKYEA-DJAMSON AYIM

**Address Line 1**  
13509 SILENT LAKE DR

**Address Line 2**

**Address Line 3**

**Mail City**  
CLARKSVILLE

**Mail State**  
MD

**Mail Zip Code**  
21029

**Phone**  
410-489-6004

**E-mail**

**Cell Number**

**Fax Number**



**Related Records**


Showing 1-2 of 2

<u>Permit Number</u>	<u>Record Type Alias</u>	<u>Status</u>	<u>Number</u>	<u>Street Name</u>	<u>Opened Date</u>	<u>Description</u>
B24000611	Residential Interior Alteration Single Family Dwelling Permit	Review In Process	13509	SILENT LAKE	02/26/2024	SFD/ALTERATIONS TO EXISTING DWELLING TO INCLU
P24000901	Residential Plumbing Addition Alteration Permit	Incomplete	13509	SILENT LAKE	03/06/2024	SFD/Relocate 1-kitchen sink, relocate 1-stove and relocate


Page 1 of 1



**Submit**      **Cancel**

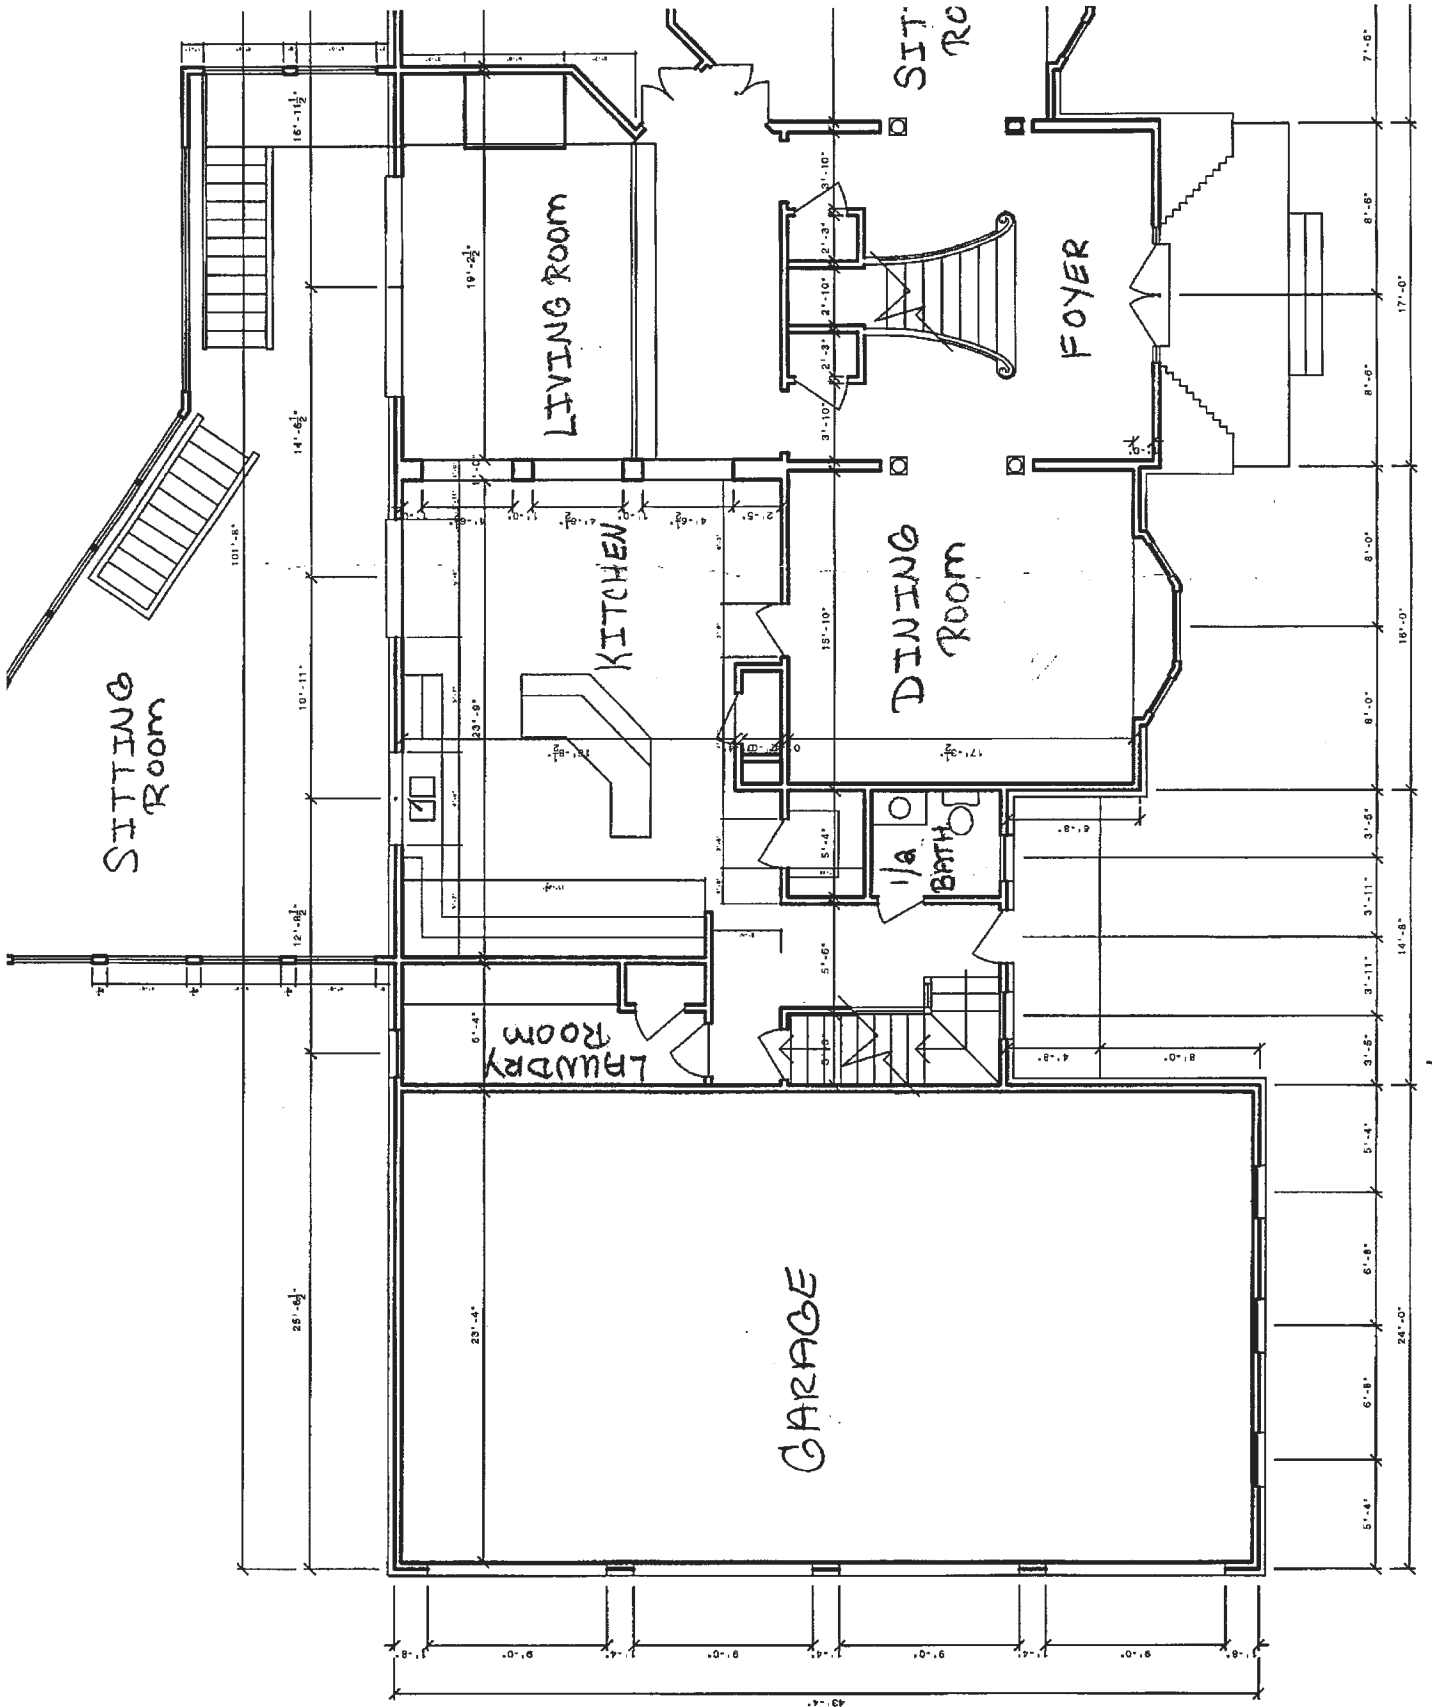

Existing

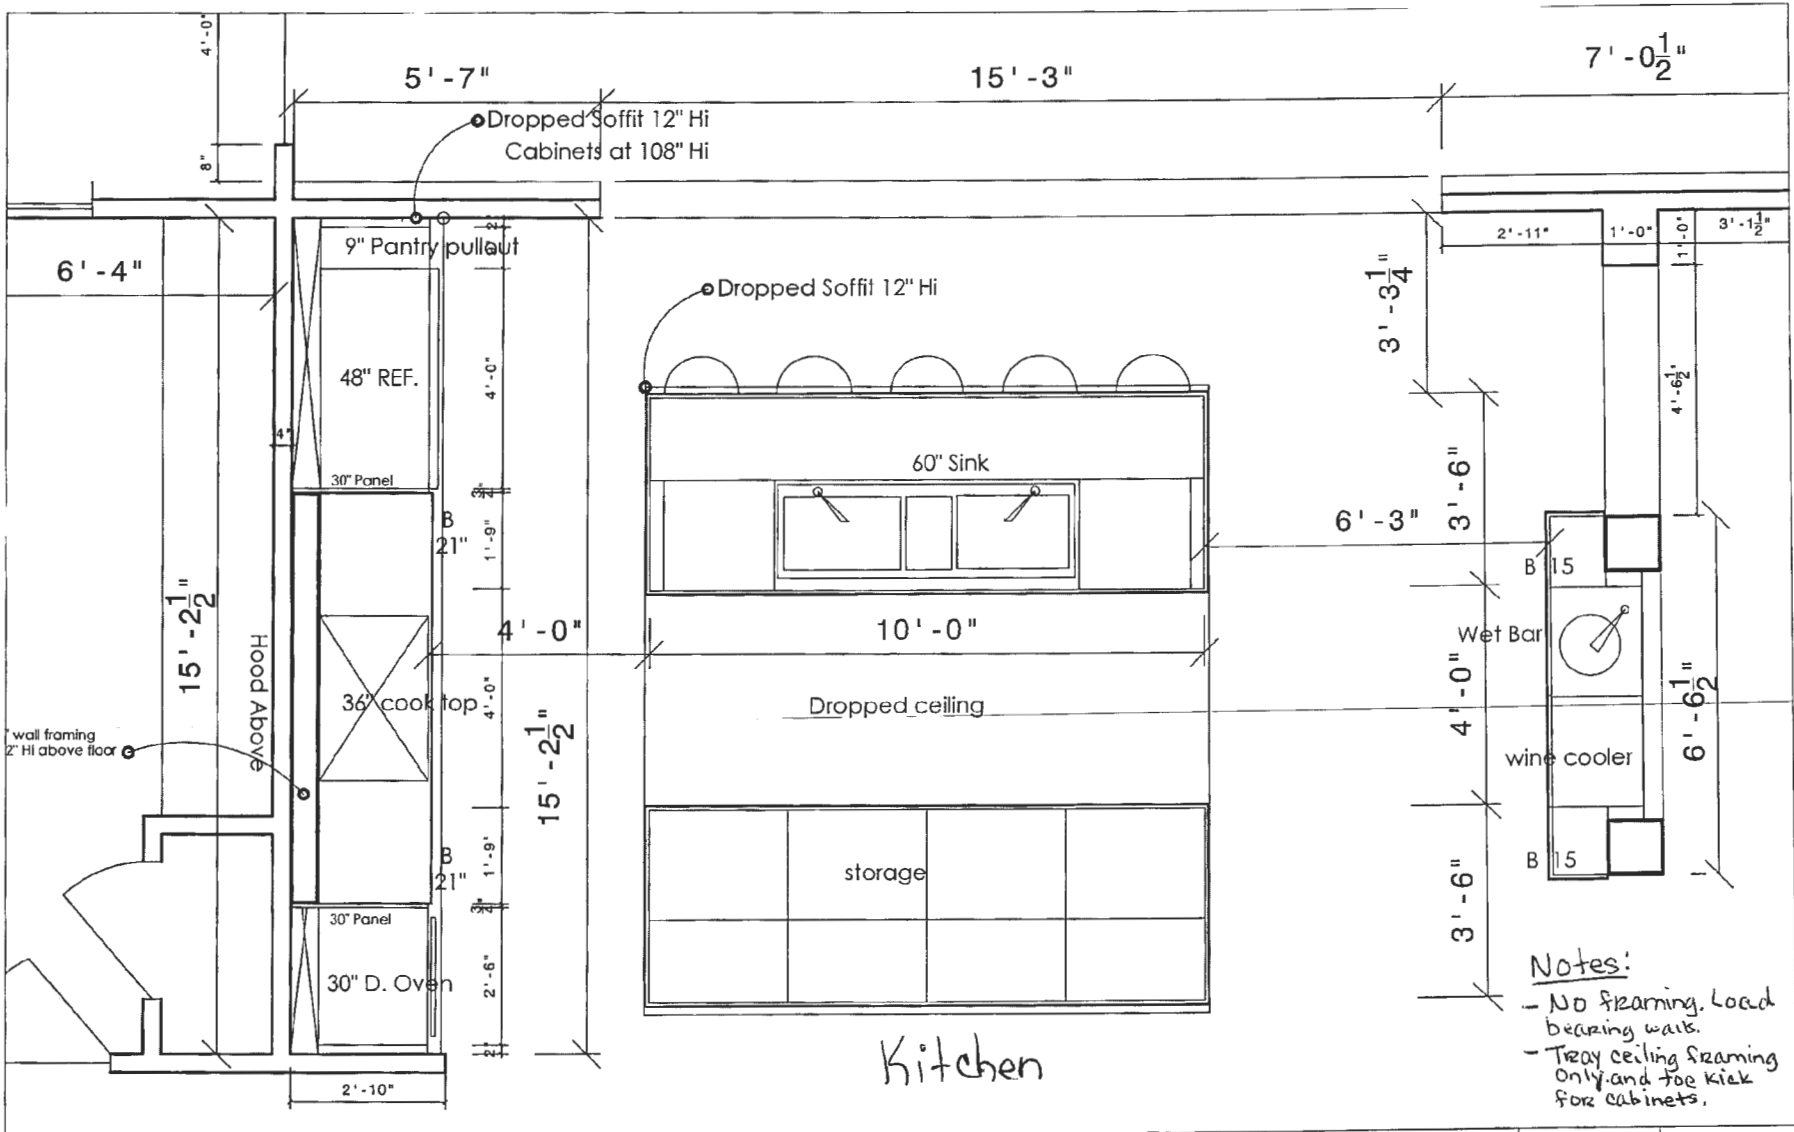

**Notes:**  
 - No framing. Load bearing walls.  
 - Tray ceiling framing only and toe kick for cabinets.

	<p>Proposed KITCHEN PLAN</p>	<p>Distinctive Elements 113 Washington Ave. Phila. PA 19147</p>		<p>DJAMESON RESIDENCE 13509 Silent Lake DR.</p>	<p>A-102</p>	<p>Date: 10/16/2021 Scale: 1/2" = 1'-0"</p>
--	----------------------------------	---	--	---	--------------	---