

Record Detail * (This section is required.)

| | | |
|--|---------------|-------------|
| Permit Type | Permit Number | Opened Date |
| Building/Residential/Misc/Pool Spa | B24000703 | 03/04/2024 |
| Description of Work | | |
| SFD/ Install inground 18x45 ft. pool - Deep End of Pool - 8 ft. /Install 48 inch tall pool code fence. | | |

check spelling

Address * (This section is required.)

Search Reset Clear Get Parcel & Owner

| | | |
|-------------|-------------|--------------|
| Street # | Street Name | Street Type |
| 5107 | HOLLY CREEK | LN |
| Unit Type | Unit # | X Coordinate |
| --Select-- | | -76.94579 |
| | | Y Coordinate |
| | | 39.23004 |
| City | State | Zip Code |
| CLARKSVILLE | MD | 21029 |
| | | Primary |
| | | Yes |

Need revised plot plan,
not meeting minimum
setback from well.

gls 3/27/24

Parcel * (This section is required.)

Search Reset Clear Get Address & Owner

| | | | | | | |
|--|--------|-------------|------------|----------------|-----------------|-----------|
| GIS ID * | Parcel | Parcel Area | Land Value | Improved Value | Exemption Value | Plan Area |
| 924674 | 74 | 36976 | 337900 | 1180200 | 842300 | RURAL |
| Legal Description | | | | | | |
| IMPSLOT 65 36976 SQ[]5107 HOLLY CREEK LN[]WALNUT GROVE | | | | | | |

Revised plot plan
uploaded to

OILP, OK. Approved.

gls 3/27/24

check spelling

| | | | | | | | |
|--|-----------------|---|--------------|-----------------|-----------------|-------|----------|
| Block | Lot | Census Tract | Council Dist | Inspection Dist | Supervisor Dist | Map # | DAP Zone |
| | 65 | 605101 | 5 | | | | |
| Plan Area | State Tax Id | Subdivision Name | | | | | |
| | 1405449294 | Walnut Grove | | | | | |
| Section | Area | Tax Map | | | | | |
| | | 28 | | | | | |
| Grid | Zoning District | ADC Map | | | | | |
| 28-18 | RC-DEO | 4933-J4 | | | | | |
| SDP No. | Final Plan No. | WP File No. | | | | | |
| | F-06-031 | | | | | | |
| Record Plat No. | WS Contract No. | FDP No. | Primary | | | | |
| 19220-1922 | | | Yes | | | | |
| Owner Occupied | Year Built | Historic District | | | | | |
| <input type="radio"/> Yes <input type="radio"/> No | 2015 | <input checked="" type="radio"/> Yes <input type="radio"/> No | | | | | |
| Historic District Registry No. | Stat Area | Flood Plain | | | | | |
| | 5-02A | <input type="radio"/> Yes <input checked="" type="radio"/> No | | | | | |
| Building No | | | | | | | |

Owner * (This section is required.)

Search Reset Clear

Name *

PANDYA NAIMISH B

Address Line 1

5107 HOLLY CREEK LN

Address Line 2

Address Line 3

| | | |
|--------------|------------|---------------|
| Mail City | Mail State | Mail Zip Code |
| CLARKSVILLE | MD | 21029 |
| Phone | Primary | |
| 410-507-9264 | Yes | |
| E-mail | | |
| Cell Number | Fax Number | |

Professionals (This section is not required.)

License # *
 156266
License Type *
 MHIC Ind
Primary
 No

Business Name
 WADE LANDSCAPE & DESIGN LLC
First Name **Middle Name** **Last Name**
 SHAUN
 WADE
Address Line 1
 1131 LITTLE MAGOTHY VIEW
Address Line 2

City **State** **ZIP Code**
 ANNAPOLIS MD 21409
Phone 1 **Phone 2** **Fax**
 410-507-9264 410-349-9507
E-mail
 SHAUNWADE@WADELANDSCAPES.COM

Applicant (This section is not required.)

Search As Owner As Lic. Prof As Contact

Type *
 Applicant
Relationship
 Applicant
Primary
 Yes

First Name **MI** **Last Name**
 SHAUN
 WADE
Full Name
 SHAUN WADE
Organization Name
 WADE LANDSCAPE & DESIGN LLC
Street Address
 1131 LITTLE MAGOTHY VIEW
Address Line 2

City **State** **Zip Code**
 ANNAPOLIS MD 21409
Phone **Cell** **Fax**
 410-507-9264 410-349-9507
E-mail *
 SHAUNWADE@WADELANDSCAPES.COM

Addtl Info

Est Construction Cost * **Housing Units *** **Number of Buildings *** **Public Owned**
 85000 0 0 No

Construction Type
 329 - Structures Other Than Buildings (Retaining Walls/Tents)

POOL INFORMATION

MISCELLANEOUS POOL INFORMATION

Capital Project-No Fee * **Capital Project Number** **Fee Exempt *** **Water Supply *** **Sewage Disposal ***
 Yes No Yes No Private Public

Existing Use * **Type of Pool or Spa *** **Pool Safety Device *** **Electrical Permit Number** **Expiration Date**
 SFD In Ground Pool Fence 9/7/2024


Related Records

Showing 1-2 of 2

| Permit Number | Record Type Alias | Status | Number | Street Name | Opened Date | Description |
|---------------|---|-------------------|--------|-------------|-------------|--|
| B24000703 | Residential Pool or Spa Permit | Review In Process | 5107 | HOLLY CREEK | 03/04/2024 | SFD/ Install inground 18x45 ft. pool - Deep End of Pool - 8 ft |
| E24001256 | Residential Electrical Miscellaneous Permit | Issued | 5107 | HOLLY CREEK | 03/11/2024 | Residential in ground concrete swimming pool; Shell bondir |

Submit Cancel

Revised Plot Plan

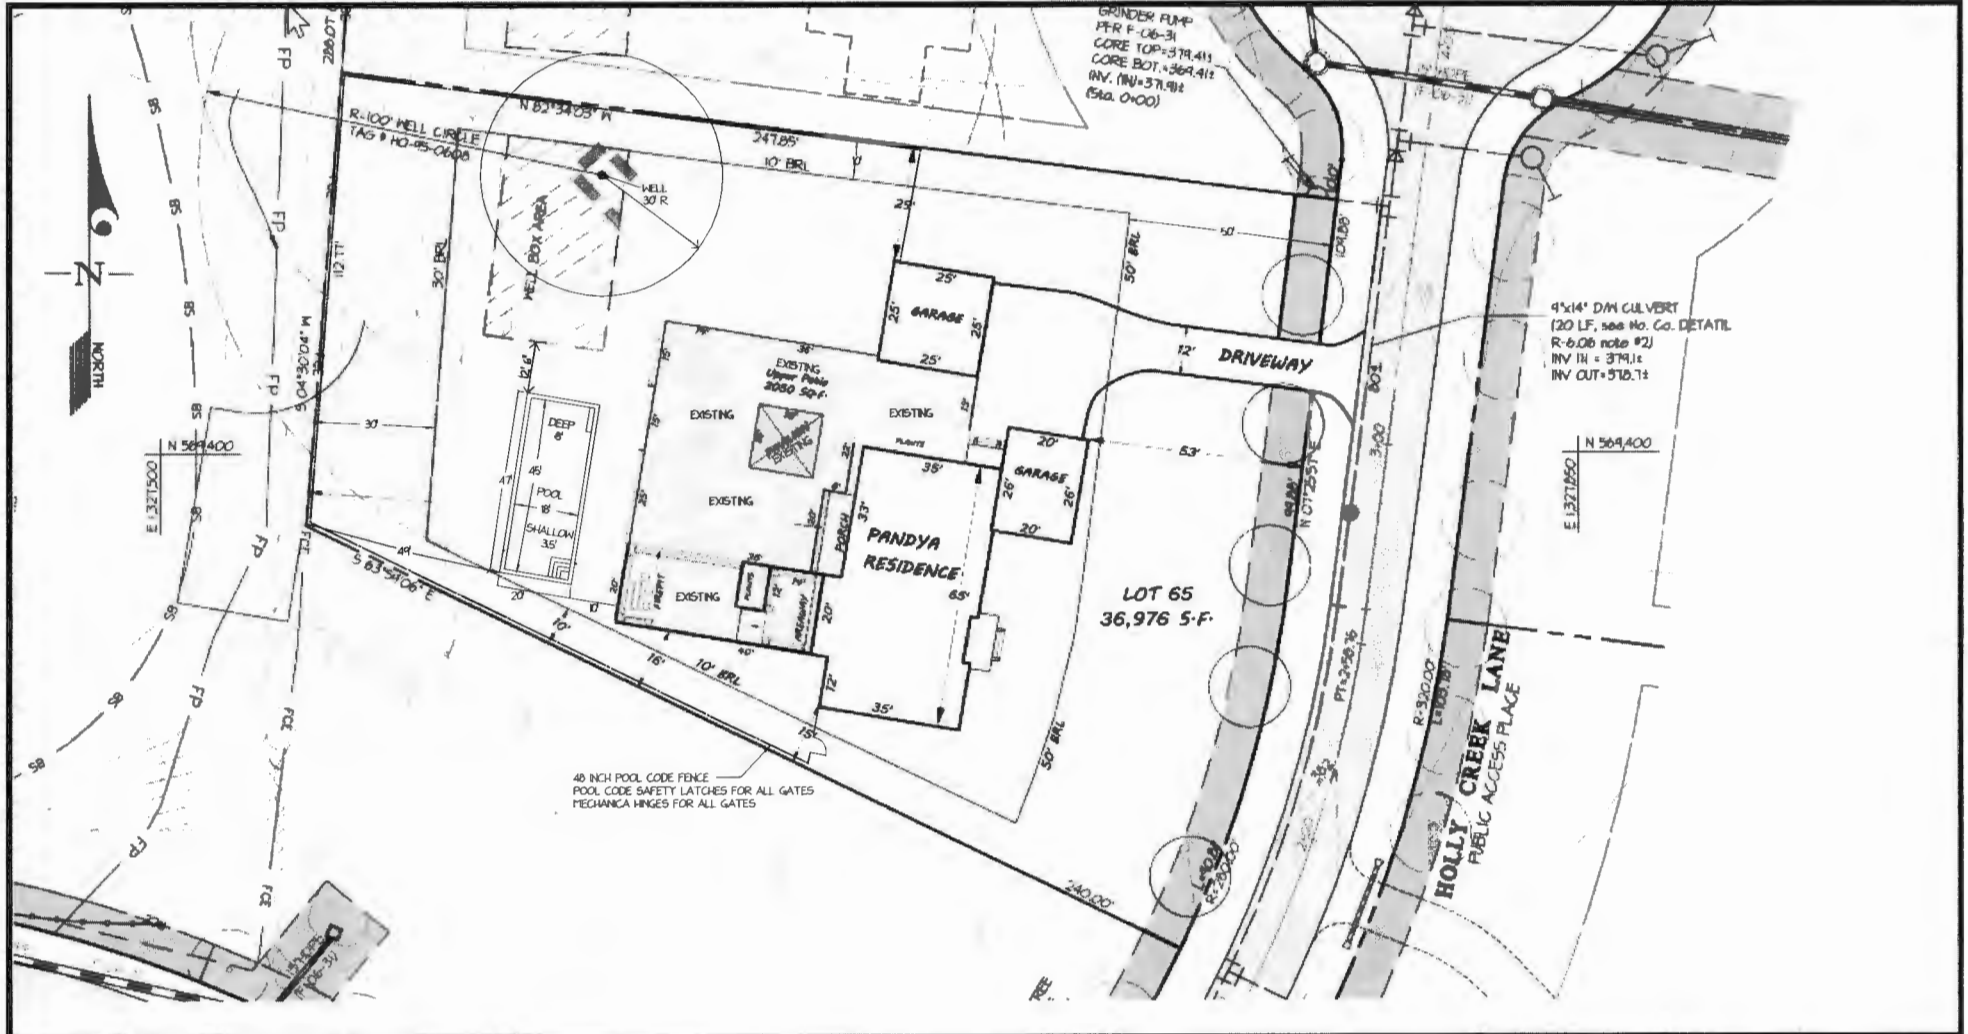

PROFESSIONAL CERTIFICATION

I HEREBY CERTIFY THAT THESE PLANS WERE PREPARED OR APPROVED BY ME, AND THAT I AM A DULY LICENSED PROFESSIONAL ENGINEER UNDER THE LAWS OF THE STATE OF MARYLAND, LICENSE NO. 12978, EXPIRATION DATE: MAY 26, 2014

ELECTION DISTRICT No. 5


WALNUT GROVE
LOT 65 (5107 HOLLY CREEK LANE)
PLAT No. 19220-19227

HOWARD COUNTY, MARYLAND

| | | |
|-------------------|---|----------------------------|
| SCALE 1" = 30' | ZONING RC DEO | C. L. W. FILE No. 09052 |
| DATE FEB. 2014 | TAX MAP - ORD PARCEL 74 28 - 18, 17 | SHEET 1 of 1 |

W H0-45-0608

NOT TO SCALE

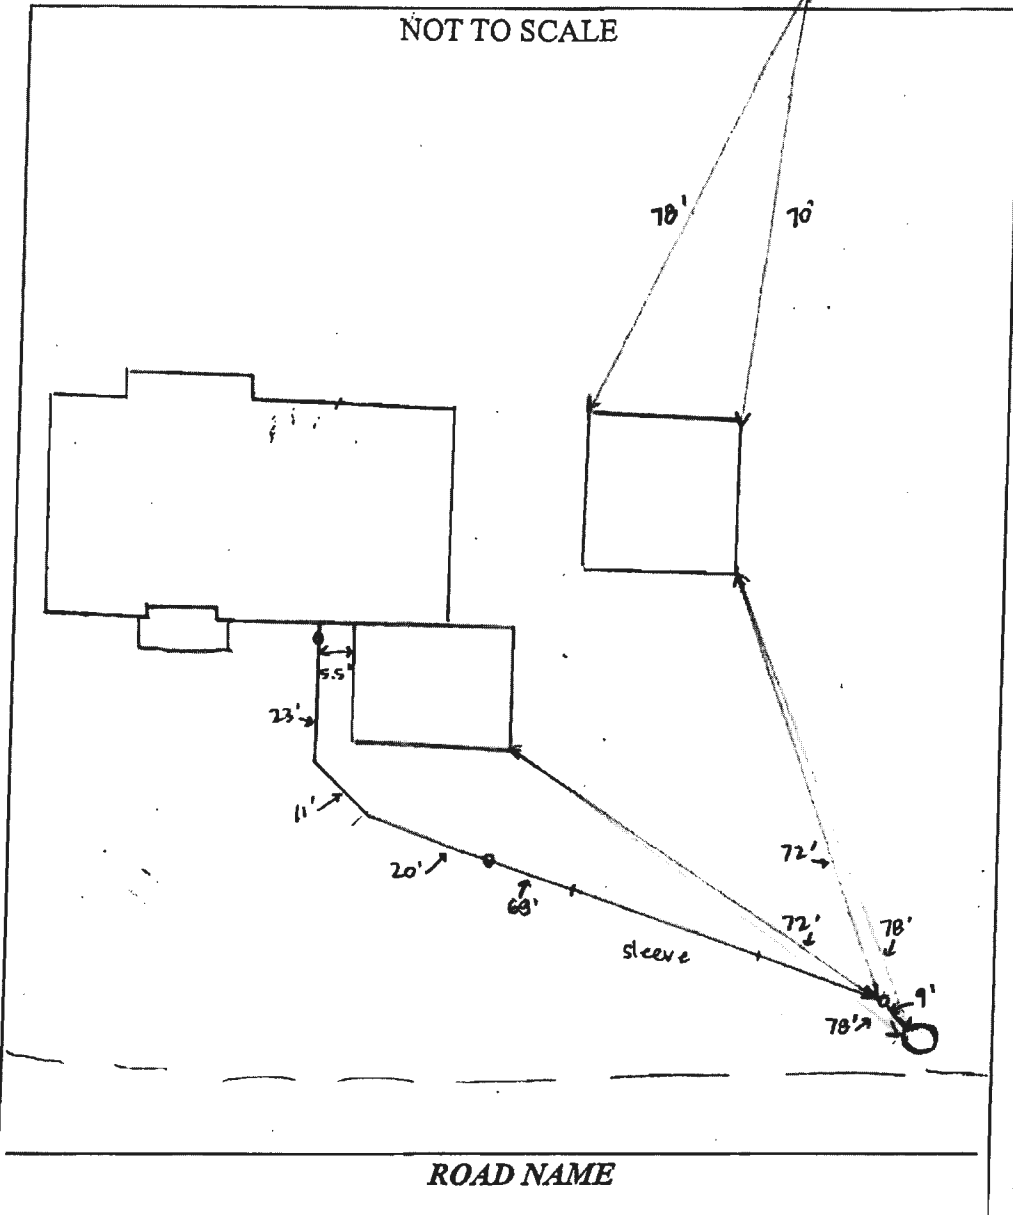

| TRENCH/DRAINFIELD DATA | | |
|-------------------------------|-------|--------|
| WIDTH | INLET | BOTTOM |
| _____ | _____ | _____ |
| NUMBER OF TRENCHES _____ | | |
| TOTAL LENGTH _____ | | |
| ABSORPTION AREA _____ | | |
| DISTRIBUTION BOX LEVEL _____ | | |
| DISTRIBUTION BOX BAFFLE _____ | | |
| DISTRIBUTION BOX PORT _____ | | |

| SEPTIC TANK DATA | |
|------------------------------|-----------|
| SEPTIC TANK 1 LEVEL | _____ |
| MANUFACTURER | _____ |
| CAPACITY | _____ GAL |
| SEAM LOC | _____ |
| TANK LID DEPTH | _____ |
| BAFFLES | _____ |
| BAFFLE FILTER | _____ |
| MANHOLE LOC | _____ |
| 6" PORT LOC | _____ |
| WATERTIGHT TEST | _____ |
| SLOTTED | _____ |
| DATE ON LID | _____ |
| PUMP/SEPTIC TANK LEVEL _____ | |
| MANUFACTURER | _____ |
| CAPACITY | _____ GAL |
| SEAM LOC | _____ |
| TANK LID DEPTH | _____ |
| BAFFLES | _____ |
| BAFFLE FILTER | _____ |
| MANHOLE LOC | _____ |
| 6" PORT LOC | _____ |
| WATERTIGHT TEST | _____ |
| SLOTTED | _____ |
| DATE ON LID | _____ |

ROAD NAME

PRE-CONSTRUCTION:

INSTALLATION: 2/12/15 House connection made. Used 33' of 6" sleeve where driveway will be. Needs approval from Bureau of Utilities for grinder pump startup. (SC)

3/16/2015 Received grinder pump approval from utilities. (BB)

FINAL INSPECTOR B. Baker DATE OF APPROVAL 3/16/2015