

MARYLAND DEPARTMENT OF THE ENVIRONMENT, WATER MANAGEMENT ADMINISTRATION
1800 Washington Blvd., Baltimore, Maryland 21230 (410) 537-3784

WATER WELL ABANDONMENT-SEALING REPORT FORM

SUBMIT COPIES OF COMPLETED FORM TO:
COUNTY ENVIRONMENTAL AGENCY (contact MDB, WMA if address needed)

- WELL OWNER
- MDE, WATER MANAGEMENT ADMINISTRATION, WELL PROGRAM

DATE WELL ABANDONED: 9-27-2024 (month/day/year)

PERMIT NUMBER OF ABANDONED WELL (if any) _____

PERMIT NUMBER OF REPLACEMENT WELL: _____


PERSON ABANDONING WELL: Larry Moore WELL DRILLER'S LICENSE NUMBER: 027

OWNER'S NAME: Jeffrey Smith CIRCLE: MWD / MSD / MGS

WELL LOCATION:
COUNTY: Howard
NEAREST TOWN: Cockeville Md. 21225
TAX MAP BLOCK _____ PARCEL _____
SECTION _____ LOT: _____
STREET ADDRESS: 14084 Barbara Circle

LATITUDE 39.32374
LONGITUDE 77.00206

SITE LOCATION MAP

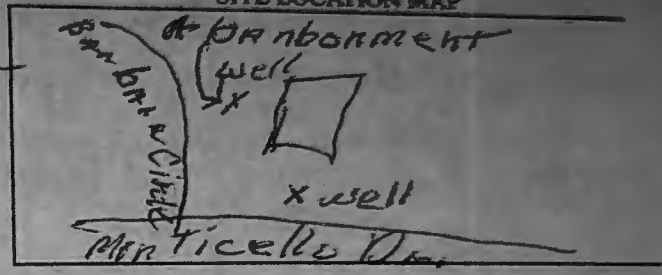

LOG OF SEALING MATERIAL

MATERIAL	FEET	
	FROM	TO
Cement & gravel	0	160

VOLUME OF MATERIAL USED

1 yard of gravel
19 Bags cement

* TYPE OF WELL BEING ABANDONED:
 DRILLED JETTED
 BORED HAND DUG
 OTHER (specify) _____

* USE CODE:
 DOMESTIC MUNICIPAL/PUBLIC
 IRRIGATION INDUSTRIAL
 TEST/OBSERVATION GEOTHERMAL

* TYPE OF CASING:
 STEEL PLASTIC
 CONCRETE OTHER (specify) _____

SIZE OF CASING: 6 INCHES IN DIAMETER

DEPTH OF WELL: 160 FEET DEEP

WAS ANY CASING REMOVED? YES NO
If yes, length removed, in feet: 1'

WAS CASING RIPPED OR PERFORATED? YES NO

Pursuant to § 10-624 of the State Govt. Article of the Maryland Code, personal info requested on this form is used in processing this form pursuant to COMAR 26.04.04. Failure to provide the info may result in this form not being processed. You have the right to inspect, amend, or correct this form. The Maryland Department of the Environment is subject to the Maryland Public Information Act. This form may be made available on the Internet via MDE's website and is subject to inspection or copying, in whole or in part, by the public and other governmental agencies, if not protected by federal or State Law.

Larry Moore

027

MWD / MSD / MGS 9-27-2024

 WATER WELL ABANDONMENT-SEALING REPORT FORM

SUBMIT COPIES OF COMPLETED FORM TO:

- * COUNTY ENVIRONMENTAL AGENCY (contact MDE, WMA if address needed)
- * WELL OWNER
- * MDE, WATER MANAGEMENT ADMINISTRATION, WELL PROGRAM

OK
 10/21/2024
 SP

DATE WELL ABANDONED: 9-27-2024 (month/day/year)

* PERMIT NUMBER OF ABANDONED WELL (if any) none

* PERMIT NUMBER OF REPLACEMENT WELL: none


* PERSON ABANDONING WELL: Larry Mays WELL DRILLER'S LICENSE NUMBER: 027

CIRCLE: MWD / ~~MSP~~ / MGS

* OWNER'S NAME: Jaffer Smith

SITE LOCATION MAP

* WELL LOCATION:
 COUNTY: Howard
 NEAREST TOWN: Cooksville Md. 21725
 TAX MAP _____ BLOCK _____ PARCEL _____
 SUBDIVISION: _____
 SECTION: _____ LOT: _____
 STREET ADDRESS: 14084 Barbara Circle

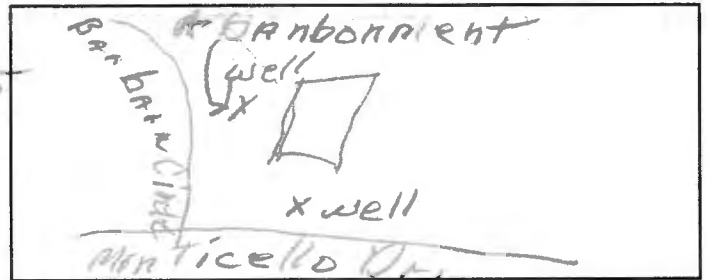

✓ LATITUDE 3 9.32374

✓ LONGITUDE 7 7.00206

LOG OF SEALING MATERIAL

MATERIAL	FEET	
	FROM	TO
<u>Cement & gravel</u>	<u>0</u>	<u>160</u>

* TYPE OF WELL BEING ABANDONED:
 DRILLED JETTED
 BORED HAND DUG
 OTHER (specify) _____

* USE CODE:
 DOMESTIC MUNICIPAL/PUBLIC
 IRRIGATION INDUSTRIAL
 TEST/OBSERVATION GEOTHERMAL

VOLUME OF MATERIAL USED

1 yard of gravel
19 Bags cement

* TYPE OF CASING:
 STEEL PLASTIC
 CONCRETE OTHER (specify) _____

SIZE OF CASING: 6 INCHES IN DIAMETER

DEPTH OF WELL: 160 FEET DEEP

WAS ANY CASING REMOVED? YES NO
 If yes, length removed, in feet: 1

WAS CASING RIPPED OR PERFORATED? YES NO

SIGNATURE-MASTER WELL DRILLER OR SUPERVISING SANITARIAN Larry Mays LICENSE# 027

MWD / ~~MSP~~ / MGS CIRCLE ONE

9-27-2024 DATE

COUNTY

Pursuant to § 10-624 of the State Govt. Article of the Maryland Code, personal info requested on this form is used in processing this form pursuant to COMAR 26.04.04. Failure to provide the info may result in this form not being processed. You have the right to inspect, amend, or correct this form. The Maryland Department of the Environment is subject to the Maryland Public Information Act. This form may be made available on the Internet via MDE's website and is subject to inspection or copying, in whole or in part, by the public and other governmental agencies, if not protected by federal or State Law.

3/12/2025 14084 Barbera Circle - Dry Well stored and Sch. 40 pipe installed with perforated holes and 6' obs. pipe. (MP)

