

Menu

Refine Search

GIS

Help

My Filters

--Select--

Showing 1 of 1

<input type="checkbox"/> <u>Permit #</u>	<u>Status</u>	<u>Record Type Alias</u>	<u>Street #</u>	<u>Street Name</u>	<u>Type</u>	<u>Unit Type</u>	<u>Unit #</u>	<u>City</u>
<input type="checkbox"/> <u>B23002707</u>	Review In Process	Residential Deck Permit	6071	MEADOWRIDGE	RD			ELKRIDGE

Page  of 1

Approved Septic System Plan  
Howard County Health Department

*D. Bunard*  
Signature



7-18-23  
Date

RECORDED APRIL 20 1988

Billy D Mizell

This is to certify that the plandelineated is a correct plat of parcel shown in  
liber 0088 Folio 710 of the Land Records of Howard County, MARYLAND that building  
shown herein has been accurately located by transit-tape survey.

July 23, 1986 Recor'd Plat Survey  
Billy D Mizell  
Registered Land Surveyor,  
Md No. 9155

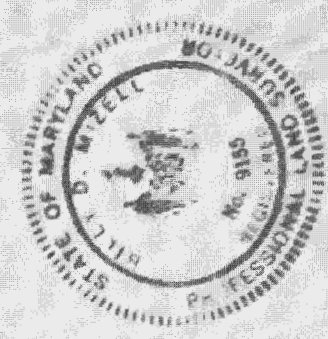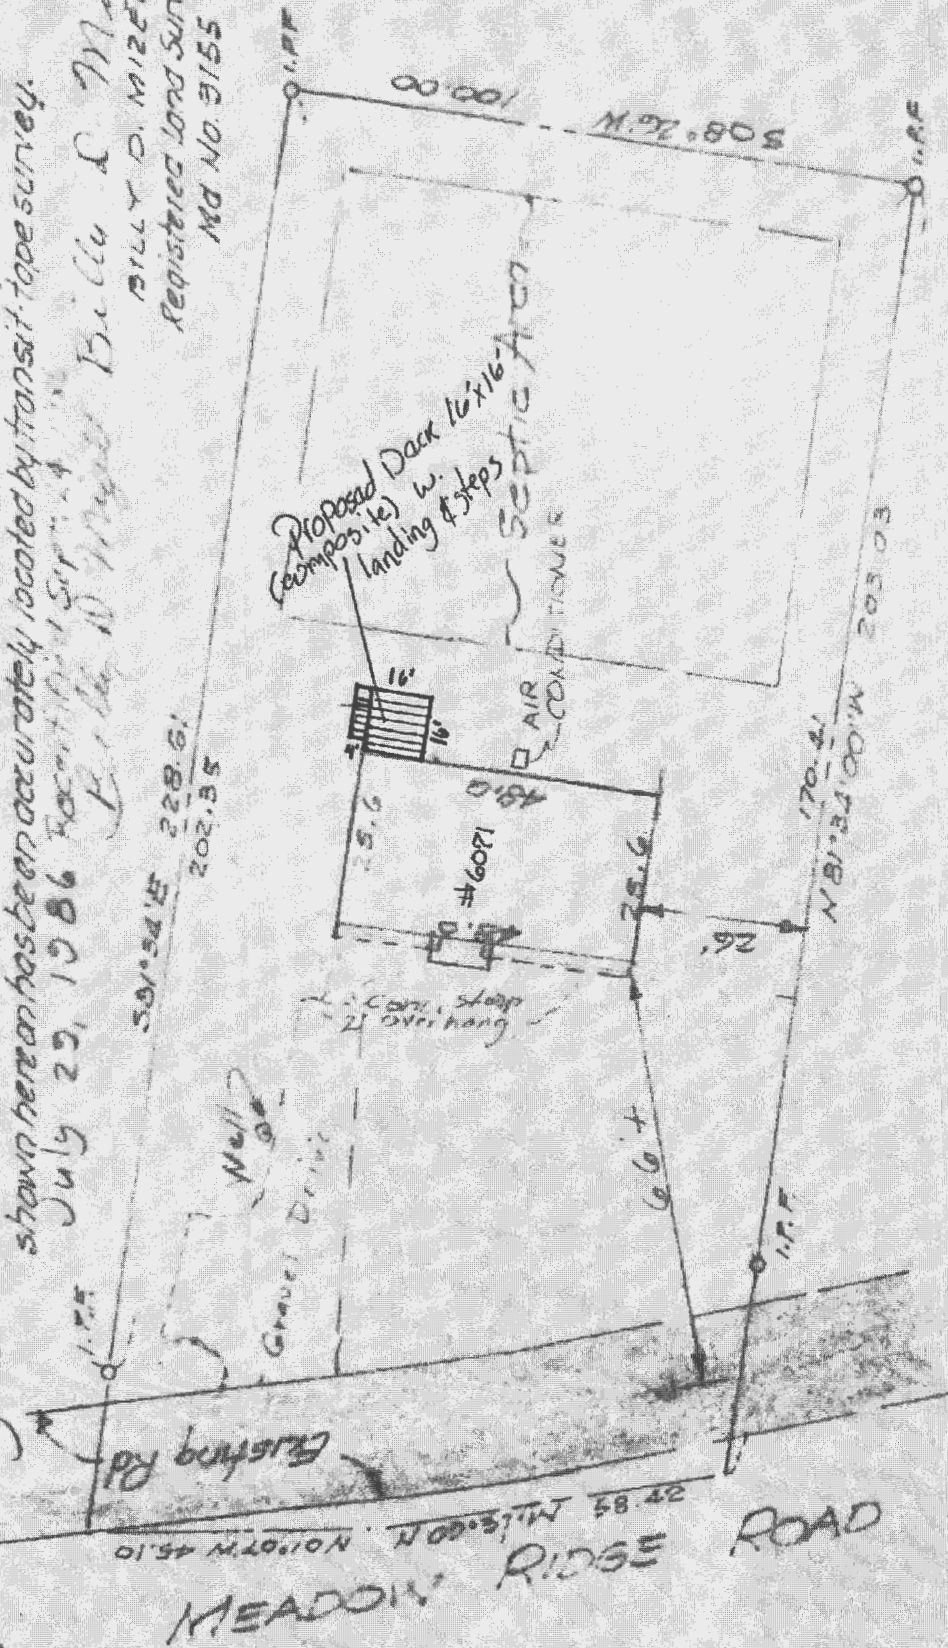

WILLIAM GREELE  
1st Election Dist. Howard Co.  
SCALE 1"=80'

WALLACE RAMOS AND ASSOCIATES, LTD  
LAND SURVEYORS  
2525 GEORGIA AVENUE  
SILVER SPRING, MARYLAND  
505-977

MEADOW RIDGE ROAD  
27 85 MILESON N. 01107M 45.10 58.42