

**Record Detail** \* (This section is required.)

<b>Permit Type</b>	<b>Permit Number</b>	<b>Opened Date</b>
Building/Residential/Misc/Deck	B23002893	07/30/2023

**Description of Work**  
 SFD/ REPLACE EXISTING DECK WITH 39' X 31' 590 sq. ft irregular shaped open deck with no railing and 1 step down to grade

[check spelling](#)

**Address** \* (This section is required.)

Search Reset Clear Get Parcel & Owner

<b>Street #</b>	<b>Street Name</b>	<b>Street Type</b>
11048	GAITHER FARM	RD
<b>Unit Type</b>	<b>Unit #</b>	<b>X Coordinate</b>
--Select--		-76.89578
		<b>Y Coordinate</b>
		39.2413
<b>City</b>	<b>State</b>	<b>Zip Code</b>
ELLCOTT CITY	MD	21042
	<b>Primary</b>	
	Yes	

**Parcel** \* (This section is required.)

Search Reset Clear Get Address & Owner

GIS ID	Parcel	Parcel Area	Land Value	Improved Value	Exemption Value	Plan Area
886021	1	3.25	261800	867700	605900	RURAL

**Legal Description**  
 IMPSLOT 19 3.2531 A[ ]11048 GAITHER FARM RD[ ]GAITHER FARM

[check spelling](#)

<b>Block</b>	<b>Lot</b>	<b>Census Tract</b>	<b>Council Dist</b>	<b>Inspection Dist</b>	<b>Supervisor Dist</b>	<b>Map #</b>	<b>DAP Zone</b>
	19	603000	5				
<b>Plan Area</b>	<b>State Tax Id</b>	<b>Subdivision Name</b>					
	1403310914						
<b>Section</b>	<b>Area</b>	<b>Tax Map</b>					
		29					
<b>Grid</b>	<b>Zoning District</b>	<b>ADC Map</b>					
29-10	RC-DEO	4934-G2					
<b>SDP No.</b>	<b>Final Plan No.</b>	<b>WP File No.</b>					
<b>Record Plat No.</b>	<b>WS Contract No.</b>	<b>FDP No.</b>	<b>Primary</b>				
6610			Yes				
<b>Owner Occupied</b>	<b>Year Built</b>	<b>Historic District</b>					
<input type="radio"/> Yes <input type="radio"/> No	1987	<input type="radio"/> Yes <input checked="" type="radio"/> No					
<b>Historic District Registry No.</b>	<b>Stat Area</b>	<b>Flood Plain</b>					
	3-09A	<input type="radio"/> Yes <input checked="" type="radio"/> No					
<b>Building No</b>							

**Owner** (This section is required.)

Search Reset Clear

<b>Name</b>	PATRICK A. WILLIAMS	
<b>Address Line 1</b>	11048 GAITHER FARM RD	
<b>Address Line 2</b>		
<b>Address Line 3</b>		
<b>Mail City</b>	<b>Mail State</b>	<b>Mail Zip Code</b>
ELLCOTT CITY	MD	21042
<b>Phone</b>	<b>Primary</b>	
267-670-1960	Yes	
<b>E-mail</b>		

Cell Number Fax Number

Professionals (This section is not required.)

License # \* 08050123626  
 License Type \* MHIC Co  
 Primary Yes

Business Name DEMBINSKY INC  
 First Name MARK Middle Name RYAN Last Name DEMBINSKY  
 Address Line 1 120 HOFF ROAD  
 Address Line 2

City UNION BRIDGE State MD ZIP Code 21791  
 Phone 1 4436956621 Phone 2 Fax  
 E-mail MARKDEMBINSKY@MSN.COM

Applicant (This section is not required.)

Search As Owner As Lic. Prof As Contact

Type \* Applicant  
 Relationship Applicant  
 Primary Yes

First Name MARK MI RYAN Last Name DEMBINSKY  
 Full Name MARK DEMBINSKY  
 Organization Name DEMBINSKY INC  
 Street Address 120 HOFF ROAD  
 Address Line 2

City UNION BRIDGE State MD Zip Code 21791  
 Phone 4436956621 Cell Fax  
 E-mail MARKDEMBINSKY@MSN.COM

Addtl Info

Est Construction Cost \* 35000  
 Housing Units \* 0  
 Number of Buildings \* 0  
 Public Owned No

Construction Type --Select--

MISC PERMIT INFO


MISCELLANEOUS PERMIT INFORMATION

Capital Project-No Fee \*  Yes  No  
 Capital Project Number  
 Fee Exempt \*  Yes  No  
 Roadside Tree Project Permit \*  Yes  No  
 Roadside Tree Project Permit #

Existing Use \* SFD  
 Water Private Sewage Private Expiration Date 1/29/2024


Submit Cancel

1" = 60' Scale

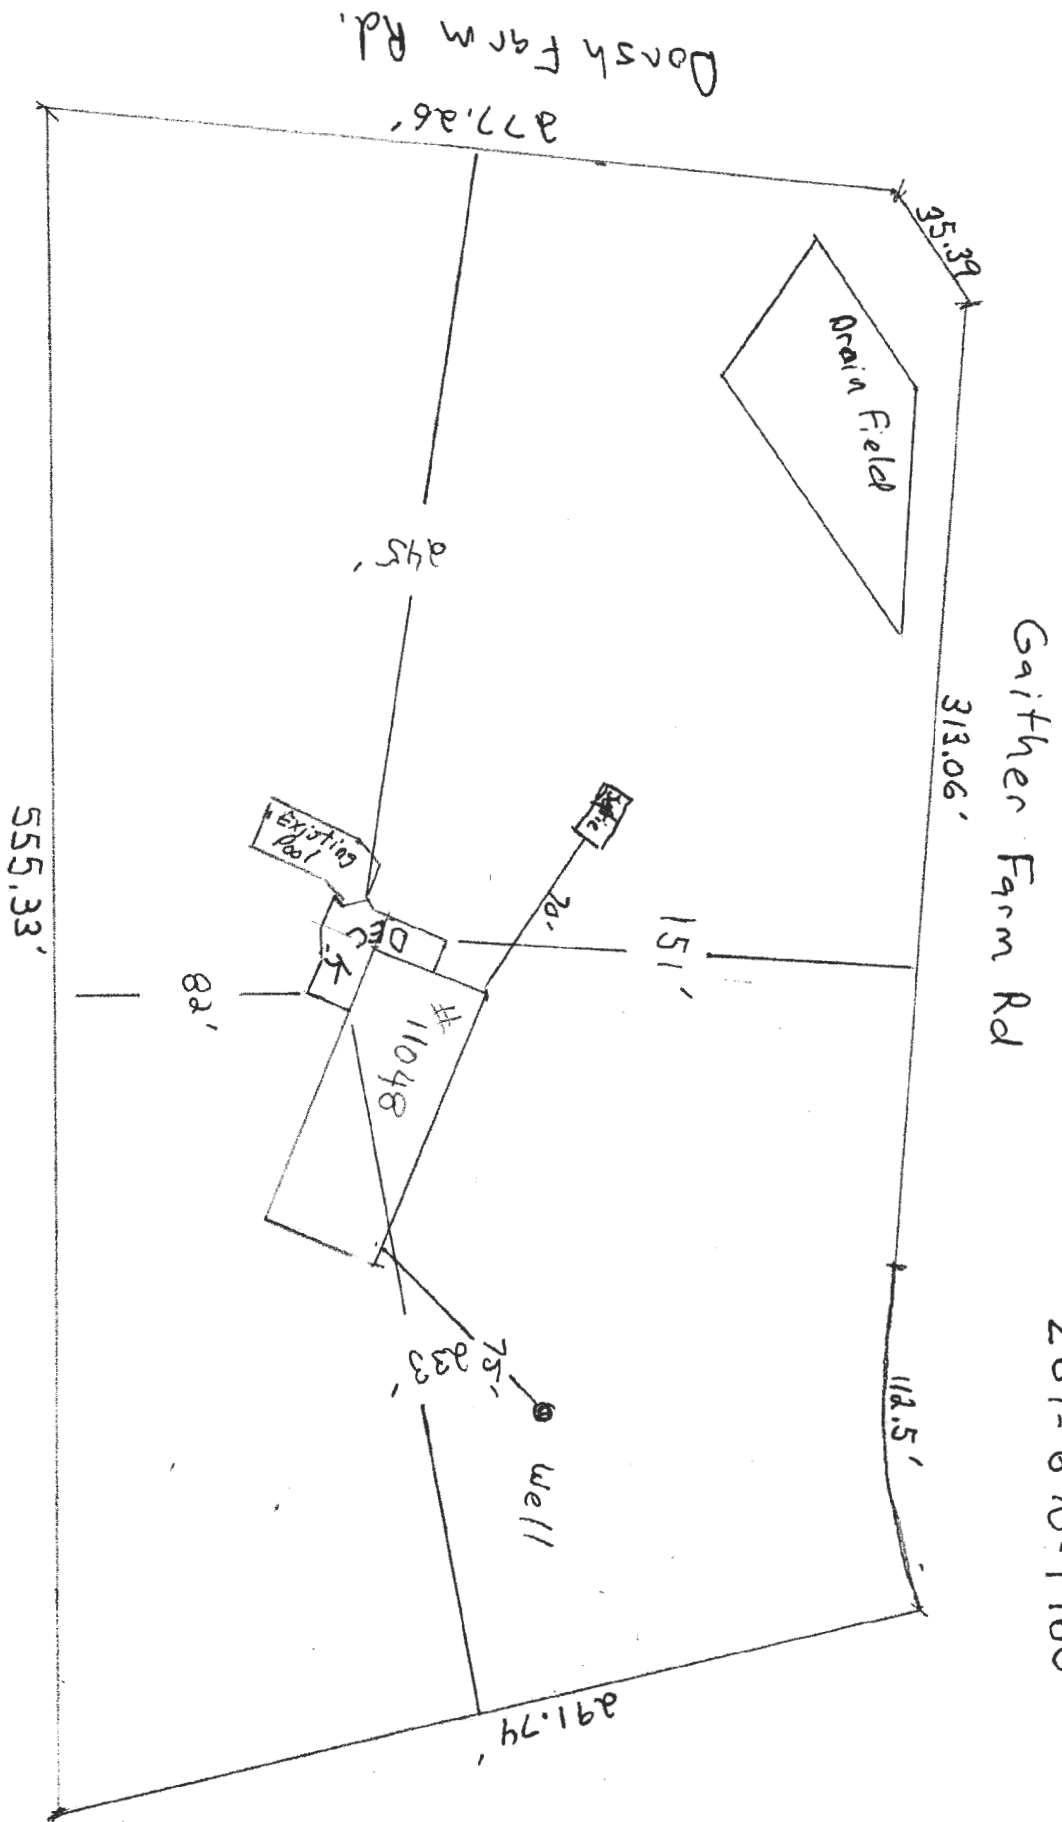

Patrick Williams  
11048 Gaither Farm Rd.  
Ellicott City, MD. 21042  
267-670-1960



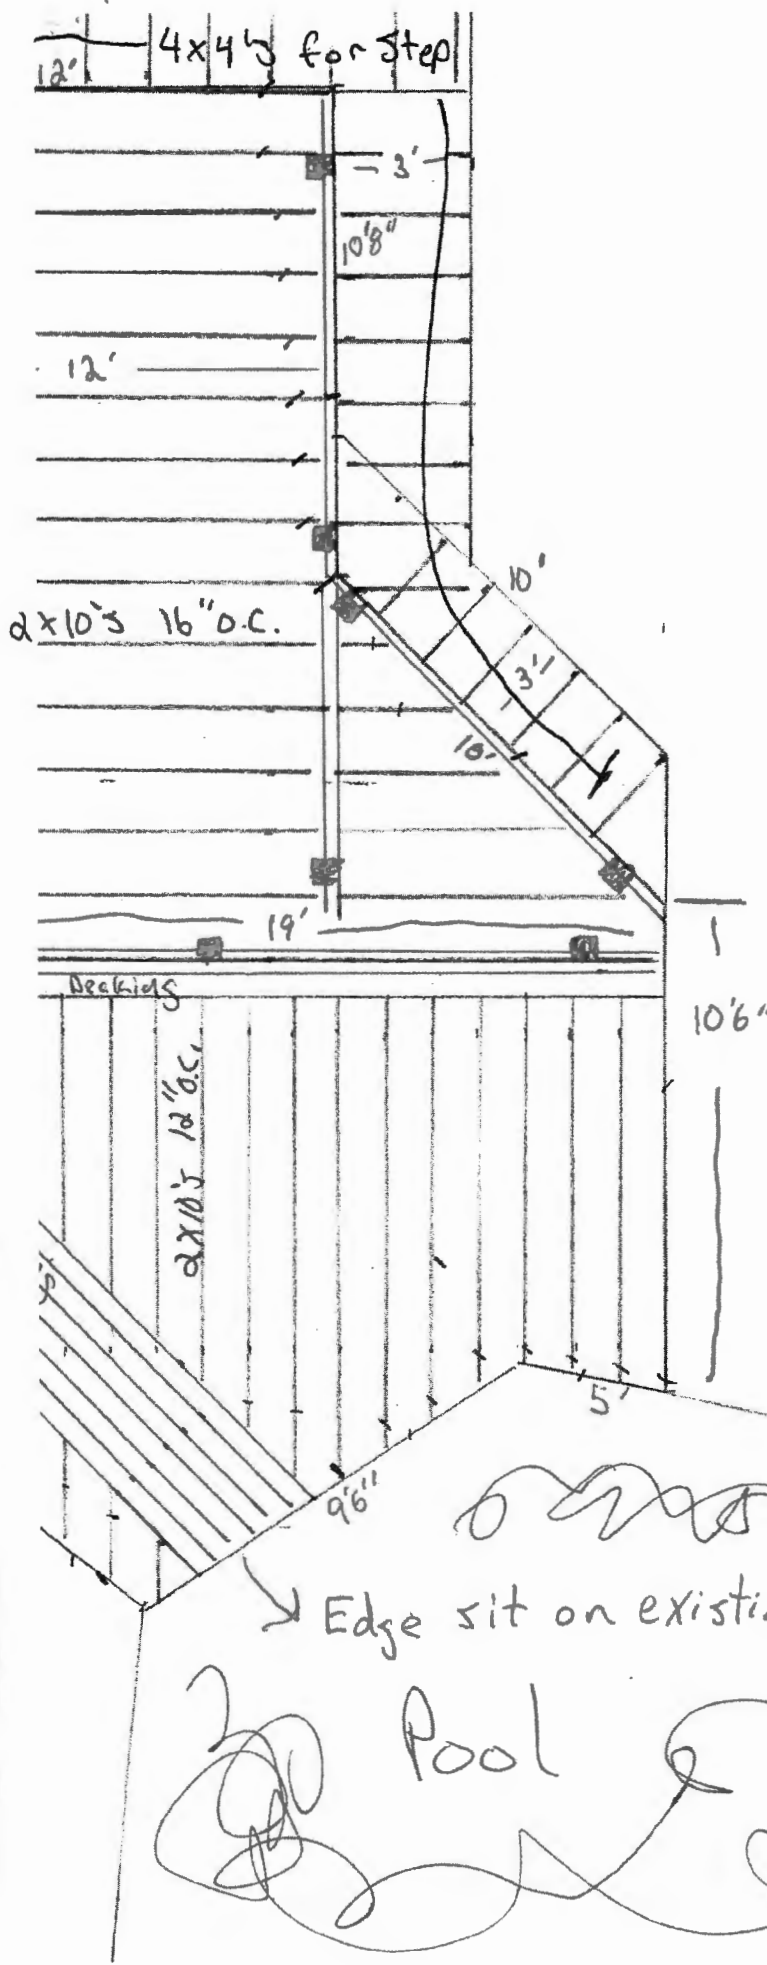

\* All 2x10's

\* 590 sq. ft main deck

\* Allwood Ground Contact

\* No railing

\* Trex Decking

\* 151 sq ft of steps

$\frac{1}{4}'' = \text{Scale}$

Edge sit on existing concrete

Pool