

Name: HIEN LE
Street Address: 7809 ANTILOPI ST.
City, State, Zip: ANNANDALE, VA 22003
Date: OCTOBER 22, 2014

Amendment, Permit # B14001789

Ms. Debbie Whalen
Division of Plan Review
Department of Inspections, Licenses and Permits
Howard County Government
3430 Court House Dr
Ellicott City, MD 21043

10/23/2014
10:00 AM

Dear Ms. Whalen:

I am requesting to amend Permit # B14001789 at
4507 TEN OAKS ROAD, DIXTON, MD 21036 to
TALKED TO MR. TOM FREY REGARDING THE SITE. MR. FREY ASKED TO
AMEND THE PERMIT FOR THE FOLLOWINGS:

- USE THE WALL CHECK PLAN TO REPLACE THE PLOT PLAN SINCE ECE DIST
IS MORE THAN 2.0'
- REVISE HEADER AT THE GARAGE DOOR TO MAKE IT ONE PIECE CON

Enclosed:

1 Fee: \$50.00
4 Plot Plans (WALL CHECK PLAN)
2 Sets of Construction Drawings (REVISED)
Other: _____

If there is anything we can do to assist you, please let me know.

Sincerely,

Name: HIEN LE
Title: PROJECT MANAGER
Phone: 703-635-6364
Email: hien.site-engineers@yahoo.com

GENERAL NOTES:

REVISED

Date: 10-23-14

Comments: Revised Plot Plan and header at garage door

1. Owner and Developer:

Christopher Esveld
14833 Silver Ash Court
Burtonsville, Maryland 20866
Home: 301-549-2223
Mobile: 240-426-0472

Site Location:




4507 Ten Oaks Road
Dayton, Maryland 21036

2. Boundary information shown hereon was taken from a boundary survey plat prepared and certified by D. Wayne Weller, State of Maryland Professional Land Surveyor on October 11, 2006 and approved by Howard County on October 20, 2006.

3. This plat does not represent a boundary survey of the property.


4. This plat is subject to restrictions of record and title report is not furnished.

I hereby certify that the locations of all existing improvements have been carefully established by a transit tape and unless otherwise shown, there are no visible encroachments.

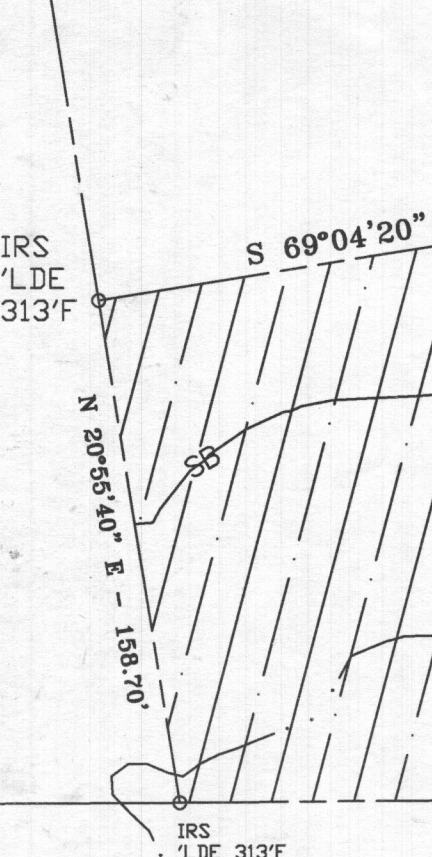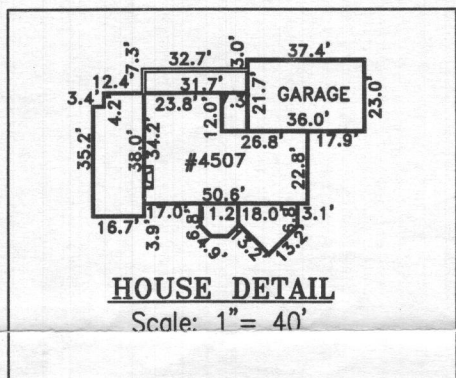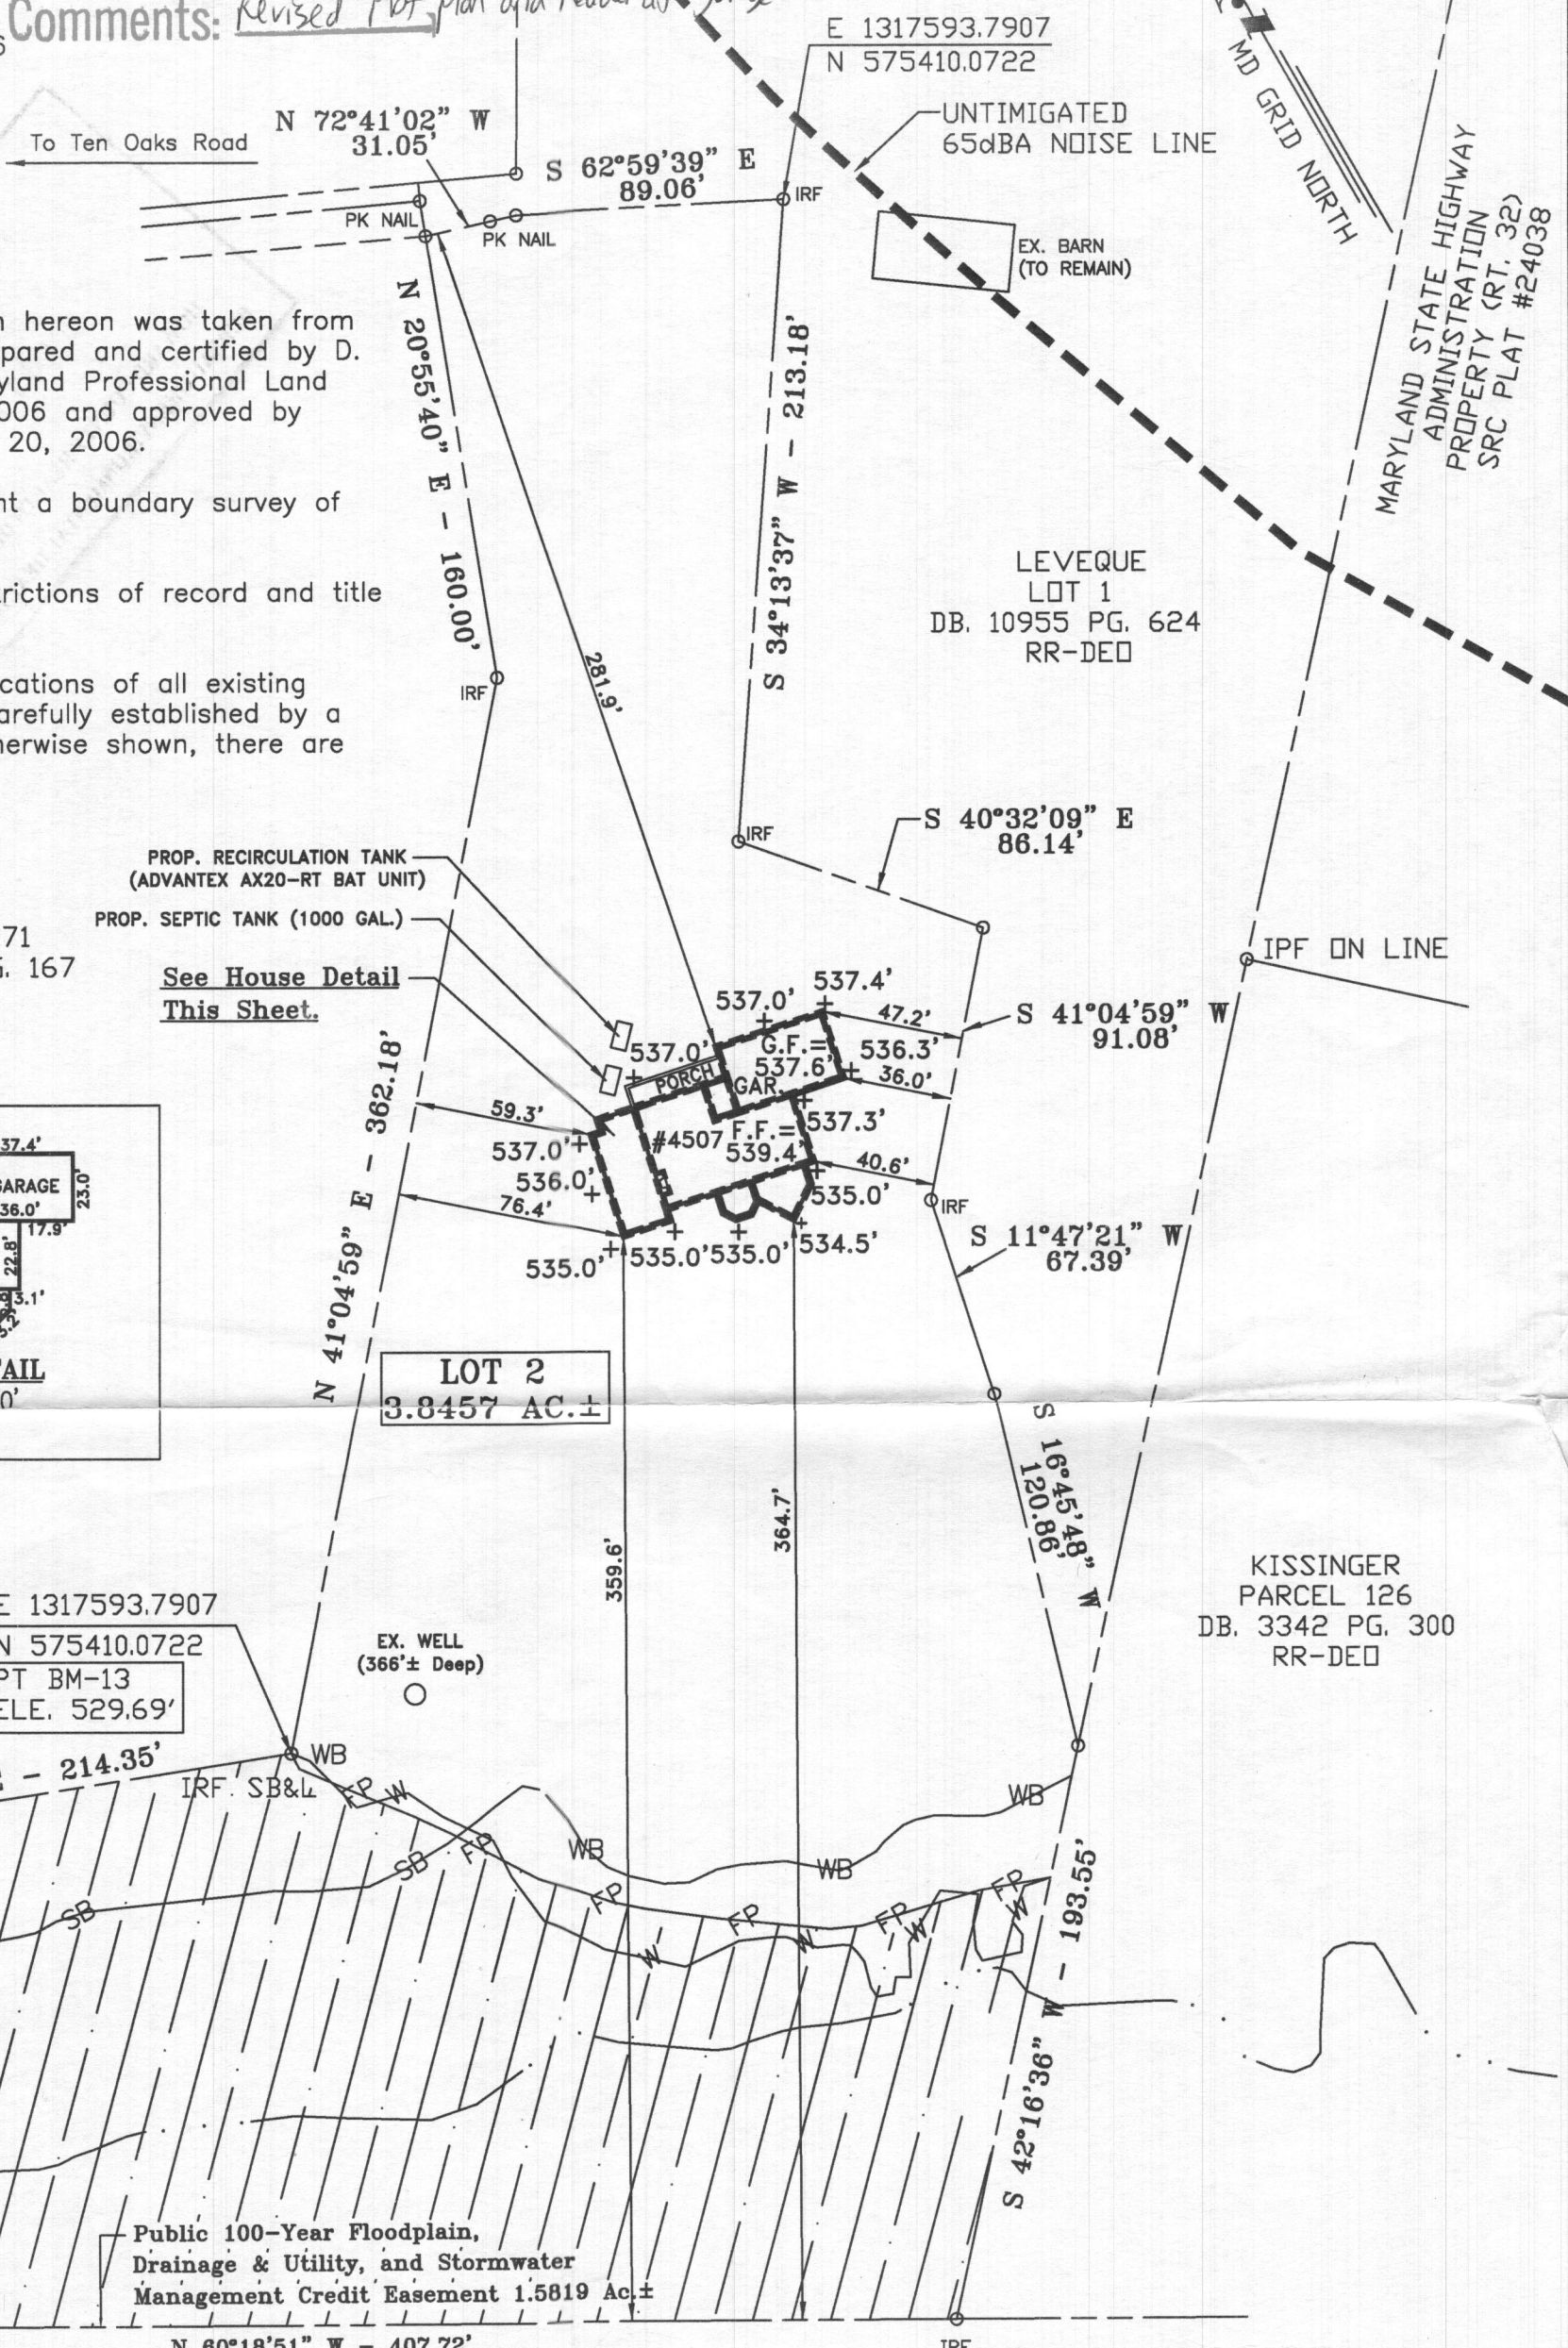

LEGEND

- WB — 25' WETLAND BUFFER
- SB — 75' STREAM BUFFER
- FP — 100 YEAR FLOODPLAIN
- W — WETLANDS
- Q — STREAM

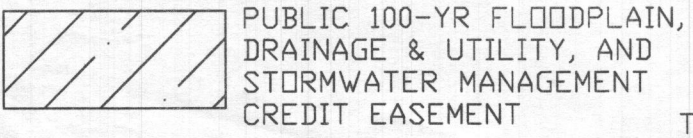

"Professional Certification. I hereby certify that these documents were prepared or approved by me, and that I am a duly licensed professional engineer under the laws of the State of Maryland, License No. 43556, Expiration Date: 7/01/16."

Signature: [Signature]

Date: 10/22/2014

Certification Plat
Showing Wall Check on
the Property Located at
4507 Ten Oaks Road
Dayton, MD 21036

Tax Map Number: 28-Grid 2-Parcel 243
5th Election District Howard County, Maryland
Scale: 1" = 60' Date: October 22, 2014

