

# APPLICATION

SEWAGE DISPOSAL TESTING

STATE OF MARYLAND - DEPARTMENT OF HEALTH AND MENTAL HYGIENE

HOWARD COUNTY HEALTH DEPARTMENT  
ENVIRONMENTAL HEALTH SERVICES  
P. O. BOX 476 ELLICOTT CITY, MARYLAND 21043  
TELEPHONE: 992-2330

A 33231

P \_\_\_\_\_

DISTRICT 5th

DATE Oct. 25, 1983

TO: THE COUNTY HEALTH OFFICER  
ELLICOTT CITY, MARYLAND

I, HEREBY, APPLY FOR THE NECESSARY TEST IN ORDER TO CONSTRUCT (OR RECONSTRUCT) A SEWAGE DISPOSAL SYSTEM.

PROPERTY OWNER Elizabeth P. Tharin

ADDRESS \_\_\_\_\_ PHONE \_\_\_\_\_

PROPERTY LOCATION:

SUBDIVISION HERITAGE WOODS LOT NO. 4-B

ROAD AND DESCRIPTION Brown Bridge Road near Rt 216

tax map 40, parcel 475

SIZE OF LOT \_\_\_\_\_ TYPE BLDG. \_\_\_\_\_ (NUMBER OF BEDROOMS)

THE SYSTEM INSTALLED UNDER THIS APPLICATION IS ACCEPTABLE ONLY UNTIL PUBLIC FACILITIES BECOME AVAILABLE. I FULLY UNDERSTAND THE FEE CONNECTED WITH THE FILING OF THIS PERC TEST APPLICATION IS NON-REFUNDABLE UNDER ANY CIRCUMSTANCES. I ALSO AGREE TO COMPLY

WITH ALL M.O.S.H.A. REQUIREMENTS IN TESTING THIS LOT. /s/ Don Reuwer/ Williams & Hanson  
(SIGNATURE OF APPLICANT)

APPROVED BY Raymond Hodges FOR Don Reuwer DATE: 12/13/83


REJECTED BY \_\_\_\_\_ FOR \_\_\_\_\_ DATE \_\_\_\_\_

HOLD PENDING FURTHER TESTS \_\_\_\_\_ DATE \_\_\_\_\_

REASONS FOR REJECTION OR HOLDING 11/9/83 Per OK Hold for Perc Test Plat BH  
12/13/83 Spec written BH  
P.L. # 64741

# THIS IS NOT A PERMIT

2044B

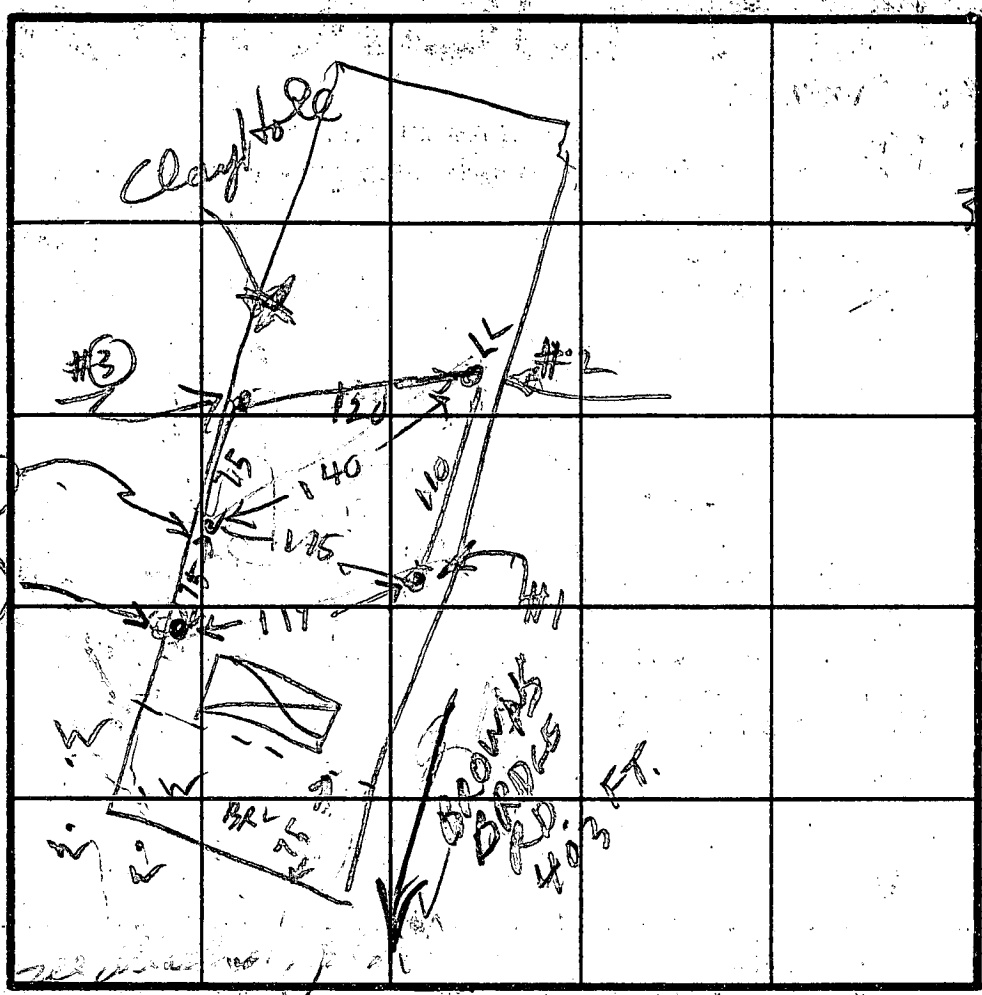

(4)  
BROWN CLAY

3 1/2  
BROWN GRAY SAND LOAM

13

(5)  
BROWN CLAY

4  
RED BROWN CLAY SAND

6  
GRAY BROWN SAND & FEW ROCKS

14

SOIL PROFILE

0  
BROWN CLAY

4  
GRAY BROWN SAND LOAM

7 1/2

(2)  
BROWN CLAY

3 1/2  
GRAY BROWN SAND LOAM

(3)  
BROWN CLAY

BROWN CLAY LOAM

GRAY BROWN SAND LOAM

DATE	TEST NO.	DEPTH	PRE-WET		TEST - 1" DROP		TIME
			START	STOP	START	STOP	
11/4/82	1V	7 1/2	LOOKS	OK	SEE SOIL PROFILE		
	2V	12	LOOKS	OK	SEE SOIL PROFILE		
	* 3V	9 1/2	LOOKS	DOUBTFUL &	FAILED		
	* 4V	13	LOOKS	OK			
11/9/82	(35)	6	218	317	59mm	inter	FAIL
	4S	5	223	224	224	225	1
	1S	5 1/2	226	230	230	233	3
	2S	4 1/2	229	230	230	232	2
	5S	5 1/2	300	310	310	327	17
	5V	14	LOOKS	OK			

REMARKS  
 5V IS ON LINE HOLE ON SIDE LINE 4A & 4B  
 3V IS ON LINE HOLE ON SIDE LINE LOT 4A & 4B  
 4V " " " " " " " " " "

TYPE OF SOIL \_\_\_\_\_  
 TESTED BY R HODGES ALSO PRESENT P REWER OKETTERMAN