

12/17/84

approved 12/17/84  
Staged

# PERMIT

P 34670

A 23438

SEWAGE DISPOSAL SYSTEM  
MARYLAND STATE DEPARTMENT OF HEALTH\*

HOWARD COUNTY  
BUREAU OF ENVIRONMENTAL HEALTH  
461-9933

ELLICOTT CITY  
DISTRICT 3rd

DATE 12/17/84

INDEXED

Kenneth S. Abicht IS PERMITTED TO INSTALL  ALTER

ADDRESS CHAS. GREEN PHONE

1332 High Ridge Dr.  
SUBDIVISION Valley Anne Estates ROAD 10630 Browns Farm LOT 8

PROPERTY OWNER Kenneth & Phyllis A. Abicht

ADDRESS

IF GARBAGE GRINDER IS USED INCREASE SEPTIC TANK CAPACITY BY 50% AND ABSORPTION AREA BY 22%.

GARBAGE GRINDER? YES NO

SEPTIC TANK CAPACITY 1000 GALLONS NUMBER OF BEDROOMS 3

DRY WELL OR DRY WELL AND TRENCH - 120 sq. ft. per bedroom. Minimum Total square feet 360 sq. ft. absorbant area in dry well. Inlet 3 feet Below original grade. Bottom maximum depth 9 feet below original grade. Effective area begins at 3 feet below original grade.

NOTE: If trench is used to make absorbent area, run the trench on level ground and leave a 5 foot earth buffer between dry well and trench. No trench is to exceed 100 feet in length. Trench inlet to be same as dry well, with 6 feet of stone below distribution slope. LOCATION: Place the dry well 15 feet from the right side line and 50 feet from the front lot line as seen when facing the lot from Browns Farm Road.

PLANS APPROVED BY Frank Skinner DATE 12/17/84

COVER NO WORK UNTIL INSPECTED AND APPROVED.

NEITHER THE HOWARD COUNTY COUNCIL NOR THE HEALTH DEPARTMENT IS RESPONSIBLE FOR THE SUCCESSFUL OPERATION OF ANY SYSTEM.

NOTE: IF TRENCH IS USED CALL FOR INSPECTION BEFORE AND AFTER PLACING GRAVEL IN TRENCH.

NOTE: NO DRY WELL SHALL EXCEED 15 FOOT IN DIAMETER. NO ABSORPTION TRENCH TO EXCEED 100 FEET IN LENGTH.

NOTE: ALL PIPE FROM HOUSE TO SEPTIC TANK MUST BE CAST IRON OR SCHEDULE 40 PVC OR ABS.

PERMIT VOID AFTER THREE YEARS.


NOTE: INSTALL STAND PIPE ON SEPTIC TANK AND DRY WELL. STAND PIPES MUST BE 6 INCHES IN DIAMETER CAST IRON, CONCRETE OR TERRA COTTA, OR PVC OR ABS ACCEPTED. IF TDP OF SEPTIC TANK IS DEEPER THAN 3 FEET MANHOLE TO GRADE REQUIRED.

\*INSTALLER IS RESPONSIBLE FOR OBTAINING FINAL APROVAL ON THIS PERMIT

\*CALL 992-2330 FOR INSPECTION OF SEPTIC SYSTEMS.

EH - 2-1082

A 23438

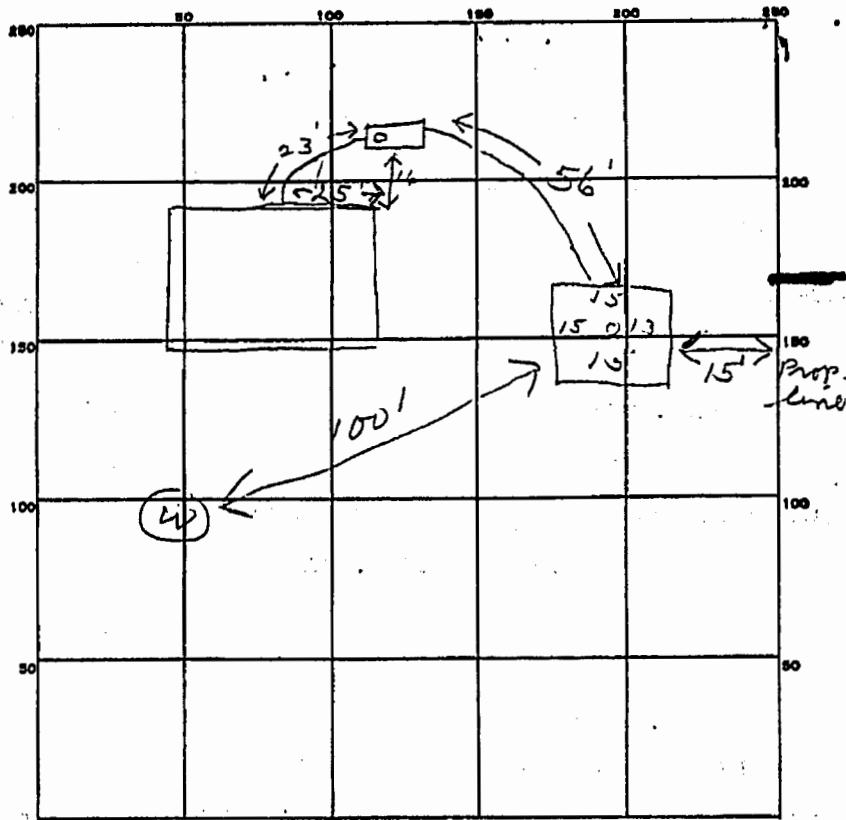

INDICATE NORTH. - NAME ADJOINING ROADWAY AS BASE LINE.

PERMIT CARD \_\_\_\_\_

SEPTIC TANK, LEVEL 1000 gal

CLEANOUTS ST | DW

DISTRIBUTION BOX, LEVEL \_\_\_\_\_

TILE FIELD, DEPTH \_\_\_\_\_ FT. TRENCH WIDTH \_\_\_\_\_ FT.

GRAVEL DEPTH \_\_\_\_\_ IN. TOTAL LENGTH \_\_\_\_\_ FT.

NUMBER OF TRENCHES \_\_\_\_\_ TOTAL BOTTOM AREA \_\_\_\_\_

SEEPAGE PITS, INSIDE DIAMETER 60 FT. DEPTH BELOW INLET 6 FT.

ABSORBENT AREA 360 SQ. FT.

REMARKS 12/17/84 OK to cover all work. JS

DATE SYSTEM APPROVED 12/17/84

INSPECTOR Stayed

4-13-1966  
16,000 ft.  
Preliminary

# APPLICATION

A 23438

P \_\_\_\_\_

SEWAGE DISPOSAL TESTING

STATE OF MARYLAND - DEPARTMENT OF HEALTH AND MENTAL HYGIENE

HOWARD COUNTY HEALTH DEPARTMENT  
ENVIRONMENTAL HEALTH SERVICES  
P. O. BOX 476, ELLICOTT CITY, MARYLAND 21043  
TELEPHONE: 465-5000, EXT. 356

DISTRICT 3

DATE 5/12/76

TO: THE COUNTY HEALTH OFFICER  
ELLICOTT CITY, MARYLAND

I, HEREBY, APPLY FOR THE NECESSARY TEST IN ORDER TO CONSTRUCT (OR RECONSTRUCT) A SEWAGE DISPOSAL SYSTEM.

Kenneth S. & Phyllis A. Abicht  
PROPERTY OWNER Richard Myrtoo & wife

ADDRESS 1795 Woodstock Rd Woodstock MD PHONE 328-2722

PROPERTY LOCATION: Valley Anne Estates  
SUBDIVISION MEADOW BROOK ACRES - Sect II LOT NO. 8

ROAD AND DESCRIPTION Road "A" SOUTH SIDE  
10630 Browns Farm Rd.

SIZE OF LOT 32000 TYPE BLDG. 3-4  
NUMBER OF BEDROOMS \_\_\_\_\_

IF NOT SINGLE RESIDENCE DESCRIBE \_\_\_\_\_

THE SYSTEM INSTALLED UNDER THIS APPLICATION IS ACCEPTABLE ONLY UNTIL PUBLIC FACILITIES BECOME AVAILABLE.

SIGNATURE OF APPLICANT Richard E. Myrtoo

APPROVED BY Paul J. O'Connell FOR Devi Trial DATE 11/22/74  
(KIND OF SYSTEM)

REJECTED BY \_\_\_\_\_ FOR \_\_\_\_\_ DATE \_\_\_\_\_  
(KIND OF SYSTEM)

HOLD PENDING FURTHER TESTS \_\_\_\_\_ DATE \_\_\_\_\_

REASONS FOR REJECTION OR HOLDING \_\_\_\_\_

B.P.# 60967  
Signed on 10/11/87  
For 36. R. S.F.D.

## THIS IS NOT A PERMIT

# APPLICATION

A 23438

## SEWAGE DISPOSAL TESTING

P. \_\_\_\_\_

STATE OF MARYLAND - DEPARTMENT OF HEALTH AND MENTAL HYGIENE

HOWARD COUNTY HEALTH DEPARTMENT  
ENVIRONMENTAL HEALTH SERVICES

DISTRICT 3

P. O. BOX 478, ELLICOTT CITY, MARYLAND 21043  
TELEPHONE: 465-5000, EXT. 356

DATE 5/12/76

TO: THE COUNTY HEALTH OFFICER  
ELLICOTT CITY, MARYLAND

I, HEREBY, APPLY FOR THE NECESSARY TEST IN ORDER TO CONSTRUCT (OR RECONSTRUCT) A SEWAGE DISPOSAL SYSTEM.

PROPERTY OWNER RICHARD MYRTUE & WIFE

ADDRESS 1795 Greenstack RD Greenstack MD PHONE 328-2722

PROPERTY LOCATION:

SUBDIVISION MEADOW BROOK ACRES S&T LOT NO. 8

ROAD AND DESCRIPTION ROAD "A" SOUTH SIDE

SIZE OF LOT 32000 TYPE BLDG. 3-4  
NUMBER OF BEDROOMS

IF NOT SINGLE RESIDENCE DESCRIBE \_\_\_\_\_

THE SYSTEM INSTALLED UNDER THIS APPLICATION IS ACCEPTABLE ONLY UNTIL PUBLIC FACILITIES BECOME AVAILABLE.

SIGNATURE OF APPLICANT Richard E. Myrtle

APPROVED BY \_\_\_\_\_ FOR \_\_\_\_\_ DATE \_\_\_\_\_  
(KIND OF SYSTEM)

REJECTED BY \_\_\_\_\_ FOR \_\_\_\_\_ DATE \_\_\_\_\_  
(KIND OF SYSTEM)


HOLD PENDING FURTHER TESTS \_\_\_\_\_ DATE \_\_\_\_\_

REASONS FOR REJECTION OR HOLDING \_\_\_\_\_

# THIS IS NOT A PERMIT

Lot 8

1+2  
 2 = elev  
 5 next  
 3 + 5 =  
 4 lowest

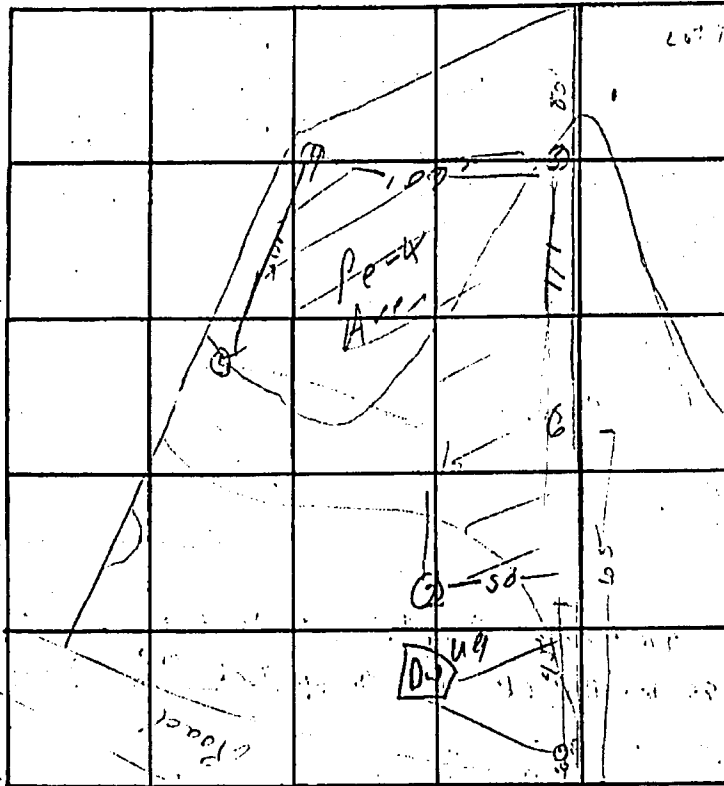

INDICATE NORTH. - NAME ADJOINING ROADWAY AS BASE LINE.

DATE	TEST NO.	DEPTH	PRE-WET		TEST - 1" DROP		TIME
			START	STOP	START	STOP	
7/18/46	1s	1:3'	9 <sup>53</sup>	10 <sup>00</sup>	10 <sup>00</sup>	10 <sup>06</sup>	6
	d	1:13'	9 <sup>54</sup>	9 <sup>59</sup>	9 <sup>54</sup>	10 <sup>04</sup>	5
	2s	3'	10 <sup>12</sup>	10 <sup>20</sup>	10 <sup>20</sup>	10 <sup>28</sup>	8
	d	12'	10 <sup>12<sup>20</sup></sup>	10 <sup>14</sup>	10 <sup>14</sup>	10 <sup>20</sup>	6
	3	5000 Soil 3-12 1/4'					
	4s	3'	10 <sup>20</sup>	10 <sup>22</sup>	10 <sup>22</sup>	10 <sup>27</sup>	5
	4d	12 1/4'	10 <sup>14</sup>	10 <sup>20</sup>	10 <sup>20</sup>	10 <sup>22<sup>13</sup></sup>	2:30
	5s	3'	10 <sup>02</sup>	10 <sup>04</sup>	10 <sup>04</sup>	10 <sup>07</sup>	3
	5d	12'	10 <sup>02</sup>	10 <sup>04</sup>	10 <sup>04</sup>	10 <sup>07</sup>	3

REMARKS \_\_\_\_\_

TYPE OF SOIL: \_\_\_\_\_

TESTED BY: APou ALSO PRESENT: \_\_\_\_\_