

05-375789 Approved
8-2-85
PERMIT SAHL

35623

P _____
A 33231

SEWAGE DISPOSAL SYSTEM

MARYLAND STATE DEPARTMENT OF HEALTH

HOWARD COUNTY
BUREAU OF ENVIRONMENTAL HEALTH
992-2330

INDEXED

ELLICOTT CITY
DISTRICT 5th.
DATE 6/7/85

{ I.C.O.P.
Time expired }

Arnold SEptic Tank Service IS PERMITTED TO INSTALL ALTER

ADDRESS Jacobs Road, Mt. Airy, Maryland 21771 PHONE 795-7873

SUBDIVISION Heritage Woods ROAD Brown Bridge Road LOT 4B

PROPERTY OWNER John Kopp

**BUILDING PERMIT SIGNED
AND RETURNED 11-12-02
800139237-DECK**

IF GARBAGE GRINDER IS USED INCREASE SEPTIC TANK CAPACITY BY 50% AND ABSORPTION AREA BY 22%.

GARBAGE GRINDER? YES _____ NO

SEPTIC TANK CAPACITY 1000 GALLONS NUMBER OF BEDROOMS 3

TRENCHES - 158 sq. ft. per bedroom. Trench to be 2 feet wide. Inlet 4 1/2 feet below original grade. Bottom maximum depth 11 feet below original grade. Effective area begins at 4 1/2 feet below original grade. 6 1/2 feet of stone below distribution pipe. LOCATION: Start the trench or place the dry well at a point 280 feet from the back lot line and 20 feet from the right lot line as seen when facing the lot from the back lot line. The back lot line is the 135.00 ft long lot line. Located over 800 feet from Brown Bridge Road. Run the trenches toward the back lot line. NOTE: No trench to exceed 100 feet in length. If more than one trench used, a distribution box is required. Call for inspection of trench(s) before and after gravel is installed. Provide 6" - 8" diameter cleanout and cap to grade or above on septic tank. 8-2-85

Pressure + well line installed at 42" below grade
Pressure tank installed with relief valve SAHL Approved

PLANS APPROVED BY Raymond Hodges 410 CREEK DATE 12/13/83

COVER NO WORK UNTIL INSPECTED AND APPROVED.

NEITHER THE HOWARD COUNTY COUNCIL NOR THE HEALTH DEPARTMENT IS RESPONSIBLE FOR THE SUCCESSFUL OPERATION OF ANY SYSTEM.

NOTE: IF TRENCH IS USED CALL FOR INSPECTION BEFORE AND AFTER PLACING GRAVEL IN TRENCH.

NOTE: NO DRY WELL SHALL EXCEED 15 FOOT IN DIAMETER. NO ABSORPTION TRENCH TO EXCEED 100 FEET IN LENGTH.

NOTE: ALL PIPE FROM HOUSE TO SEPTIC TANK MUST BE CAST IRON OR SCHEDULE 40 PVC OR ABS.

PERMIT VOID AFTER THREE YEARS.


NOTE: INSTALL STAND PIPE ON SEPTIC TANK AND DRY WELL. STAND PIPES MUST BE 6 INCHES IN DIAMETER. CAST IRON, CONCRETE OR TERRA COTTA, OR PVC OR ABS ACCEPTED. IF TOP OF SEPTIC TANK IS DEEPER THAN 3 FEET MANHOLE TO GRADE REQUIRED.

BLDG. PERMIT SIGNED
AND RETURNED 4/7/84
Serial # 69399
BLDG. PERMIT SIGNED
AND RETURNED 7/27/87

*INSTALLER IS RESPONSIBLE FOR OBTAINING FINAL APPROVAL ON THIS PERMIT

*CALL 992-2330 FOR INSPECTION OF SEPTIC SYSTEMS. 2/20/2003 800140389 DECK EH-2-1082

A 33231

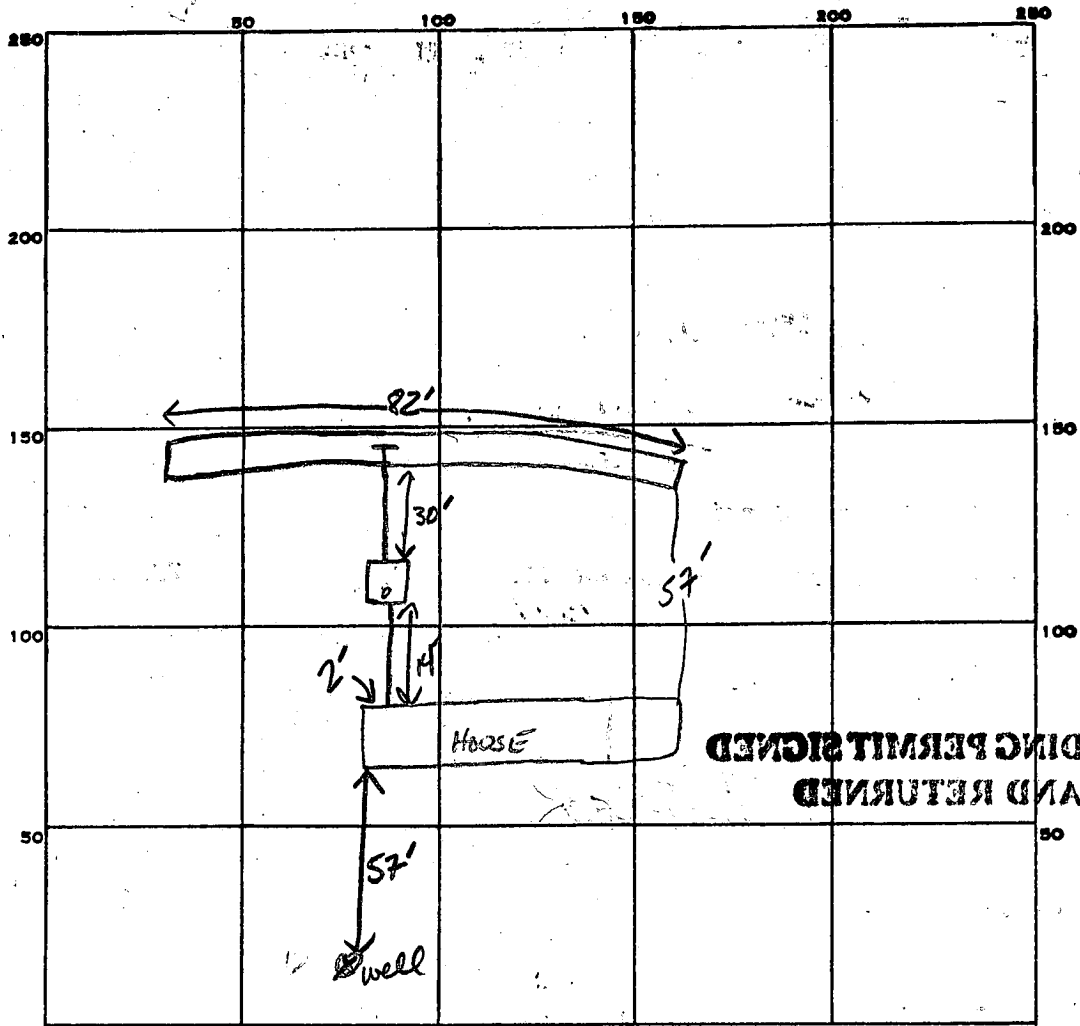

INDICATE NORTH. - NAME ADJOINING ROADWAY AS BASE LINE.

Brown Bridge Rd.

PERMIT CARD _____

SEPTIC TANK, LEVEL 1000 GAL CLEANOUTS

DISTRIBUTION BOX, LEVEL N/A T-INTO TRENCH

TILE FIELD, DEPTH 11 FT. TRENCH WIDTH 2 FT. INLET 4.5 FT

GRAVEL DEPTH 6.5 IN. TOTAL LENGTH 82 FT.

NUMBER OF TRENCHES 1 TOTAL BOTTOM AREA _____

SEEPAGE PITS, INSIDE DIAMETER _____ FT. DEPTH BELOW INLET _____ FT.

ABSORBENT AREA _____ SQ. FT.

REMARKS 8-2-85 OK TO ADD STONE TO TRENCH S. of well

DATE SYSTEM APPROVED 8-2-85 INSPECTOR SMU

