
 WATER WELL ABANDONMENT-SEALING REPORT FORM

SUBMIT COPIES OF COMPLETED FORM TO:

- * COUNTY ENVIRONMENTAL AGENCY (contact MDE, WMA if address needed)
- * WELL OWNER
- * MDE, WATER MANAGEMENT ADMINISTRATION, WELL PROGRAM

(OK) MB 9/27/2024

DATE WELL ABANDONED: 7-11-24 (month/day/year)

* PERMIT NUMBER OF ABANDONED WELL (if any)

HO - 94 - 3789

* PERMIT NUMBER OF REPLACEMENT WELL:


* PERSON ABANDONING WELL: Andrew Houseman WELL DRILLER'S LICENSE NUMBER: 224

CIRCLE: MWD / MSD / MGD

* OWNER'S NAME: Steve Keppler

SITE LOCATION MAP

* WELL LOCATION:
 COUNTY: Howard
 NEAREST TOWN: Ellicott City
 TAX MAP 17 BLOCK 24 PARCEL 618
 SUBDIVISION: _____
 SECTION: _____ LOT: _____
 STREET ADDRESS: 2938 Rogers Ave

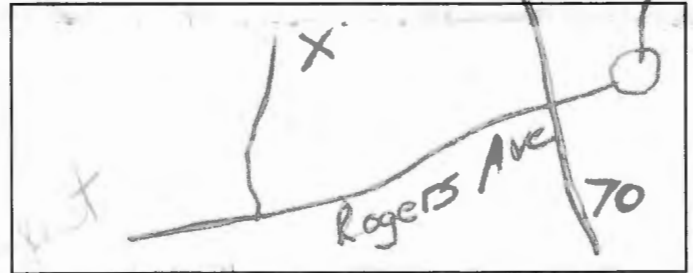

LATITUDE 39.290379

LONGITUDE 76.812892

LOG OF SEALING MATERIAL

MATERIAL	FEET	
	FROM	TO
Stone	328	95
Bentonite	95	0

* TYPE OF WELL BEING ABANDONED:

- DRILLED JETTED
- BORED HAND DUG
- OTHER (specify) _____

* USE CODE:

- DOMESTIC MUNICIPAL/PUBLIC
- IRRIGATION INDUSTRIAL
- TEST/OBSERVATION GEOTHERMAL

* TYPE OF CASING:

- STEEL PLASTIC
- CONCRETE OTHER (specify) _____

VOLUME OF MATERIAL USED

Stone 2.5 yds Bentonite 850/lb

SIZE OF CASING: 6 INCHES IN DIAMETER

DEPTH OF WELL: 328 FEET DEEP

WAS ANY CASING REMOVED? YES NO

If yes, length removed, in feet: 3

WAS CASING RIPPED OR PERFORATED? YES NO

SIGNATURE-MASTER WELL DRILLER OR SUPERVISING SANITARIAN LICENSE#

[Handwritten Signature]

#224 MWD / MSD / MGS
 CIRCLE ONE

7-12-24
 DATE

Pursuant to § 10-624 of the State Govt. Article of the Maryland Code, personal info requested on this form is used in processing this form pursuant to COMAR 26.04.04. Failure to provide the info may result in this form not being processed. You have the right to inspect, amend, or correct this form. The Maryland Department of the Environment is subject to the Maryland Public Information Act. This form may be made available on the Internet via MDE's website and is subject to inspection or copying, in whole or in part, by the public and other governmental agencies, if not protected by federal or State Law.