

OK ASD
 6/17/2024

 WATER WELL ABANDONMENT-SEALING REPORT FORM

SUBMIT COPIES OF COMPLETED FORM TO:

- * COUNTY ENVIRONMENT AGENCY (contact MDE, WMA if address needed)
- * WELL OWNER
- * MDE, WATER MANAGEMENT ADMINISTRATION, WELL PROGRAM

DATE WELL ABANDONED: 03-25-2024 (month/day/year)

* PERMIT NUMBER OF ABANDONED WELL (if any) N/A - -

* PERMIT NUMBER OF REPLACEMENT WELL N/A - -

* PERSON ABANDONING WELL: Jason S. Kwiatkowski


WELL DRILLERS LICENSE NUMBER: 174
 CIRCLE: MWD/MSD/MGD

* OWNER'S NAME: Alexandre Hernandez

* WELL LOCATION:
 COUNTY: Howard County
 NEAREST TOWN: Ellicott City
 TAX MAP 17 BLOCK 15 PARCEL 455
 SUBDIVISION: _____
 SECTION: _____ LOT: _____
 NEAREST ROAD: Old Frederick Rd (9745)

39-2868240
76-8503751

SITE LOCATION MAP

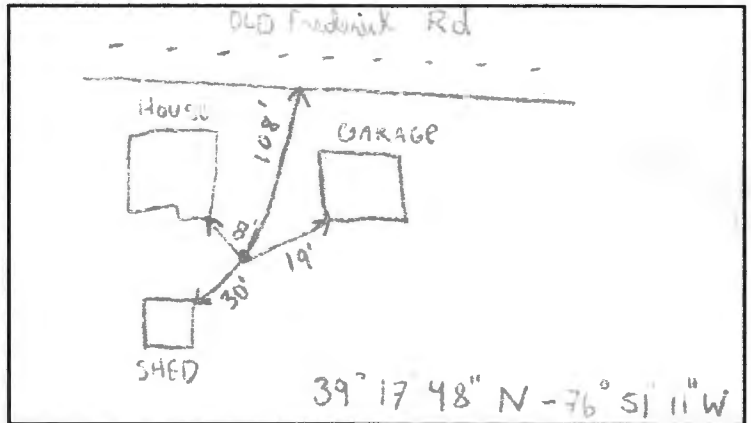

* TYPE OF WELL BEING ABANDONED:

- DRILLED JETTED
- BORED/AUGERED HAND DUG
- OTHER (specify) _____

* USE CODE:

- DOMESTIC MUNICIPAL/PUBLIC
- IRRIGATION INDUSTRIAL
- TEST/OBSERVATION GEOTHERMAL

* TYPE OF CASING:

- STEEL PLASTIC
- CONCRETE OTHER (specify) _____

* SIZE OF CASING: 6 INCHES IN DIAMETER

* DEPTH OF WELL: 60 FEET DEEP

* WAS ANY CASING REMOVED? YES NO
 if yes, length removed, in feet: _____

* WAS CASING RIPPED OR PERFORATED? YES NO

LOG OF SEALING MATERIAL

MATERIAL	FEET	
	FROM	TO
Bentonite	0	60
VOLUME OF MATERIAL USED		
500 lbs		

SIGNATURE-MASTER WELL DRILLER OR SUPERVISING SANITARIAN _____

LICENSE # 174

MWD/MSD/MGD
 CIRCLE ONE

DATE 03-25-21

