

\*\*\*\*\*  
WATER WELL ABANDONMENT-SEALING REPORT FORM  
\*\*\*\*\*

**SUBMIT COPIES OF COMPLETED FORM TO:**

- \* COUNTY ENVIRONMENTAL AGENCY (contact MDE, WMA if address needed)
- \* WELL OWNER
- \* MDE, WATER MANAGEMENT ADMINISTRATION, WELL PROGRAM

6/11/2023  
OK  
SP

DATE WELL ABANDONED: June 6, 2023 (month/day/year)

\* PERMIT NUMBER OF ABANDONED WELL (if any)

HO - 81 - 2022

\* PERMIT NUMBER OF REPLACEMENT WELL:

HO - 20 - 0246

\* PERSON ABANDONING WELL: FRANK SINGLETON


WELL DRILLER'S LICENSE NUMBER: WRO 046

CIRCLE: MWD / MSD / MGD

\* OWNER'S NAME: DAVID ROESLER

SITE LOCATION MAP

\* WELL LOCATION:  
COUNTY: Howard  
NEAREST TOWN: DAYTON  
TAX MAP \_\_\_\_\_ BLOCK \_\_\_\_\_ PARCEL \_\_\_\_\_  
SUBDIVISION: \_\_\_\_\_  
SECTION: \_\_\_\_\_ LOT: \_\_\_\_\_  
STREET ADDRESS: 4305 TEN OAKS RD

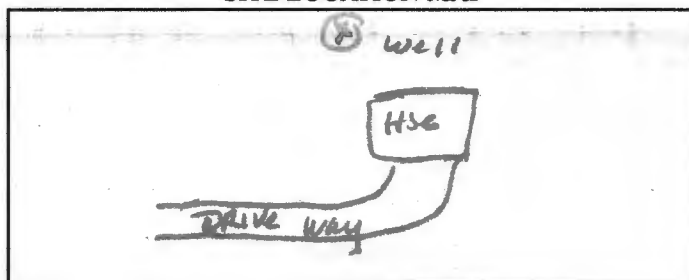

LATITUDE 39.252036

LONGITUDE 76.981623

LOG OF SEALING MATERIAL

\* TYPE OF WELL BEING ABANDONED:  
 DRILLED \_\_\_\_\_ JETTED \_\_\_\_\_  
 BORED \_\_\_\_\_ HAND DUG \_\_\_\_\_  
 OTHER (specify) \_\_\_\_\_

MATERIAL	FEET	
	FROM	TO
<u>Bentonite</u>	<u>324</u>	<u>1</u>
<u>TOP SOIL</u>	<u>1</u>	<u>0</u>

\* USE CODE:  
 DOMESTIC \_\_\_\_\_ MUNICIPAL/PUBLIC \_\_\_\_\_  
 IRRIGATION \_\_\_\_\_ INDUSTRIAL \_\_\_\_\_  
 TEST/OBSERVATION \_\_\_\_\_ GEOTHERMAL \_\_\_\_\_

VOLUME OF MATERIAL USED  
450 # Bentonite mixed for slurry

\* TYPE OF CASING:  
 STEEL \_\_\_\_\_ PLASTIC \_\_\_\_\_  
 CONCRETE \_\_\_\_\_ OTHER (specify) \_\_\_\_\_

SIZE OF CASING: 6 INCHES IN DIAMETER

DEPTH OF WELL: 324 FEET DEEP

WAS ANY CASING REMOVED?  YES  NO

If yes, length removed, in feet: 3

WAS CASING RIPPED OR PERFORATED?  YES  NO

SIGNATURE-MASTER WELL DRILLER OR SUPERVISING SANITARIAN George F. Rustenberg LICENSE# 040

CIRCLE ONE MWD / MSD / MGS

DATE 6-13-23

COUNTY

Pursuant to § 10-624 of the State Govt. Article of the Maryland Code, personal info requested on this form is used in processing this form pursuant to COMAR 26.04.04. Failure to provide the info may result in this form not being processed. You have the right to inspect, amend, or correct this form. The Maryland Department of the Environment is subject to the Maryland Public Information Act. This form may be made available on the Internet via MDE's website and is subject to inspection or copying, in whole or in part, by the public and other governmental agencies, if not protected by federal or State Law.