


SEPTIC DESIGN PLAN: 13499 TRIADELPHIA RD ELLICOTT CITY MD 21042

HOMEOWNER:
JAMES REEVES
ADDRESS: 13499 TRIADELPHIA RD
ELLICOTT CITY MD 21042
PHONE #: 410-446-6109
EMAIL: jim@reevesholdings.com

INSTALLER:
JET SEPTIC INC
CHARLES GARRETT III
ADDRESS: 440 BEAR BRANCH RD
WESTMINSTER MD 21157
PHONE #: 410-875-2311
EMAIL: jetseptic23@gmail.com

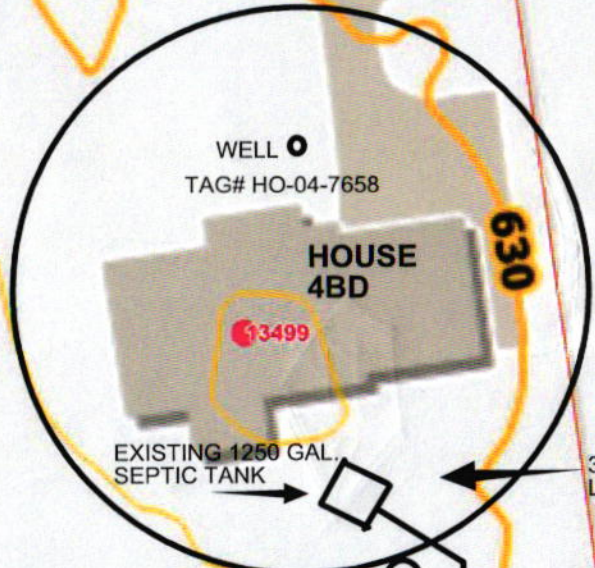

EXISTING DRYWELL TO BE
PUMPED, CRUSHED, &
FILLED

14FT FROM
PROPERTY
LINE

Approved Septic System Plan
Howard County Health Department


Signature

9/23/25

Date

Install completed on
9/19/25

TRENCH DETAIL:

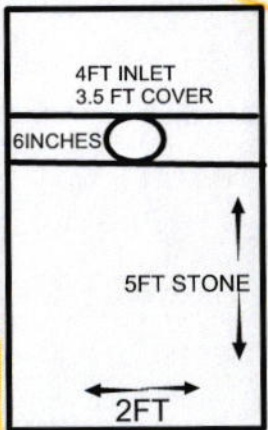

Revised plan
ok RR

75FT FROM
PROPERTY LINE
TO TRENCH END

68FT

68FT

9FT IN BETWEEN TRENCHES

30FT FROM BACK OF PROPERTY LINE TO TRENCH END

Signature _____ Date _____

Howard County Health Department
Approved before 2:00pm Nov

10/14/2014
10/14/2014

