

MB 11/19/25

**C 1** 81669 SEQUENCE NO. (MDE USE ONLY) **STATE OF MARYLAND WELL COMPLETION REPORT** THIS REPORT MUST BE SUBMITTED WITHIN 45 DAYS AFTER WELL IS COMPLETED.

(THIS NUMBER IS TO BE PUNCHED IN COLS. 3-6 ON ALL CARDS) FILL IN THIS FORM COMPLETELY PLEASE TYPE COUNTY NUMBER 13

ST/CO USE ONLY DATE Received MM 11 DD 13 YY 25 DATE WELL COMPLETED MM 10 DD 01 YY 25 Depth of Well 22 480 26 (TO NEAREST FOOT) PERMIT NO. FROM "PERMIT TO DRILL WELL" HO-25-0036

OWNER TRI STATE Home Services last name first name TOWN WOODSTOCK WELL SITE ADDRESS 10424 BIRCHWOOD C. SUBDIVISION SECTION LOT 28

**WELL LOG**  
Not required for driven wells

STATE THE KIND OF FORMATIONS PENETRATED, THEIR COLOR, DEPTH, THICKNESS AND IF WATER BEARING

DESCRIPTION (Use additional sheets if needed)	FEET		check if water bearing
	FROM	TO	
Topsoil	0	2	
Brown clay	2	10	
Brown Mica	10	30	
Grey Mica	30	190	
Brown Mica	190	191	5/
Grey Mica	191	480	

*Installed Loop-grouted and Backfilled*

**GROUTING RECORD**  
WELL HAS BEEN GROUTED (Circle Appropriate Box)  Y  N  
44 44

TYPE OF GROUTING MATERIAL (Circle one)  
CEMENT  CM BENTONITE CLAY  BC  
45 46 45 46

NO. OF BAGS 22 NO. OF POUNDS 1100  
GALLONS OF WATER 512  
DEPTH OF GROUT SEAL (to nearest foot) 480  
from 0 ft. to 480 ft.  
(enter 0 if from surface)

**CASING RECORD**  
casing types insert appropriate code below

ST STEEL  CO CONCRETE  
 PL PLASTIC  OT OTHER

MAIN CASING TYPE Nominal diameter top (main) casing (nearest inch)! Total depth of main casing (nearest foot)  
ST 6 40  
60 61 63 64 66 70

**OTHER CASING (if used)**  
EACH CASING diameter inch depth (feet) from to

**SCREEN RECORD**  
screen type or open hole (insert appropriate code below)

ST STEEL  BR BRASS  HO OPEN HOLE  
 PL PLASTIC  OT OTHER

NUMBER OF UNSUCCESSFUL WELLS: 0

WELL HYDROFRACTURED  Y  N

CIRCLE APPROPRIATE LETTER  
A A WELL WAS ABANDONED AND SEALED WHEN THIS WELL WAS COMPLETED  
E ELECTRIC LOG OBTAINED  
P TEST WELL CONVERTED TO PRODUCTION WELL

**C 2** DEPTH (nearest ft.)

1 110 40 480

EACH CASING SLOT SIZE 1 2 3 (NEAREST INCH)

DIAMETER OF SCREEN 56 60 from to

GRAVEL PACK IF WELL DRILLED WAS FLOWING WELL INSERT F IN BOX 68 68

MDE USE ONLY (NOT TO BE FILLED IN BY DRILLER) (E.R.O.S.) W Q

70 72 74 75 76

TELESCOPE CASING LOG INDICATOR OTHER DATA

**C 3** **PUMPING TEST**

HOURS PUMPED (nearest hour) 8 9

PUMPING RATE (gal. per min.) 11 15

METHOD USED TO MEASURE PUMPING RATE A

WATER LEVEL (distance from land surface)

BEFORE PUMPING 17 20 ft.

WHEN PUMPING 22 25 ft.

TYPE OF PUMP USED (for test)  
 A air  P piston  T turbine  
 C centrifugal  R rotary  O other (describe below)  
 J jet  S submersible

**PUMP INSTALLED**

DRILLER INSTALLED PUMP YES  NO

IF DRILLER INSTALLS PUMP, THIS SECTION MUST BE COMPLETED FOR ALL WELLS.

TYPE OF PUMP INSTALLED PLACE (A,C,J,P,R,S,T,O) IN BOX 29 29

CAPACITY: GALLONS PER MINUTE (to nearest gallon) 31 35

PUMP HORSE POWER 37 41

PUMP COLUMN LENGTH (nearest ft.) 43 47

CASING HEIGHT (circle appropriate box and enter casing height)  
 + above } LAND SURFACE (nearest foot)  
 - below } 50 51

LATITUDE 39.324283  
LONGITUDE 76.879946  
(DEFAULT COORD. WGS 84)

Pursuant to §10-624 of the State Govt. Article of the Maryland Code personal info. requested on this form is used in processing this form pursuant to COMAR 26.04.04. Failure to provide the info. may result in this form not being processed. You have the right to inspect, amend, or correct this form. The Maryland Department of the Environment is subject to the Maryland Public Information Act. This form may be made available on the Internet via MDE's website and is subject to inspection or copying, in whole or in part, by the public and other governmental agencies, if not protected by federal or state law.

02/11/19/25

<b>B 1</b>	88955 SEQUENCE NO. (MDE USE ONLY)	STATE OF MARYLAND APPLICATION FOR PERMIT TO DRILL WELL 589139 please type	STATE PERMIT NUMBER HO - 25 - 0036 fill in this form completely
------------	--------------------------------------	---	---

**OWNER INFORMATION**

Date Received (APA) 07/22/25

8 MM DD YY 13

15 Last Name TRI STATE Home Services Owner First Name 34

36 Street or RFD 82 A WORMANS MILL CT 55

57 Town FREDERICK md 70 State 72 Zip 21702 76

**B 3 LOCATION OF WELL**

8 COUNTY HOWARD 21

23 SUBDIVISION

SECTION 44 46 LOT 28 48 50

52 NEAREST TOWN WOODSTOCK 71

**DRILLER INFORMATION**

Driller's Name DARRON WILSON 76 License No. MWD 603 81

Firm Name EASTONAYS Well DRILLING

Address 9265 BR. CH RD MT AIRY 21771

Signature Darron Wilson Date 7/18/25

**B 4 SOURCES OF DRILLING WATER**

1. Wells

2.

3.

9/29/25 AM inspect Driller on site setting up with filter bag (MO)

9/29/25

11 STREET ADDRESS 1026 Braeze wood Circle 30

ON WHICH SIDE OF ROAD (CIRCLE APPROPRIATE BOX)

34 55 37 DISTANCE FROM ROAD ENTER FT OR MI 38 39

TAX MAP: \_\_\_\_\_ BLK: \_\_\_\_\_ PARCEL \_\_\_\_\_

**B 2 WELL INFORMATION**

APPROX. PUMPING RATE (GAL. PER MIN.) 0 8 12

AVERAGE DAILY QUANTITY NEEDED (GAL. PER DAY) 0 14 20

**USE FOR WATER (CIRCLE APPROPRIATE BOX)**

DOMESTIC POTABLE SUPPLY & RESIDENTIAL IRRIGATION

FARMING (LIVESTOCK WATERING & AGRICULTURAL IRRIGATION)

INDUSTRIAL, COMMERCIAL, DEWATERING

PUBLIC WATER SUPPLY WELL

TEST, OBSERVATION, MONITORING

OPEN LOOP GEOTHERMAL

CLOSED LOOP GEOTHERMAL

22

**NOT TO BE FILLED IN BY DRILLER HEALTH DEPARTMENT APPROVAL**

County Name HOWARD COUNTY NO. 13

STATE SIGNATURE \_\_\_\_\_ INSERT S → 41

DATE ISSUED 8/18/2025 8/18/2026

43 MM DD YY 48 CO SIGNATURE EXP. DATE

W.N.: 7/29/25 (MO) DOG: 10/7/25

APPROXIMATE DEPTH OF WELL 480 FEET

APPROXIMATE DIAMETER OF WELL 6 NEAREST INCH

**METHOD OF DRILLING (circle one)**

BORED (or Augered) JETTED Jetted & DRIVEN

30 AIR-ROTARY AIR-PERCussion ROTARY (Hydraulic Rotary)

37 CABLE REVERSE-ROTARY DRIVE-POINT

other \_\_\_\_\_

**REPLACEMENT OR DEEPEMED WELLS (CIRCLE APPROPRIATE BOX)**

THIS WELL WILL NOT REPLACE AN EXISTING WELL

THIS WELL WILL REPLACE A WELL THAT WILL BE ABANDONED AND SEALED

39  THIS WELL WILL REPLACE A WELL THAT WILL BE USED AS A STANDBY-CONTACT LOCAL APPROVING AUTHORITY FOR POLICY ON STANDBY WELLS

THIS WELL WILL DEEPEM AN EXISTING WELL


PERMIT NUMBER OF WELL TO BE REPLACED OR DEEPEMED (IF AVAILABLE) 41 \_\_\_\_\_ 52

**Not to be filled in by driller (MDE OR COUNTY USE ONLY)**

APPROP. PERMIT NUMBER \_\_\_\_\_ G \_\_\_\_\_

PERMIT No. HO - 25 - 0036


70 71 72 73 74 75 76 77 78 79

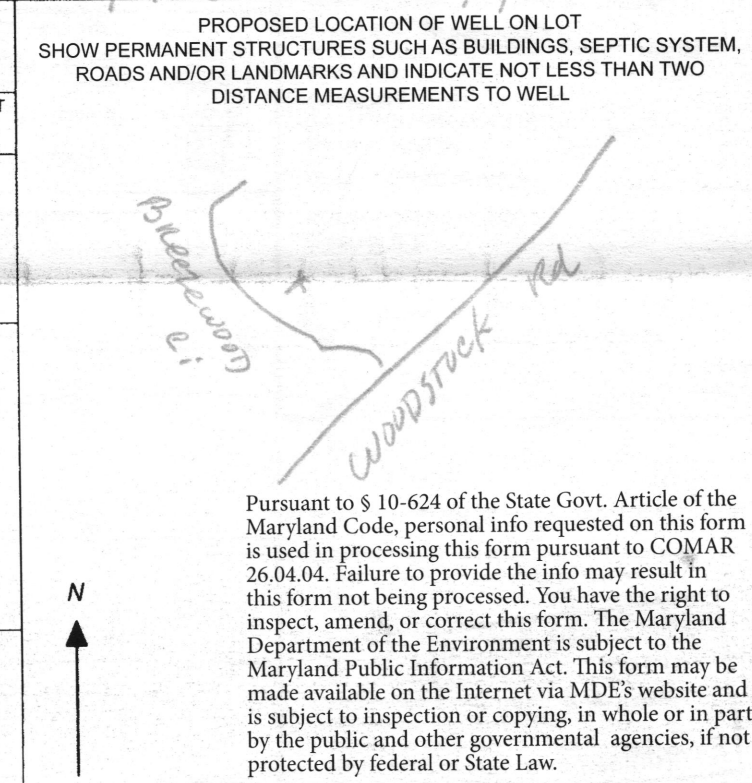

Pursuant to § 10-624 of the State Govt. Article of the Maryland Code, personal info requested on this form is used in processing this form pursuant to COMAR 26.04.04. Failure to provide the info may result in this form not being processed. You have the right to inspect, amend, or correct this form. The Maryland Department of the Environment is subject to the Maryland Public Information Act. This form may be made available on the Internet via MDE's website and is subject to inspection or copying, in whole or in part, by the public and other governmental agencies, if not protected by federal or State Law.

**SPECIAL CONDITIONS** Please notify office of Drilling & Grant

NOTE APPROVING AUTHORITIES SHOULD USE SEPARATE SHEET IF NEEDED

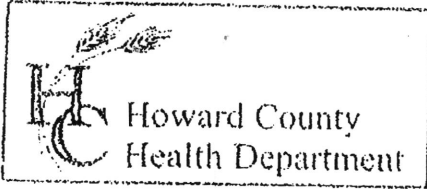

3525 H Ellicott Mills Drive, Ellicott City, MD 21043  
(410) 313-2640 Fax (410) 313-2648  
TDD (410) 313-2323 Toll Free 1-866-313-6300  
website: www.hchealth.org

Penny E. Borenstein, M.D., M.P.H., Health Officer

TO ALL INTERESTED PARTIES

When submitting a well permit application for a proposed well for new construction, please indicate one of the following:

- The well site has been staked by Driller  
(professional land surveyor or company employing professional land surveyors)  
on 7-11-25 (date) and does not require a site inspection.
- The well driller, builder or property owner will call the Health Department to schedule a time to meet in the field to verify the proposed well site location.

This sheet, along with two copies of an acceptable well site plan, must be attached to the green well permit application.


Revised 6/10/03

10626 Breerewood Ci  
Geo well  
Mayer Residence





www.exactaland.com | office: 443.819.3994

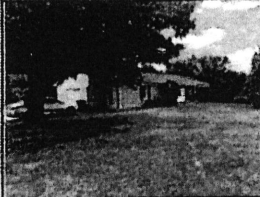

PROPERTY ADDRESS:  
10626 BREEZEWOOD CIRCLE, WOODSTOCK, MARYLAND 21163

SURVEY NUMBER: 2405.5624

DATE SIGNED: 06/03/24 FIELD WORK DATE: 6/3/2024

REVISION DATE(S):  
(REVO 6/3/2024)

POINTS OF INTEREST  
NONE VISIBLE



John E. Krobath  
State of Maryland Professional Land Surveyor  
License Number 10908 | Expires 5-26-2024

**SURVEYORS CERTIFICATE**  
THE INFORMATION SHOWN HEREON HAS BEEN BASED UPON THE RESULTS OF A FIELD INSPECTION PURSUANT TO THE DEED OR PLAT OF RECORD. THIS PLAT WAS PREPARED UNDER MY DIRECT SUPERVISION IN ACCORDANCE WITH C.O.M.A.R. SECTION 09.13.06.06 AS NOW ADOPTED BY THE MARYLAND BOARD FOR PROFESSIONAL LAND SURVEYORS AND IS OF BENEFIT TO A CONSUMER ONLY INsofar AS IT IS REQUIRED BY A LENDER OR A TITLE COMPANY IN CONNECTION WITH CONTEMPLATED TRANSFER, FINANCING OR REFINANCING THE PROPERTY DEPICTED HEREON.



Exacta Land Surveyors, LLC  
LB#21937  
office: 443.819.3994  
4424 Ventura Way, Apt L | Aberdeen, MD 2100




SEE PAGE 2 OF 2 FOR LEGAL DESCRIPTION  
PAGE 1 OF 2 - NOT VALID WITHOUT ALL PAGES

DO NOT REMOVE THIS TAG  
DEPARTMENT OF THE ENVIRONMENT  
WELL PERMIT NUMBER

HO-25-0036

INFORMATION GIVE NUMBER AND WRITE  
1300 WASHINGTON BLVD  
BALTIMORE MARYLAND 21230

PLEASE NOTE  
Per Maryland State Code, Sec. 09.13.06.06, this House Location Drawing is not to be relied upon to determine property boundaries or the establishment or location of existing or future improvements.

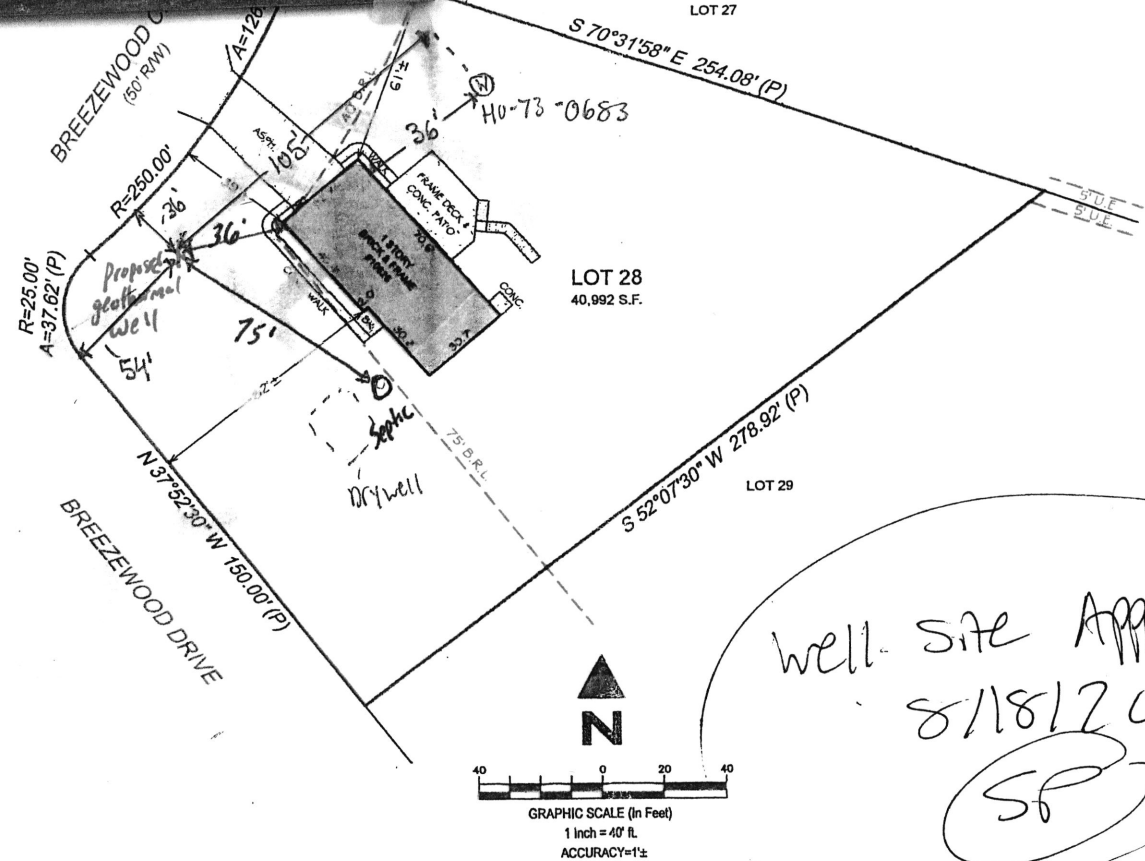

well site Approved  
8/18/2025  
SP

