

Maura J. Rossman, M.D., Health Officer

**APPLICATION  
FOR PERCOLATION TESTING AND SITE EVALUATION**

**PROPERTY LOCATION**

SUBDIVISION/PROPERTY NAME \_\_\_\_\_  
 PROPERTY ADDRESS 13755 Burntwoods Rd Glencol 21737  
STREET TOWN ZIP  
 TAX ACCOUNT # 03-297039 TAX MAP 0022 GRID 0007 PARCEL 0094 LOT NO. 1 PROPOSED LOT SIZE (ACRES) 4.27  
 ZONING CATEGORY \_\_\_\_\_ TIER \_\_\_\_\_

**PROPERTY OWNER(S)** Daniel Dwyer  
 DAYTIME PHONE (706)627-1403 CELL \_\_\_\_\_ EMAIL ddwyerandmore@icloud.com  
 MAILING ADDRESS 13755 Burntwoods Rd Glencol, MD 21737  
STREET CITY, STATE ZIP

**APPLICANT** Young Septic Services RELATIONSHIP TO OWNER: \_\_\_\_\_  
 DAYTIME PHONE (443)775-7353 CELL \_\_\_\_\_ EMAIL info@youngseptic.com  
 MAILING ADDRESS 1802 Baltimore Blvd Westminster MD 21157  
STREET CITY, STATE ZIP

**I HEREBY APPLY FOR THE NECESSARY TESTING/EVALUATION PRIOR TO ISSUANCE OF SEWAGE DISPOSAL SYSTEM PERMIT(S):**

**PROPERTY:**

- SUBDIVISION: NUMBER OF LOTS INCLUDING RESIDUE: \_\_\_\_\_  
SUBDIVISION CLASSIFICATION (PER DEPT. OF PLANNING AND ZONING)  MAJOR  MINOR
- CONSTRUCT NEW OSDS ON UNDEVELOPED LOT
- REPAIR OR REPLACE FAILING OSDS
- UPGRADE EXISTING OSDS

**BUILDING:**

- RESIDENTIAL WITH \_\_\_\_\_ EXISTING OR PROPOSED BEDROOMS IN THE COMPLETED STRUCTURE
- COMMERCIAL (PROVIDE DETAIL OF TYPE OF USE AND NUMBERS OF EMPLOYEES/CUSTOMERS ON ACCOMPANYING PLAN)

**IS THE PROPERTY WITHIN 2500 FEET OF ANY RESERVOIR?**

- YES
- NO

**AS APPLICANT, I UNDERSTAND THE FOLLOWING:**

- **THIS APPLICATION IS VALID FOR TWO(2) YEARS FROM DATE OF FEE PAYMENT AND APPROVAL IS BASED UPON HEALTH OFFICER SIGNATURE OF A PERC CERTIFICATION PLAN PRIOR TO EXPIRATION OF THIS PERMIT.**
- **THE APPLICATION FEE IS NON-REFUNDABLE**
- **THIS APPLICATION MUST BE ACCOMPANIED BY ALL APPLICABLE FEES AND A SUITABLE SITE PLAN IN ORDER TO BE PROCESSED**
- **THIS IS A PUBLIC DOCUMENT**

I declare and affirm that to the best of my knowledge, the information contained herein is correct. I declare that I am the owner of the property or duly authorized to make this application on behalf of the owner. I agree to comply with all applicable state and county regulations.  
 By signature of this application, I hereby grant Howard County Health Department officials the right to enter onto the property for the purpose of inspecting the property as directly related to the requested permit/service.

\_\_\_\_\_  
 SIGNATURE OF APPLICANT

10/17/2025  
 \_\_\_\_\_  
 DATE



13755 Burntwoods Rd.

Glenc 21737

Customer : Daniel Dwyer





plan prepared by: Irvin Black

Ext. Drywell



Ext. Septic Tank

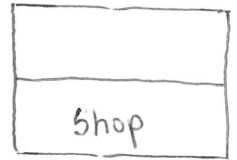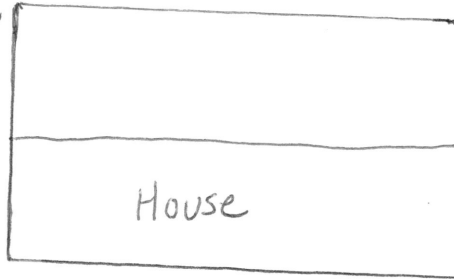

Driveway

well

Burntwoods Rd

no wells within 100'

13755 Burntwoods Road – Notes for perc repair

- 7/1/2025 site evaluation for perc test performed. Existing septic tank 1250gallon, with approximately 2 ft cover. The absorption system is a seepage pit, full to lid, no surface discharge present.
- Perc test performed just beyond fence, downhill of existing existing/seepage pit. 1.2 loading rate found. Was able to lay out 2 trenches just above existing perc test A.
- 7/3/2025 Installer called to explain homeowner wanted system to be sized for 6 bedrooms. Trench design spec's to remain the same, 2 ft wide, 8 ft bottom, effective area starting depth 4.5ft. For a 6 bedroom design, trenches will extend in length to 150 ft instead of 125 ft. Ok for installer to restake in field and submit on design plan for review and approval. -KMW