
 WATER WELL ABANDONMENT-SEALING REPORT FORM

SUBMIT COPIES OF COMPLETED FORM TO:

- * COUNTY ENVIRONMENT AGENCY (contact MDE, WMA if address needed)
- * WELL OWNER
- * MDE, WATER MANAGEMENT ADMINISTRATION, WELL PROGRAM

APPROVED
 10/16/2019

DATE WELL ABANDONED: 4/21/16 (month/day/year)

* PERMIT NUMBER OF ABANDONED WELL (if any) _____

* PERMIT NUMBER OF REPLACEMENT WELL _____

* PERSON ABANDONING WELL: Michael Bartow


WELL DRILLERS LICENSE NUMBER: 355

CIRCLE: MWD/MSD/MGD

* OWNER'S NAME: Jacob Wagner

SITE LOCATION MAP

* WELL LOCATION:
 COUNTY: Howard
 NEAREST TOWN: Glencolton
 TAX MAP 22 BLOCK 7 PARCEL 94
 SUBDIVISION: Sullivan Property
 SECTION: _____ LOT: 1
 NEAREST ROAD: 13755 Burntwoods RD

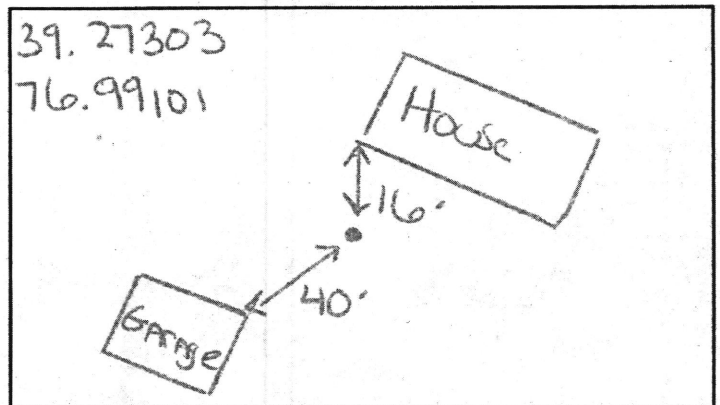

* TYPE OF WELL BEING ABANDONED:

_____ DRILLED _____ JETTED
 _____ BORED/AUGERED HAND DUG
 _____ OTHER (specify) _____

* USE CODE:

DOMESTIC _____ MUNICIPAL/PUBLIC
 _____ IRRIGATION _____ INDUSTRIAL
 _____ TEST/OBSERVATION _____ GEOTHERMAL

* TYPE OF CASING:

_____ STEEL _____ PLASTIC
 _____ CONCRETE OTHER (specify) stone

* SIZE OF CASING: 48 INCHES IN DIAMETER

* DEPTH OF WELL: 68 FEET DEEP

* WAS ANY CASING REMOVED? YES NO
 if yes, length removed, in feet: _____

* WAS CASING RIPPED OR PERFORATED? YES NO

LOG OF SEALING MATERIAL

MATERIAL	FEET	
	FROM	TO
Stone	68	5
Cement	5	2
SOIL	2	0
VOLUME OF MATERIAL USED		

SIGNATURE-MASTER WELL DRILLER OR SUPERVISING SANITARIAN _____

355

LICENSE #

MWD/MSD/MGD
 CIRCLE ONE

4/22/16
 DATE

Real Property Data Search (w1)

Search Result for HOWARD COUNTY

View Map		View GroundRent Redemption			View GroundRent Registration					
Tax Exempt: None		Special Tax Recapture: None								
Exempt Class: None										
Account Identifier:		District - 03 Account Number - 297039								
Owner Information										
Owner Name:		WAGNER JACOB L		Use: Principal Residence:		RESIDENTIAL YES				
Mailing Address:		13755 BURNTWOODS RD GLENELG MD 21737-9724		Deed Reference:		/14515/ 00059				
Location & Structure Information										
Premises Address:		13755 SW BURNTWOODS RD GLENELG 21737-0000		Legal Description:		LOT 1 4.271 A 13755 BURNTWOODS RD SULLIVAN SUBDIVISION				
Map:	Grid:	Parcel:	Neighborhood:	Subdivision:	Section:	Block:	Lot:	Assessment Year:	Plat No:	6864
0022	0007	0094	3020201.14	2001			1	2019	Plat Ref:	
Special Tax Areas: None				Town:		None				
				Ad Valorem:		100				
				Tax Class:		None				
Primary Structure Built		Above Grade Living Area		Finished Basement Area		Property Land Area		County Use		
1980		2,600 SF		470 SF		4.2700 AC				
Stories	Basement	Type	Exterior	Quality	Full/Half Bath	Garage	Last Notice of Major Improvements			
2	YES	STANDARD UNIT	SIDING/	4	2 full/ 1 half					
Value Information										
		Base Value		Value		Phase-in Assessments				
				As of		As of		As of		
				01/01/2019		07/01/2019		07/01/2020		
Land:		149,500		239,500						
Improvements		268,900		244,800						
Total:		418,400		484,300		440,367		462,333		
Preferential Land:		0						0		
Transfer Information										
Seller: WAGNER JACOB L			Date: 12/10/2012			Price: \$0				
Type: NON-ARMS LENGTH OTHER			Deed1: /14515/ 00059			Deed2:				
Seller: SULLIVAN HERBERT H			Date: 06/04/2009			Price: \$562,750				
Type: ARMS LENGTH IMPROVED			Deed1: /11787/ 00434			Deed2:				
Seller:			Date:			Price:				
Type:			Deed1:			Deed2:				
Exemption Information										
Partial Exempt Assessments:		Class		07/01/2019		07/01/2020				
County:		000		0.00						
State:		000		0.00						
Municipal:		000		0.00 0.00		0.00 0.00				
Tax Exempt: None		Special Tax Recapture: None								
Exempt Class: None										
Homestead Application Information										
Homestead Application Status: Approved 06/22/2017										

Homeowners' Tax Credit Application Status: No Application

Date:

1. This screen allows you to search the Real Property database and display property records.
2. Click **here** for a glossary of terms.
3. Deleted accounts can only be selected by Property Account Identifier.
4. The following pages are for information purpose only. The data is not to be used for legal reports or documents. While we have confidence in the accuracy of these records, the Department makes no warranties, expressed or implied, regarding the information.