

APPLICATION

SEWAGE DISPOSAL TESTING

A 33226

STATE OF MARYLAND - DEPARTMENT OF HEALTH AND MENTAL HYGIENE

P _____

HOWARD COUNTY HEALTH DEPARTMENT
ENVIRONMENTAL HEALTH SERVICES

P. O. BOX 476 ELLICOTT CITY, MARYLAND 21043
TELEPHONE: 992-2330

DISTRICT 5th

DATE Oct. 14, 1983

TO: THE COUNTY HEALTH OFFICER
ELLICOTT CITY, MARYLAND

I, HEREBY, APPLY FOR THE NECESSARY TEST IN ORDER TO CONSTRUCT (OR RECONSTRUCT) A SEWAGE DISPOSAL SYSTEM.

PROPERTY OWNER Elizabeth P. Tharin

ADDRESS _____ PHONE _____

PROPERTY LOCATION:

SUBDIVISION _____ LOT NO. 1-D

ROAD AND DESCRIPTION Brown Bridge Road

SIZE OF LOT _____ TYPE BLDG. _____
(NUMBER OF BEDROOMS)

THE SYSTEM INSTALLED UNDER THIS APPLICATION IS ACCEPTABLE ONLY UNTIL PUBLIC FACILITIES BECOME AVAILABLE. I FULLY UNDERSTAND THE FEE CONNECTED WITH THE FILING OF THIS PERC TEST APPLICATION IS NON-REFUNDABLE UNDER ANY CIRCUMSTANCES. I ALSO AGREE TO COMPLY WITH ALL M.O.S.H.A. REQUIREMENTS IN TESTING THIS LOT. /s/ Don Reuver/ Williams G. Hanson, Escrow Account
(SIGNATURE OF APPLICANT)

APPROVED BY _____ FOR _____ DATE _____


REJECTED BY _____ FOR _____ DATE _____

HOLD PENDING FURTHER TESTS _____ DATE _____


REASONS FOR REJECTION OR HOLDING _____

THIS IS NOT A PERMIT

17

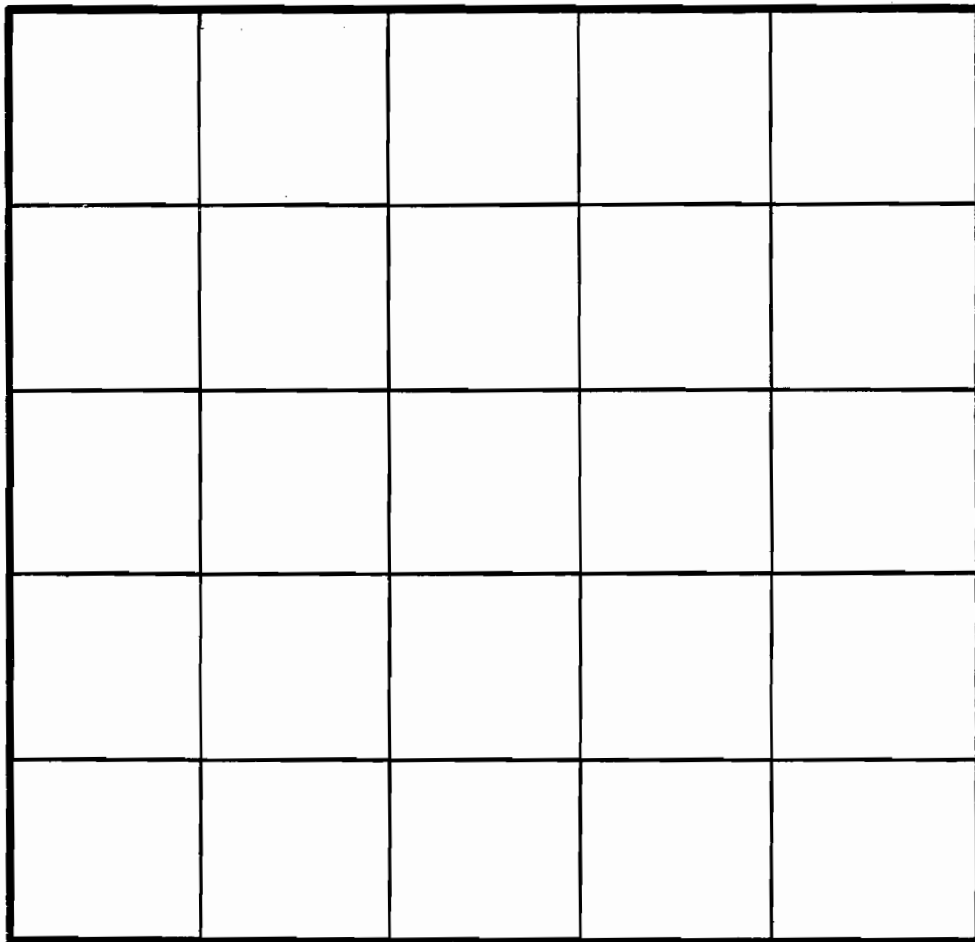

SOIL PROFILE

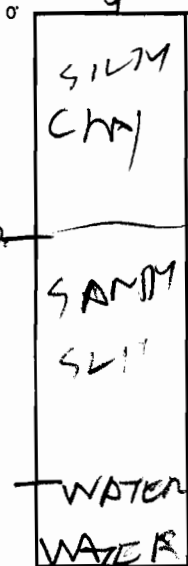


(3)

INDICATE NORTH - NAME ADJOINING ROADWAY AS BASE LINE.



(3)

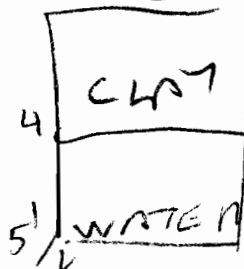

DATE	TEST NO.	DEPTH	PRE-WET		TEST - 1" DROP		TIME
			START	STOP	START	STOP	
7/20/47	1	11 1/2	WATER		11 F		
	2	11 1/2	WATER		11 F		
	3	7 1/2	WATER		7 1/2 F		
7/20/47	4	5 1/2	WATER		5 1/2 F		

REMARKS WATER ON HIGH PART OF LOT
NOT TESTED

TYPE OF SOIL _____

TESTED BY P. J. [Signature]

ALSO PRESENT

[Signature]
[Signature]

HOWARD COUNTY HEALTH DEPARTMENT

JOYCE M. BOYD, M.D., M.P.H.
COUNTY HEALTH OFFICER



Bureau of Environmental Health
3525 Ellicott Mills Drive
Ellicott City, Maryland 21043

Director - 461-9956
Water & Sewerage, Permits - 461-9933
Community Environmental Health - 461-9944
Technical Services - 461-9955

July 7, 1987

Mr. Robert A. Williams
8386 Court Avenue
Ellicott City, Maryland 21043

RE: Percolation Testing
Elizabeth Tharin Property
Lot 1 - Heritage Woods
Brown Bridge Road

Dear Mr. Williams:

This is to advise that percolation testing conducted February 20, 1987 on the above referenced property was unsuccessful due to a high water table and excessively slow percolation times in the soils that were sufficiently elevated to be tested. Accordingly this property continues to be considered non-buildable under standards for conventional septic systems.

Likewise, the excessively slow percolation times suggest this lot has little prospect for approval under current standards for non-conventional septic systems. It is not at this point clear how this property would fare if evaluated under various alternative non-conventional standards currently being evaluated by the Department of Residential Sanitation.

This is not to be taken as a suggestion that the property would qualify under revised standards currently under review. If you would like to submit the property for re-consideration once the revised standards are in place, it is suggested that you contact this department around the first of the year to arrange for re-evaluation during the Spring Wet Season.

If you have any questions regarding this matter, please contact me at 461-9933. If you find yourself aggrieved by the decision about this property, formal avenues of appeal are available once you have had the opportunity for an informal review from this agency.

Respectfully,

A handwritten signature in cursive script that reads "Craig Williams".

Craig Williams, Director
Water and Sewerage Program

OW:JR

HOWARD COUNTY HEALTH DEPARTMENT

JOYCE M. BOYD, M.D., M.P.H.
COUNTY HEALTH OFFICER



Bureau of Environmental Health
3525 Ellicott Mills Drive
Ellicott City, Maryland 21043

Director - 461-9956
Water & Sewerage, Permits - 461-9933
Community Environmental Health - 461-9944
Technical Services - 461-9955

September 14, 1987

Mr. Robert A. Williams
8386 Court Avenue
Ellicott City, Maryland 21043

RE: Percolation testing
Lots 1A, 1B, 1C, 1D
Lots 2A, 2B, 2C, 2D
Heritage Woods

Dear Mr. Williams:

In response to your recent request, the following is offered as a clarification of a letter to you dated July 7, 1987. That letter advised of unsuccessful percolation tests in Heritage Woods on certain lots owned by Elizabeth Tharin.

- (1) Percolation test results were so unsatisfactory on the individual lots (1A, 1B, 1C, 1D, 2A, 2B, 2C, 2D) that development of any single lot on a septic system is inconceivable.
- (2) Approval as a larger combined building site under standards for non-conventional is uncertain. Revisions in standards for existing recorded lots leaves open the possibility (but not the probability) for approval as a larger lot.

Applicant is advised to contact this office shortly after the first of the year if re-evaluation under non-conventional standards is requested. Testing would have to occur in the spring wet season with prospects for approval somewhat limited.

If you have any further questions regarding the above matter, please feel free to contact me at 461-9933.

Very truly yours,

A handwritten signature in cursive script that reads "Craig Williams".

Craig Williams, Director
Water and Sewerage Program

CW:hs

Fulter

Brow

7297


Browbridge



B.B

Heximewood

Highland

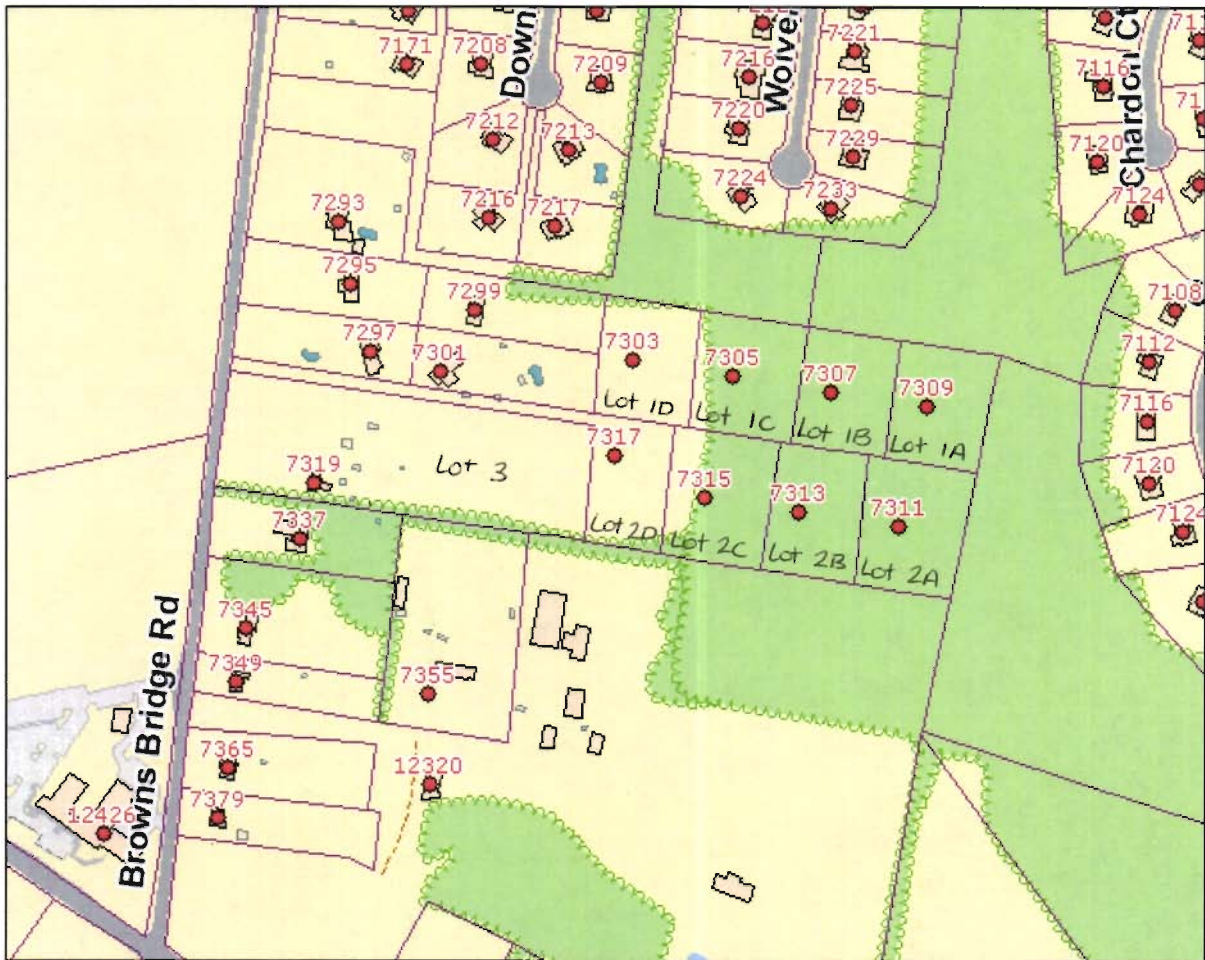

Printed 8/19/08